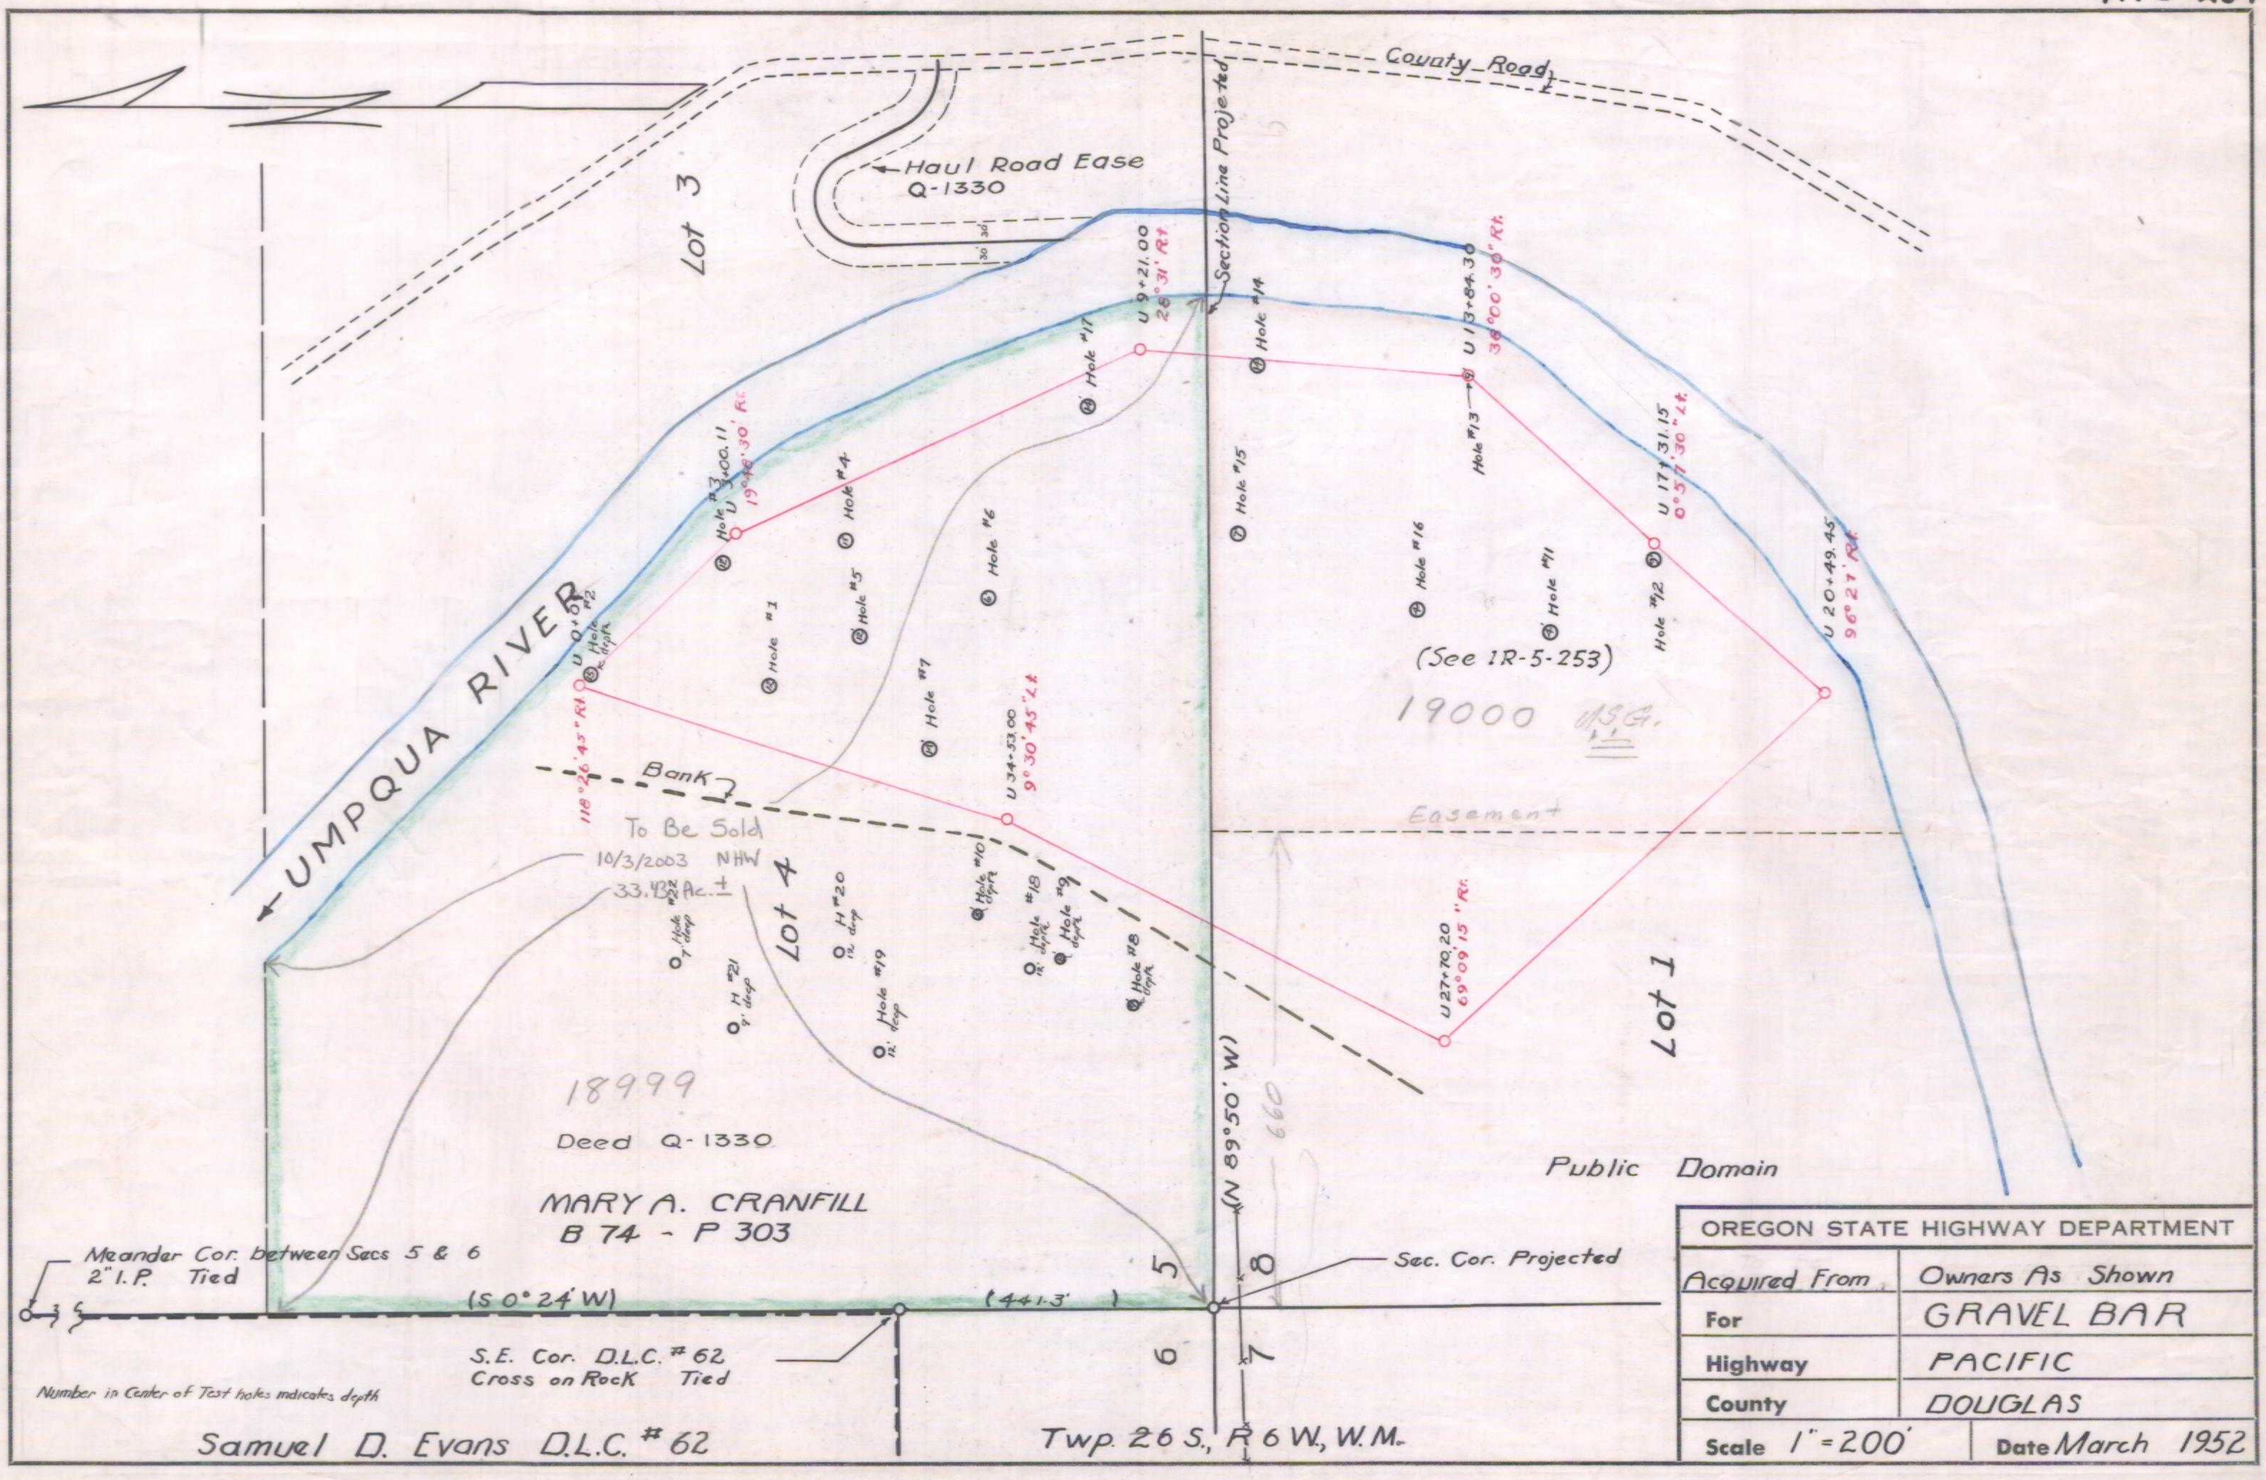

OREGON STATE HIGHWAY DEPARTMENT	
Acquired From	Owners As Shown
For	GRAVEL BAR
Highway	PACIFIC
County	DOUGLAS
Scale 1" = 200'	Date March 1952

LEWIS-BRIGHT TRACING CLOTH E. D. CO. KILHAM STATY. CO. NO. 131K