


T. 23 S. R. 5 W.

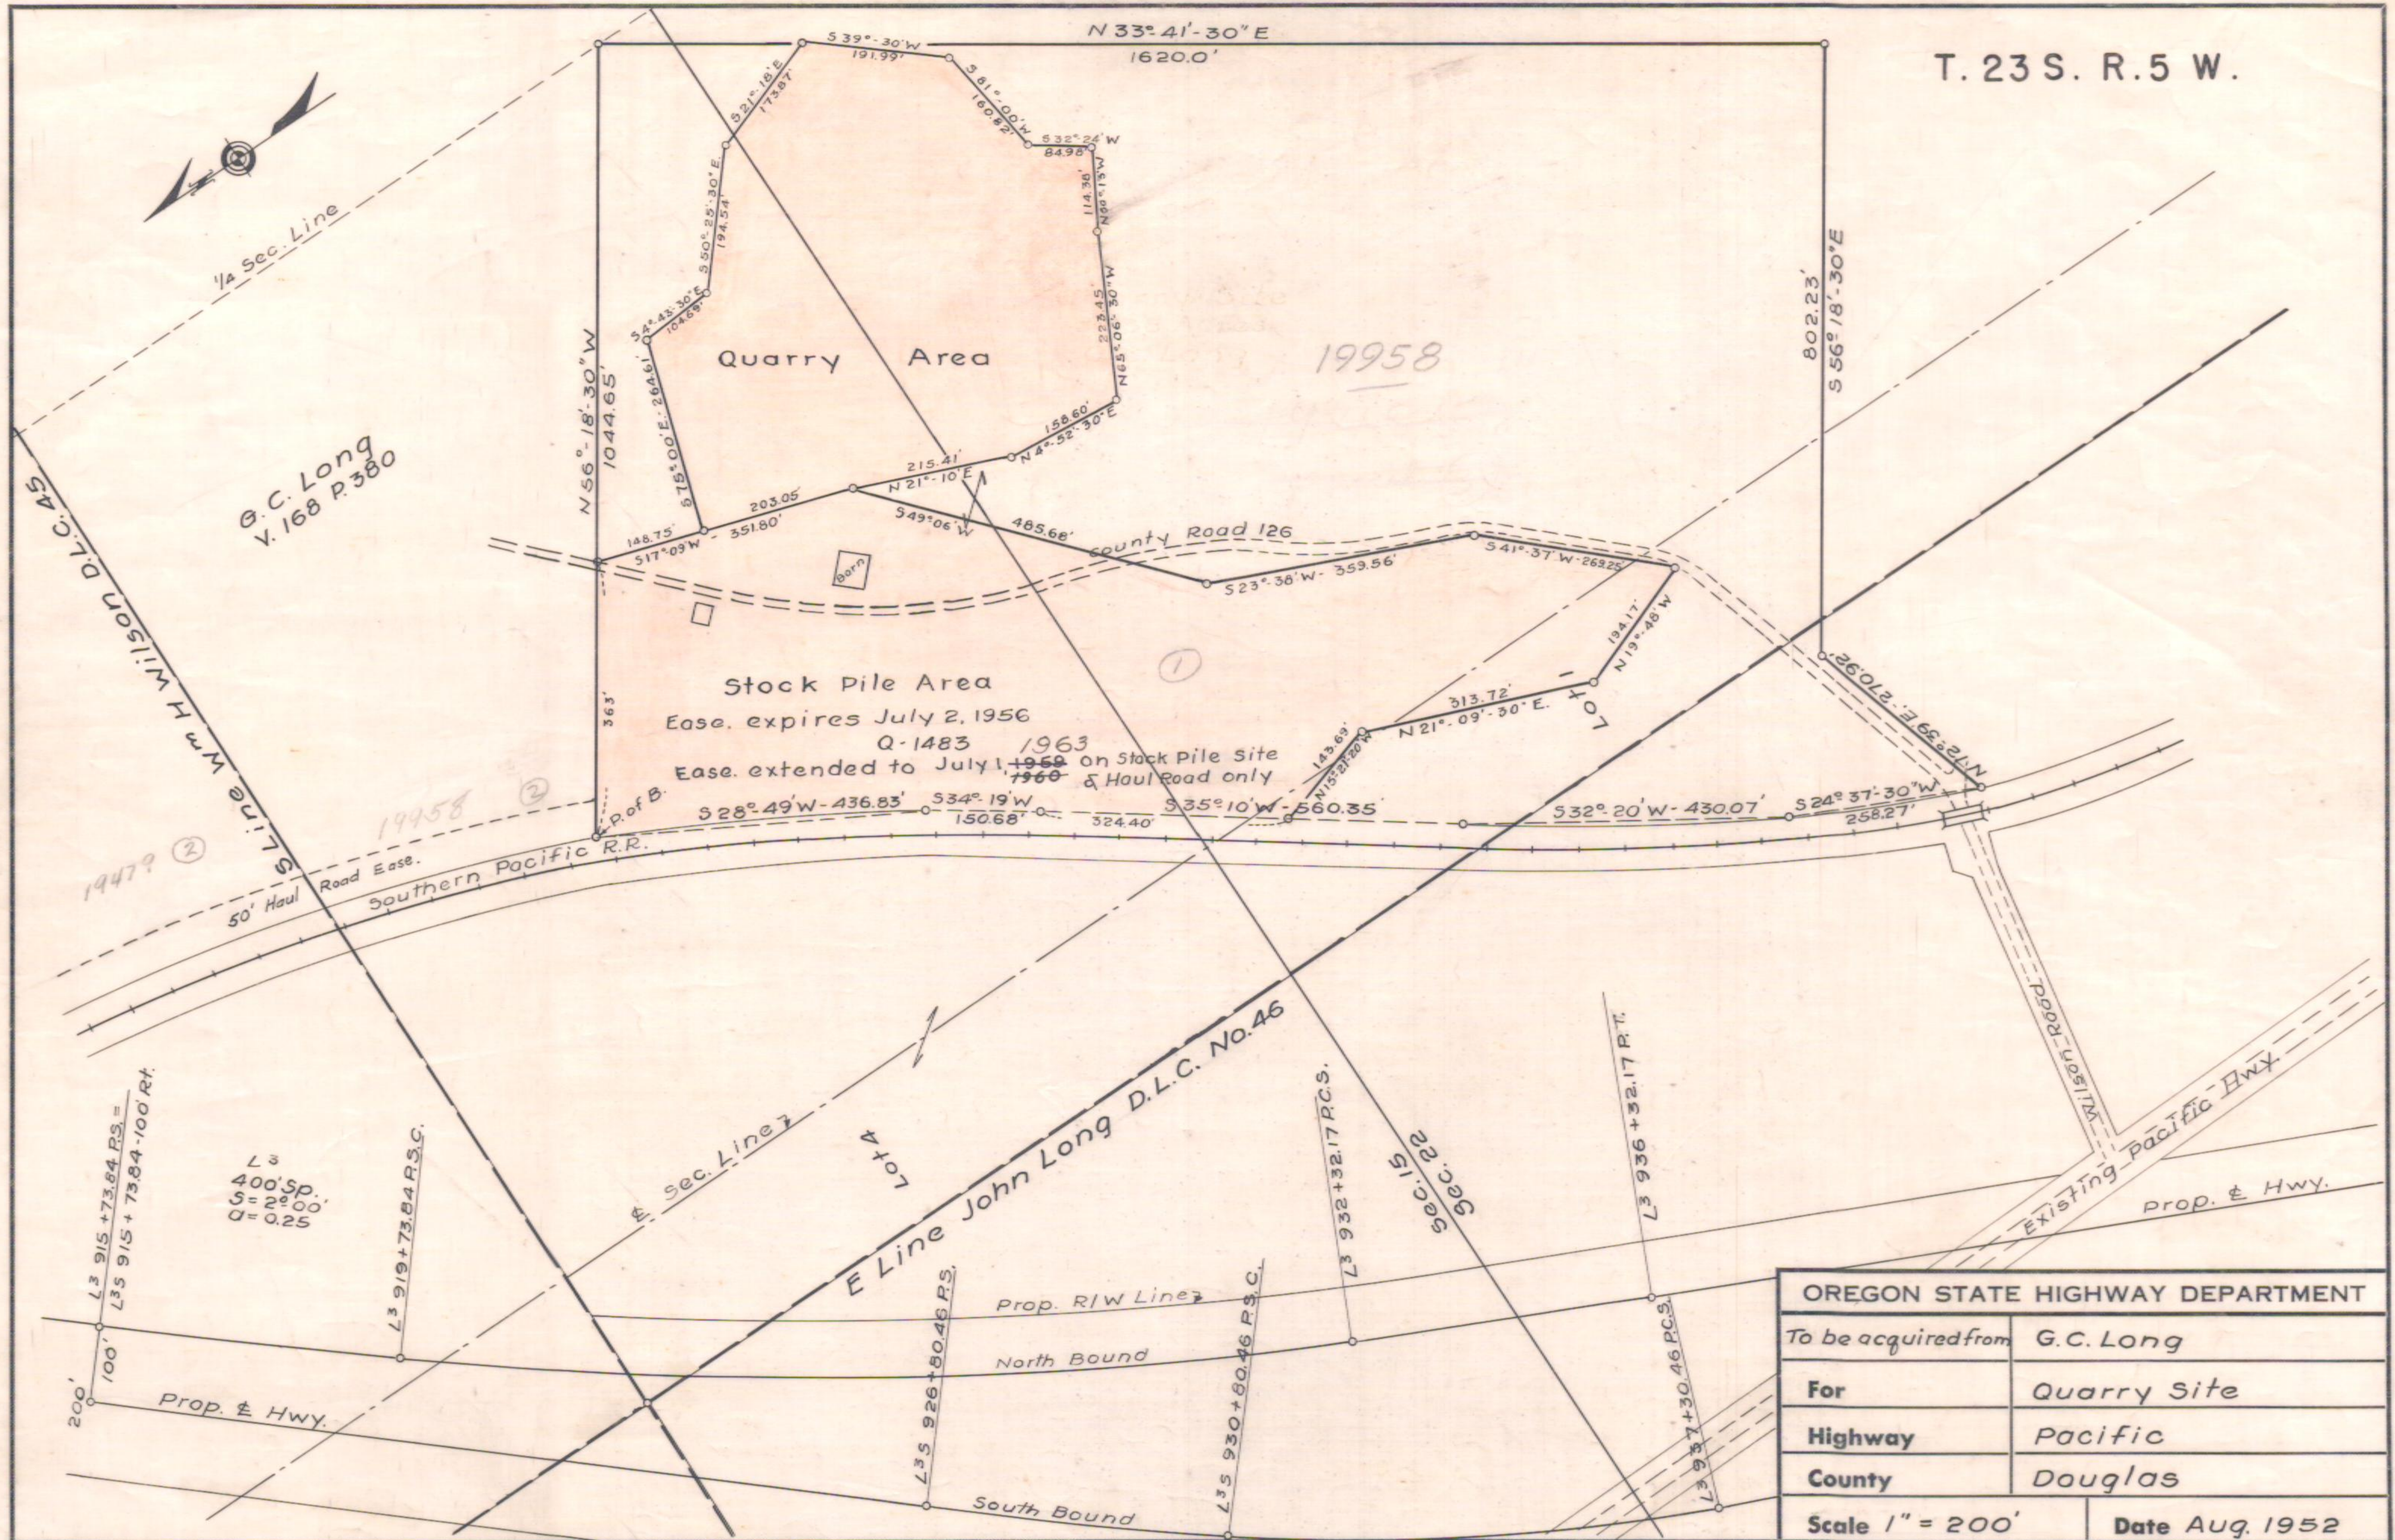

OREGON STATE HIGHWAY DEPARTMENT	
To be acquired from	G.C. Long
For	Quarry Site
Highway	Pacific
County	Douglas
Scale 1" = 200'	Date Aug. 1952