


T. 21 S. R. 12 W. W. M.

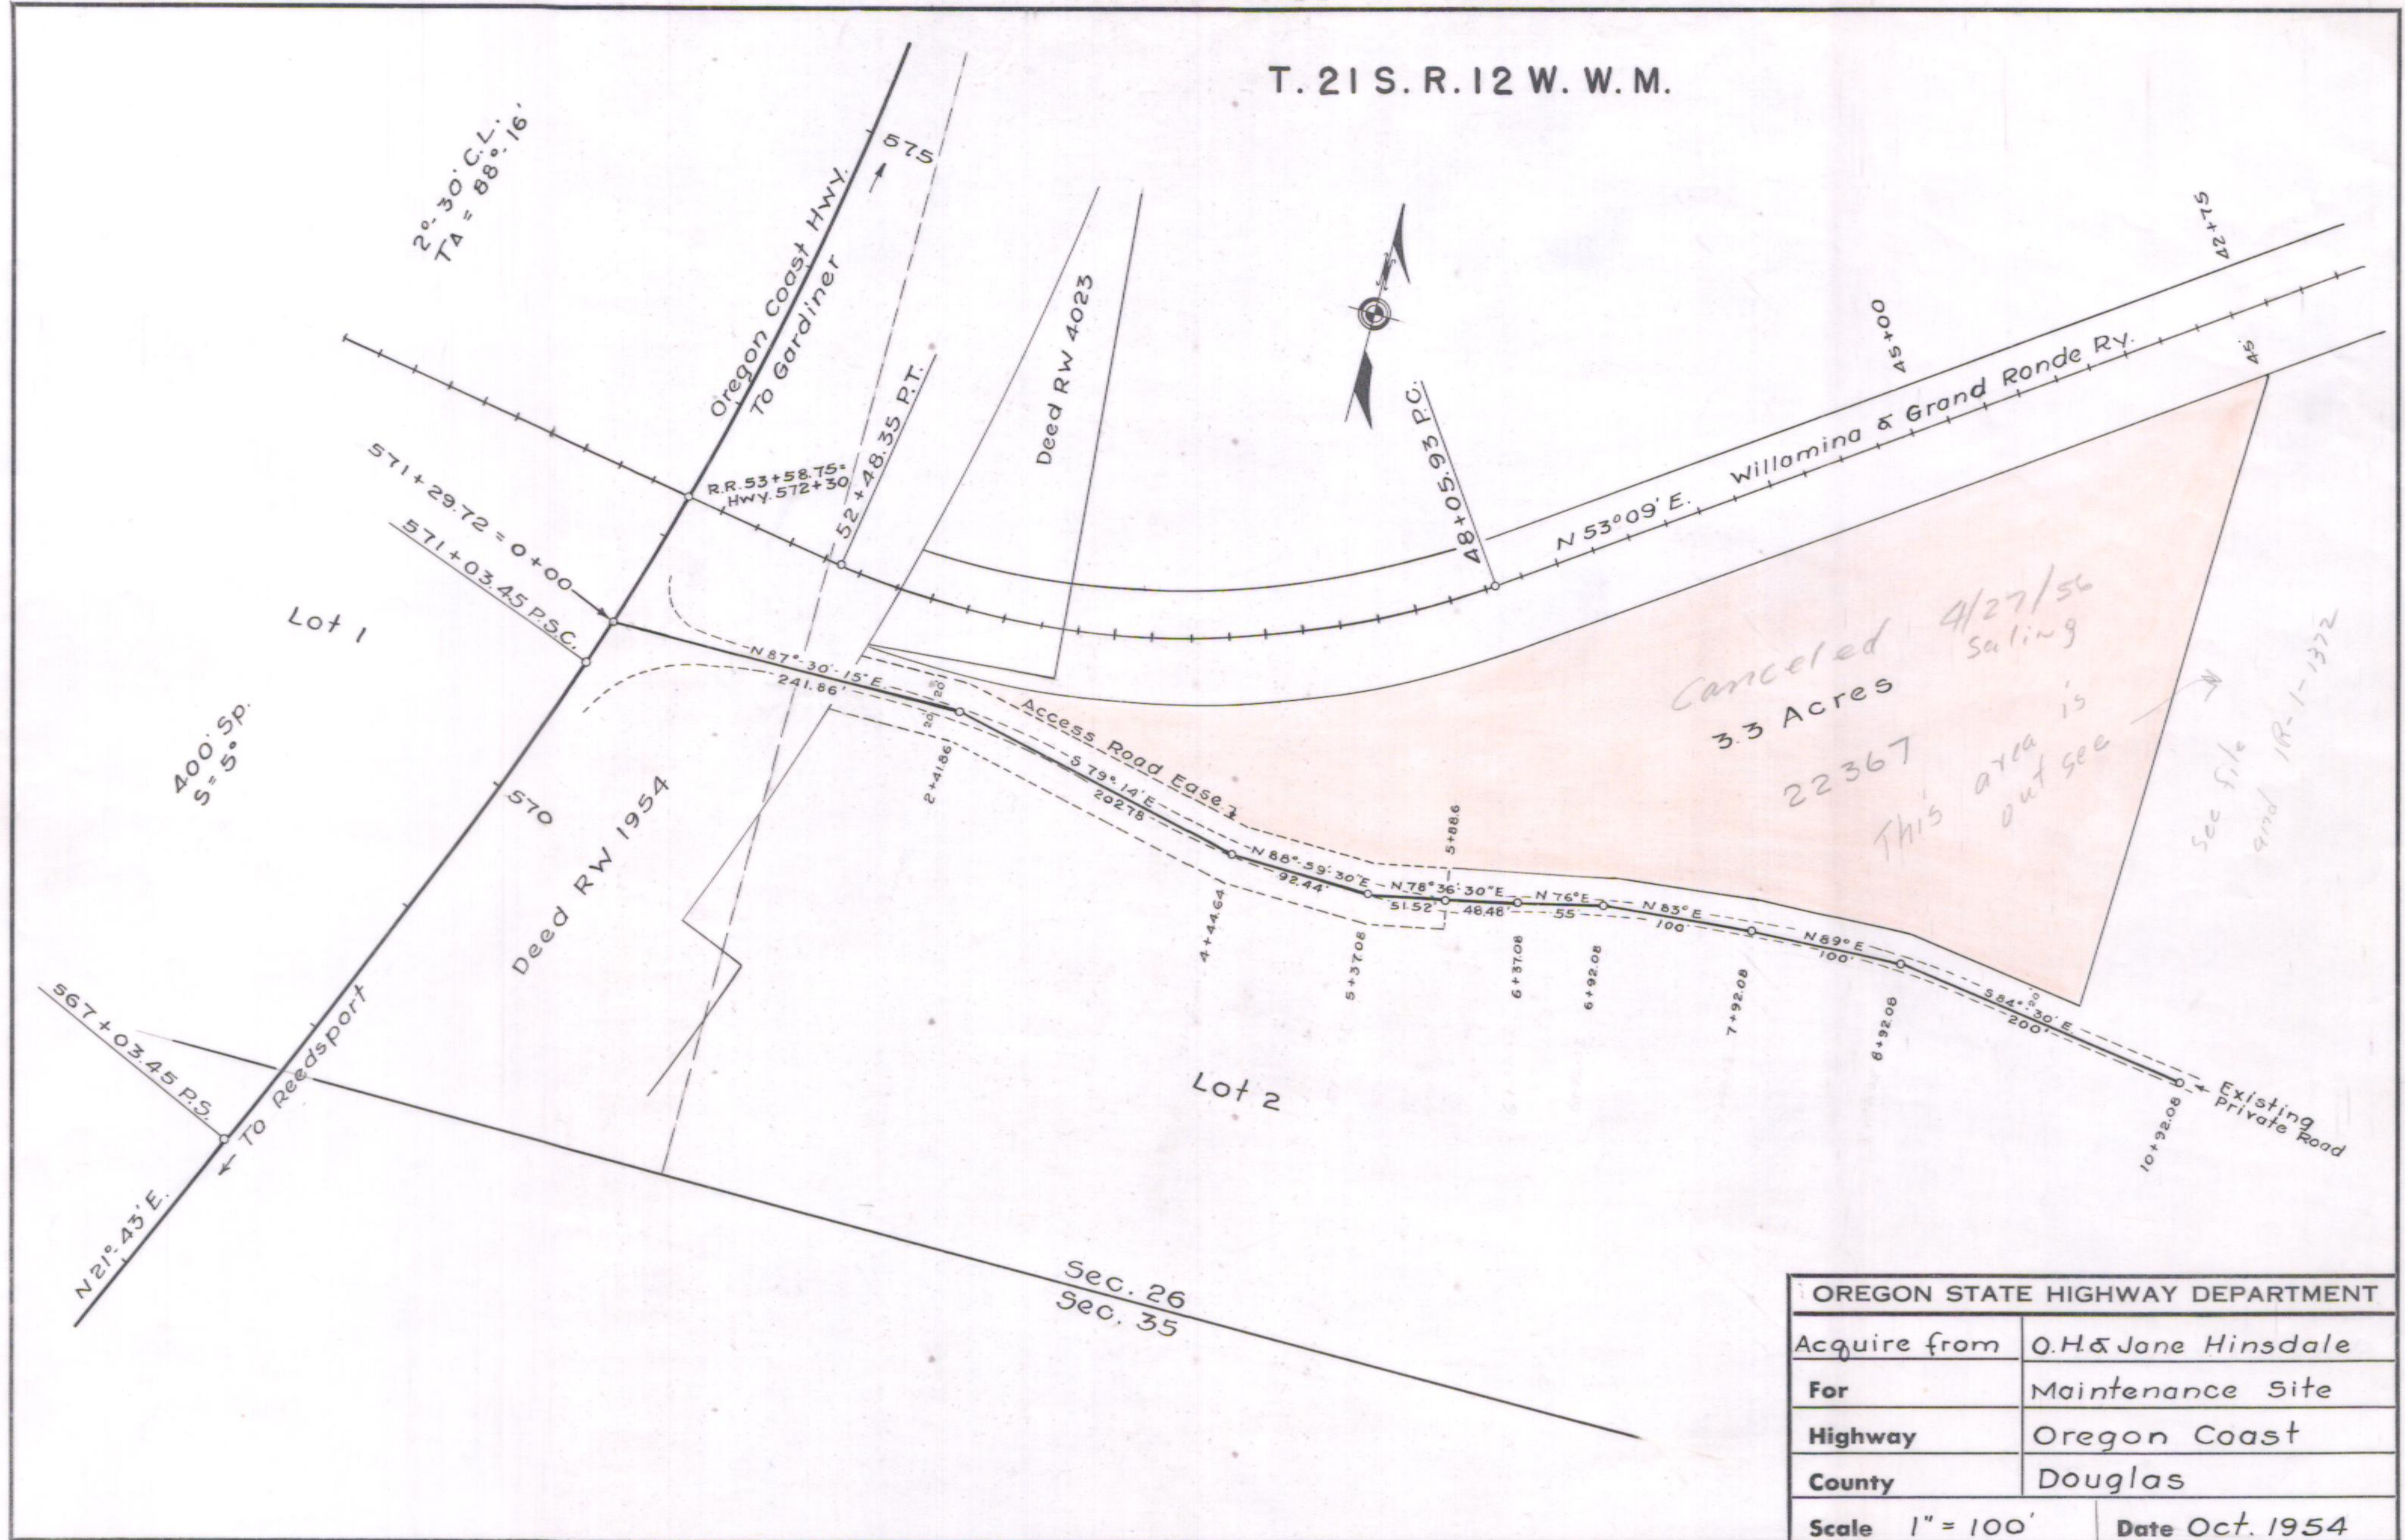

OREGON STATE HIGHWAY DEPARTMENT	
Acquire from	O.H. & Jane Hinsdale
For	Maintenance Site
Highway	Oregon Coast
County	Douglas
Scale 1" = 100'	Date Oct. 1954