OREGON STATE HIGHWAY DEPARTMENT

Right of Way Map

NIT 2, RICE HILL - OAKLAND SECTION

PACIFIC HIGHWAY

DOUGLAS COUNTY

DRG. NO. 28-3-18

Nov. 1932

Revised:
Feb. 2011, shannon sudermon, ODOT, fix sale lines 17543

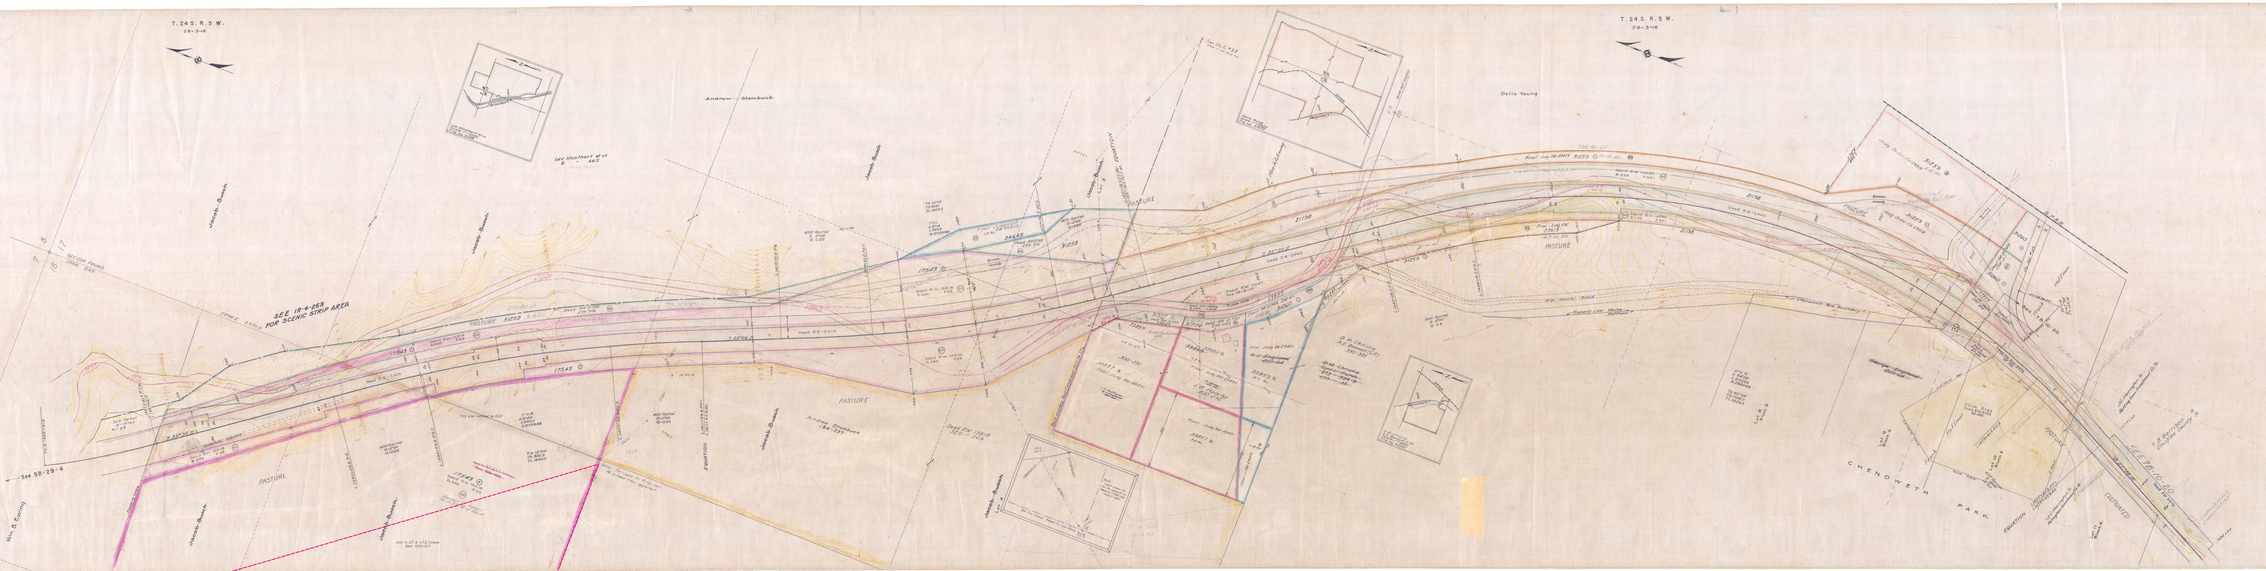

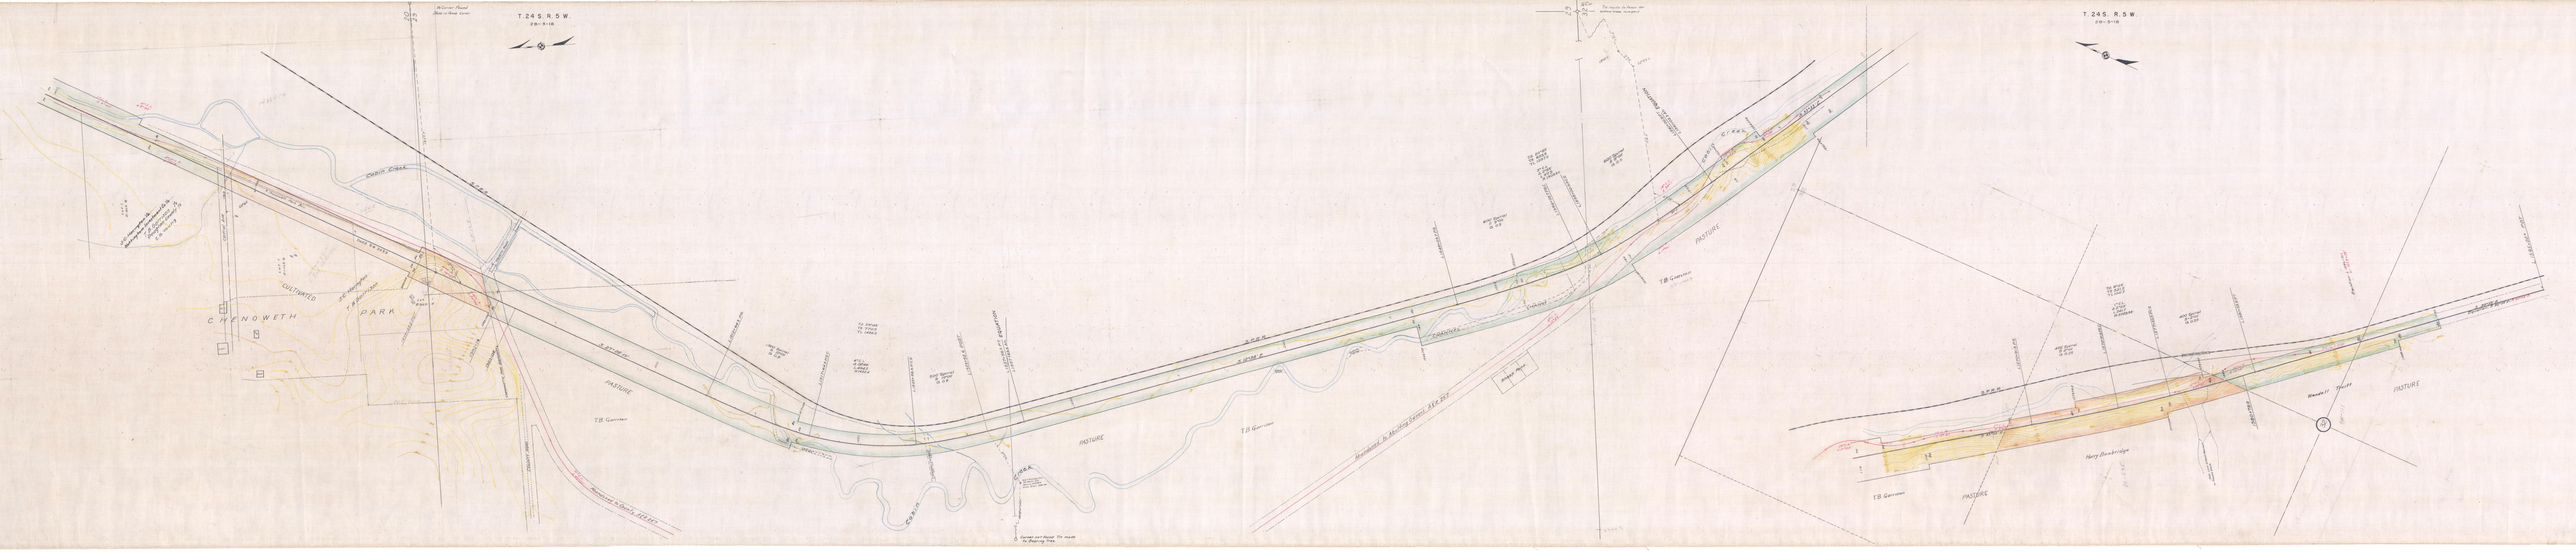
T. 24 S. R. 5 W.
T. 24 S. R. 5 W.
CHEYNOWETH
PARK
"CULTIVATED"
PASTURE
T.B. Garrison
Harry Bandridge
Wendell Huff
CABIN CREEK
Railroad & Utility R.R.
S.P.R.R.
Corner not found. To be made by Placing Pins.