142 9

T. 22 S. R. 8 W.

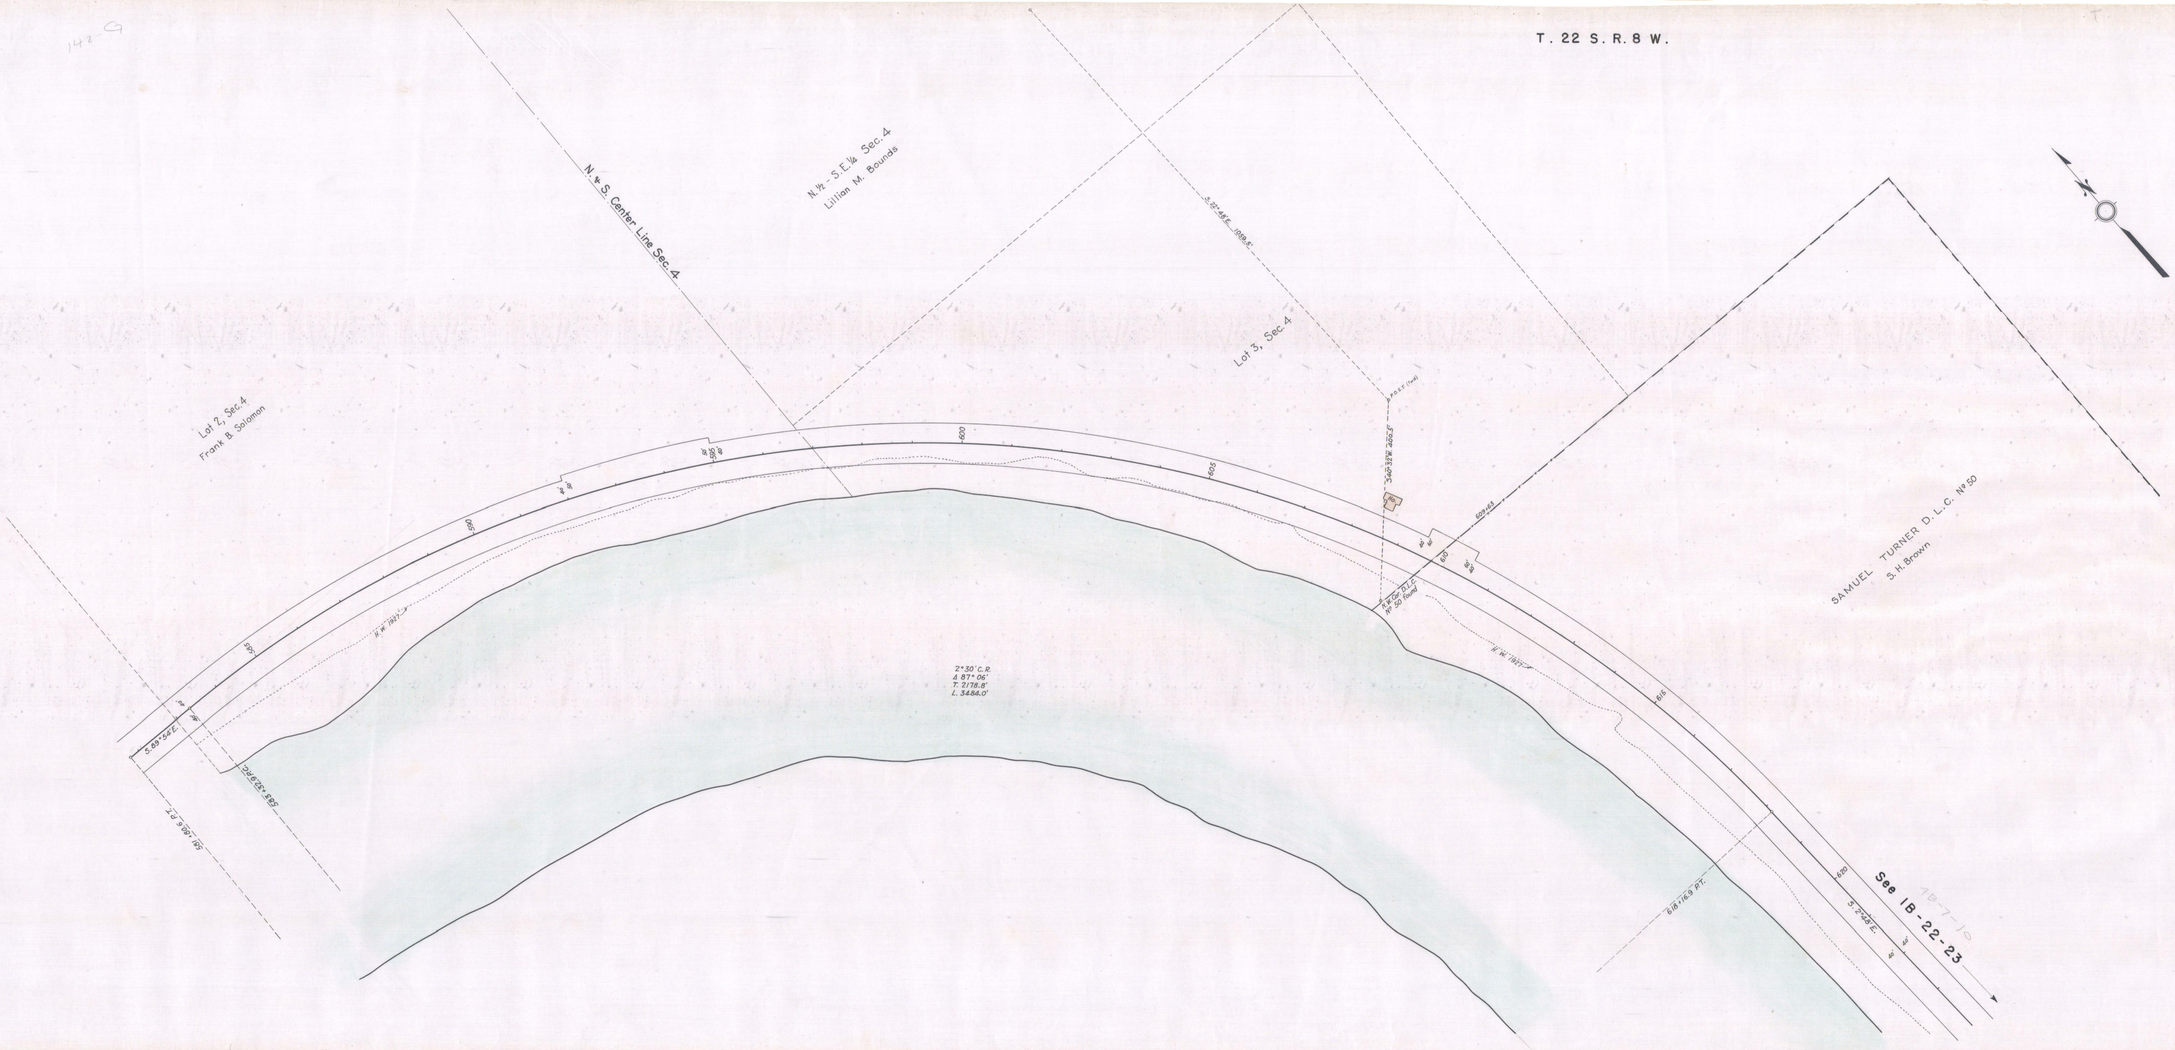

Constructed Line
BURCHARD CR.-PARADISE CR. SECTION
UMPQUA HIGHWAY
DOUGLAS COUNTY
Scale: 1" = 100'
April 1933
Rev July 1971
DRG. Nº 28-24-21