OREGON STATE HIGHWAY DEPARTMENT

PACIFIC HIGHWAY

CONSTRUCTED LINE

YONCALLA TO ROSEBURG

DOUGLAS COUNTY

Scale 1in. = 400 Ft. September 1923

Dwg. No. 3B11-12.

SUPERSEDED BY DWG. 11-B-17

OBSOLETE

See Dwg. No. 6B-29-15,

6B-29-16

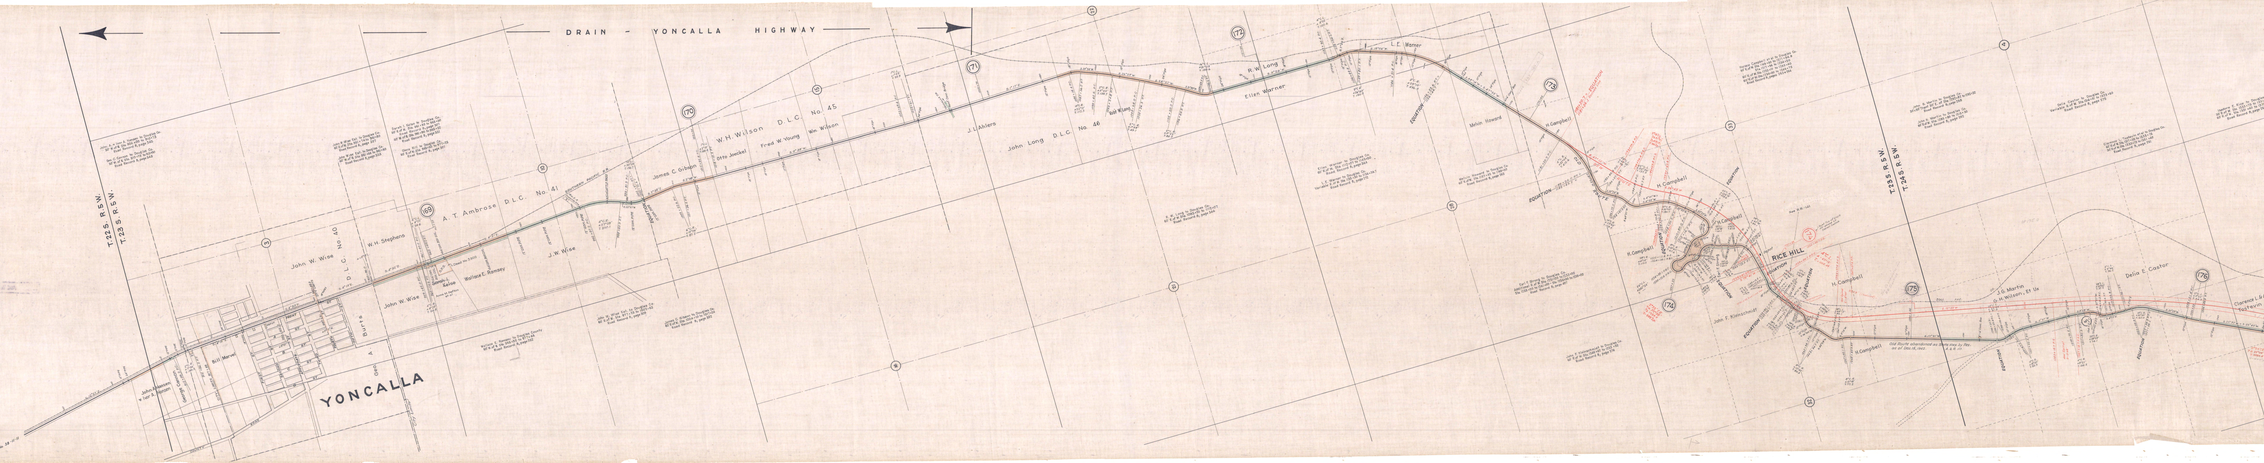

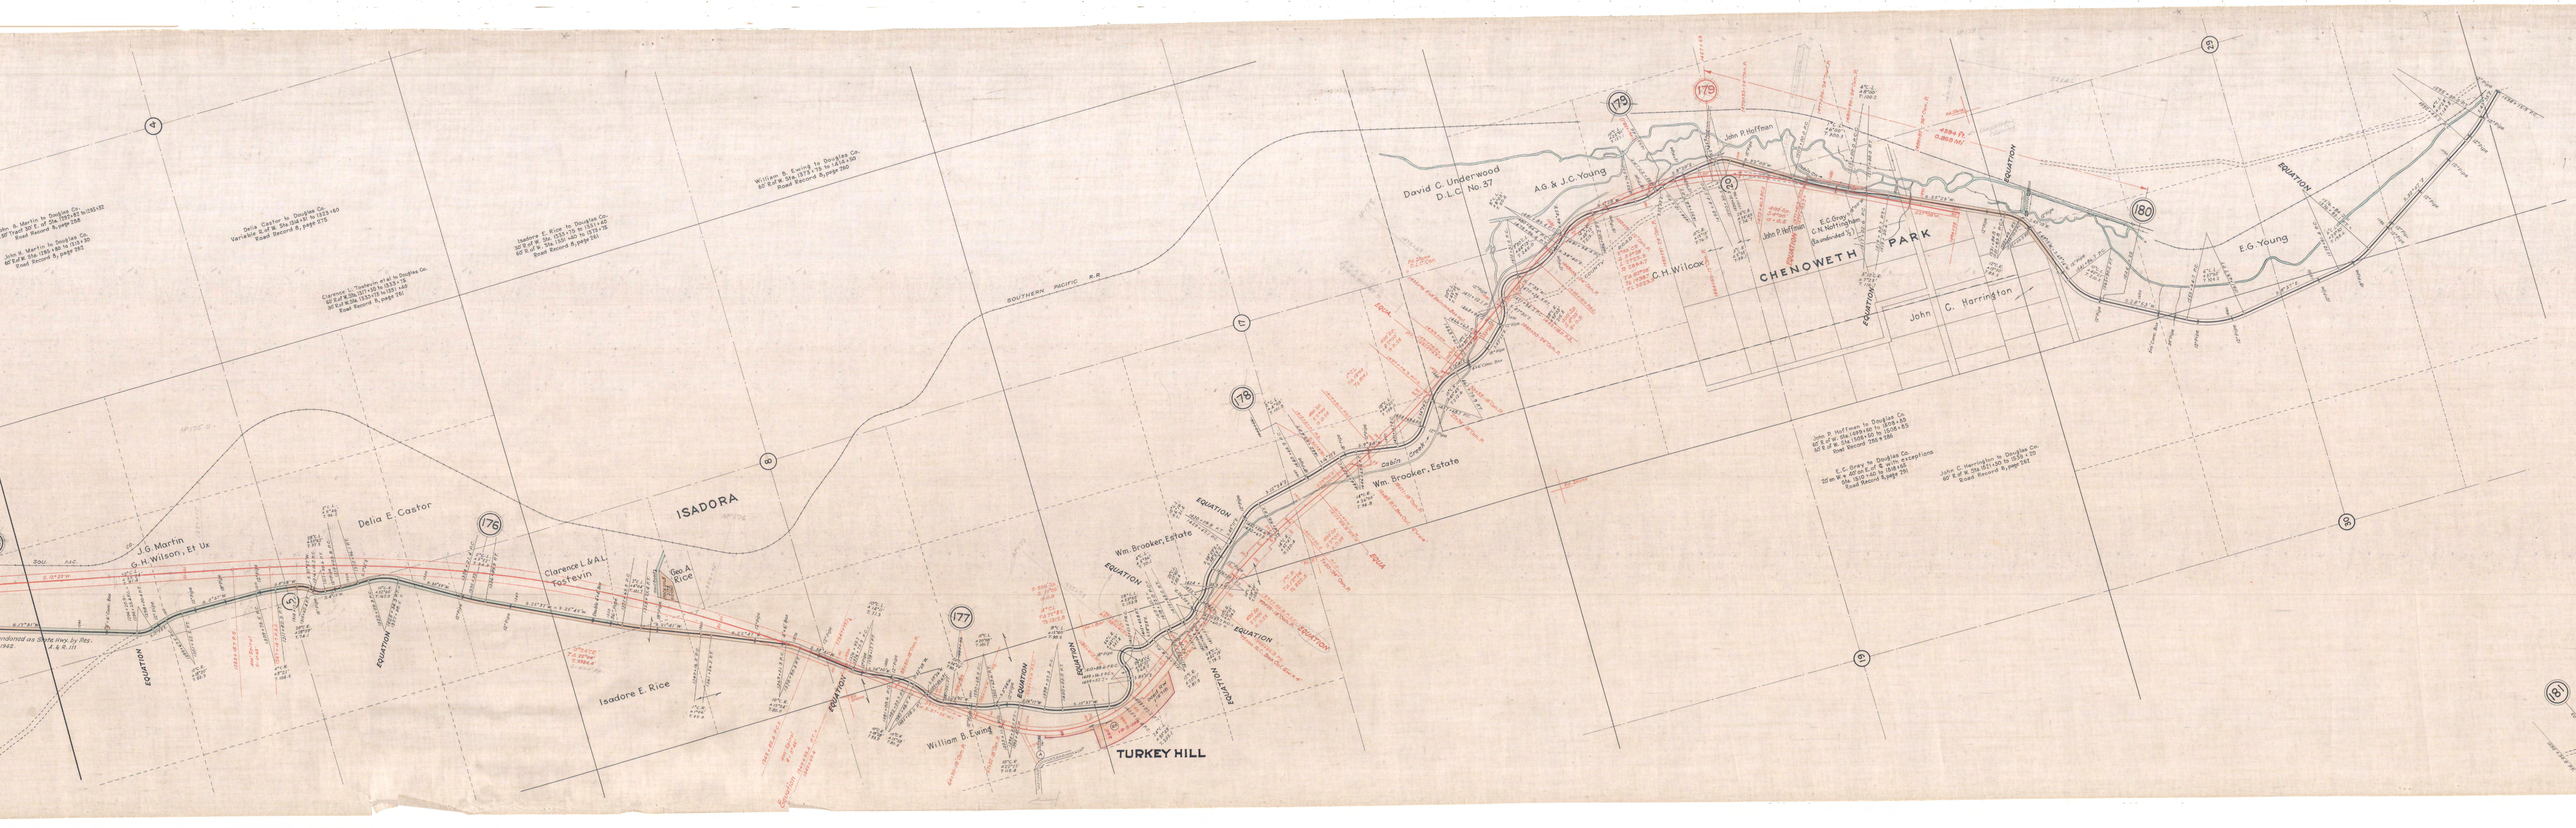
ISADORA
TURKEY HILL
CHENOWETH PARK
SOUTHERN PACIFIC R.R
J.G. Martin
G.H. Wilson, Et Ux
Delia E. Castor
Clarence L. & A.L. Tostevin
Geo. A. Rice
Isadore E. Rice
William B. Ewing
Wm. Brooker Estate
David C. Underwood D.L.C. No. 37
A.G. & J.C. Young
John P. Hoffman
C.H. Wilcox
John C. Harrington
E.G. Young
EQUATION
176
177
178
179
180

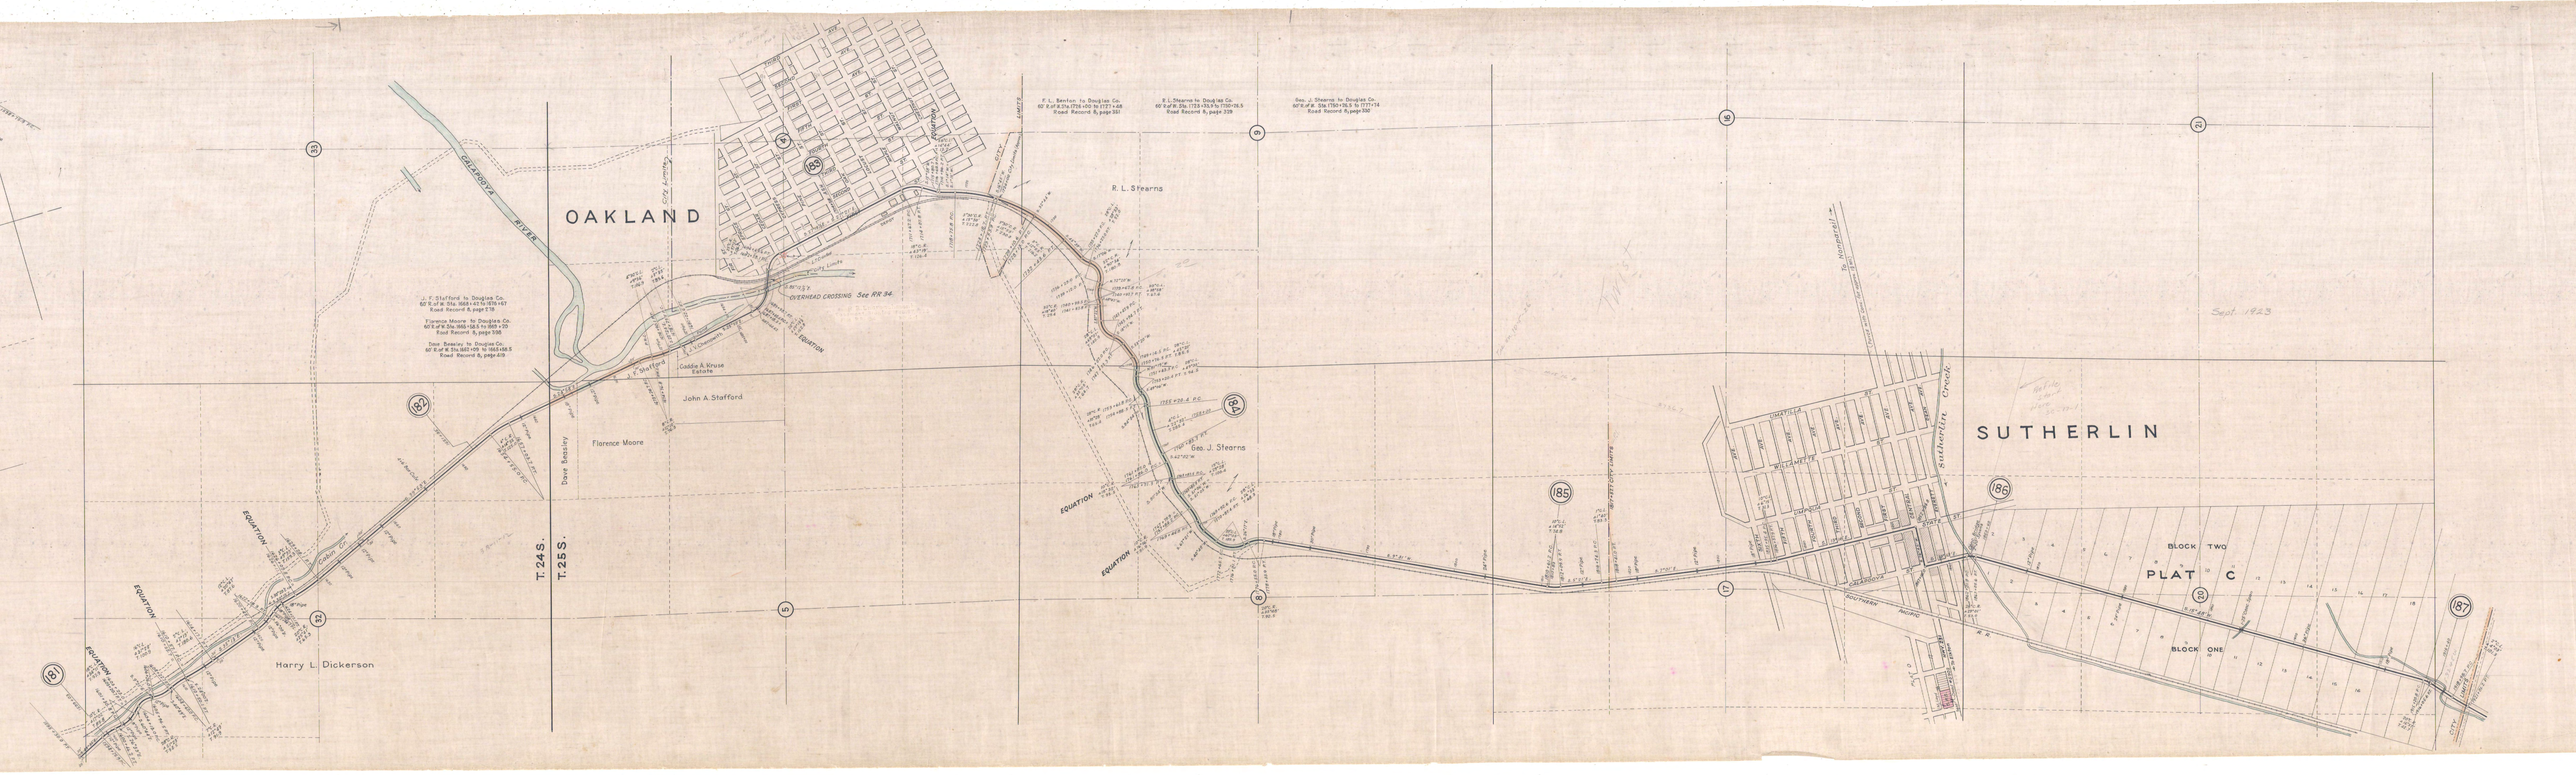
OAKLAND
SUTHERLIN
R. L. Stearns
Geo. J. Stearns
John A. Stafford
Florence Moore
Dave Beasley
Caddie A. Kruse Estate
Harry L. Dickerson
J. F. Stafford to Douglas Co. 60' R. of W. 31a. 1663+67.1 to 1715+67 Road Record 8, page 338
Florence Moore to Douglas Co. 60' R. of W. 34a. 1665+56.5 to 1669+20 Road Record 8, page 336
Dave Beasley to Douglas Co. 60' R. of W. 31a. 1667+09 to 1663+58.5 Road Record 8, page 419
F. L. Benton to Douglas Co. 60' R. of W. 31a. 1758+00 to 1777+68 Road Record 8, page 367
F. L. Stearns to Douglas Co. 60' R. of W. 31a. 1733+93.9 to 1750+26.5 Road Record 8, page 328
Geo. J. Stearns to Douglas Co. 60' R. of W. 31a. 1750+26.5 to 1777+74 Road Record 8, page 330
OVERHEAD CROSSING See RR 94.
EQUATION
CITY LIMITS
T. 24 S.
T. 25 S.
UMATILLA
SOUTHERN PACIFIC R.R.
Sutherlin Creek
BLOCK TWO
PLAT C
BLOCK ONE
Sept. 1923

ROSEBURG
WINCHESTER
WILBUR
PLAT "D" ROSEBURG HOME ORCHARD TRACTS
R.5W.
R.6W.
OBSOLETE
See Drg. No. 6B-29-15,
6B-29-16
Yoncalla to Roseburg
DR'G. NO. 3B11-12
SUPERSEDED BY DRG. 6B-29-15 6B-29-16