OREGON STATE HIGHWAY DEPARTMENT

PACIFIC HIGHWAY

CONSTRUCTED LINE

YONCALLA to ROSEBURG

DOUGLAS COUNTY

Scale: 1in. = 400 ft. September 1923

Dwg. No. 3B1H-12

APPROVED BY ORD. 1-22-24

OBSOLETE

See Drg. No. 6B-29-15,
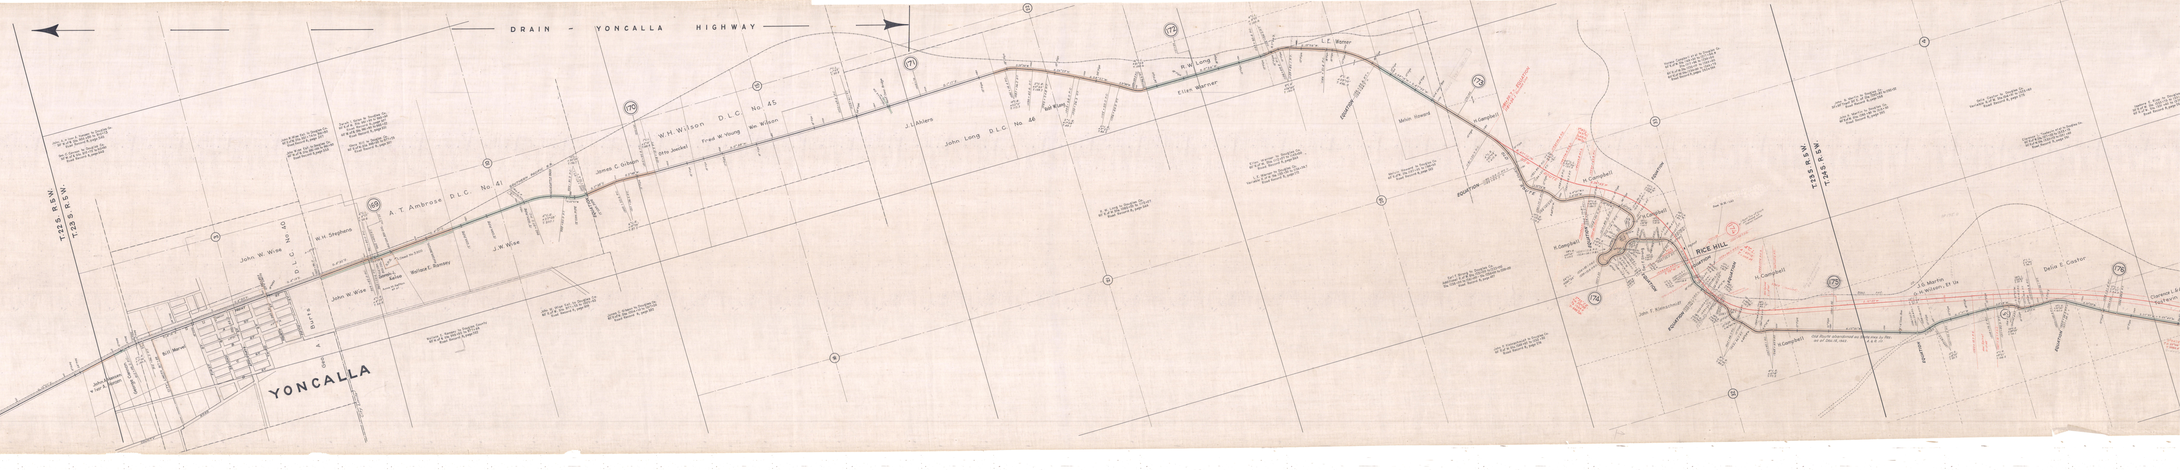
6B-29-16