OREGON STATE HIGHWAY DEPARTMENT
LOCATED LINE

GARDINER SUMMIT - LANE CO. LINE SECTION

ROOSEVELT-COAST HIGHWAY DOUGLAS COUNTY

SCALE 1 INCH = 400 FEET

SURVEY BEGUN AUG. 13, 1921 SURVEY PARTIALLY COMPLETED DEC. 18, 1921
" " JAN. 12, 1922 SURVEY COMPLETED MARCH 28, 1922
BEARINGS TRUE U.S.G.S. DATUM
B.O. Johnson Locating Engineer.

DR'G. No. 3B23-26

SUPERSEDED BY DRG. [illegible]

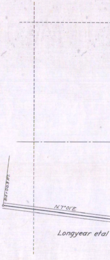
812+00.3 P.T.
N.7°01'E.
Longyear etal

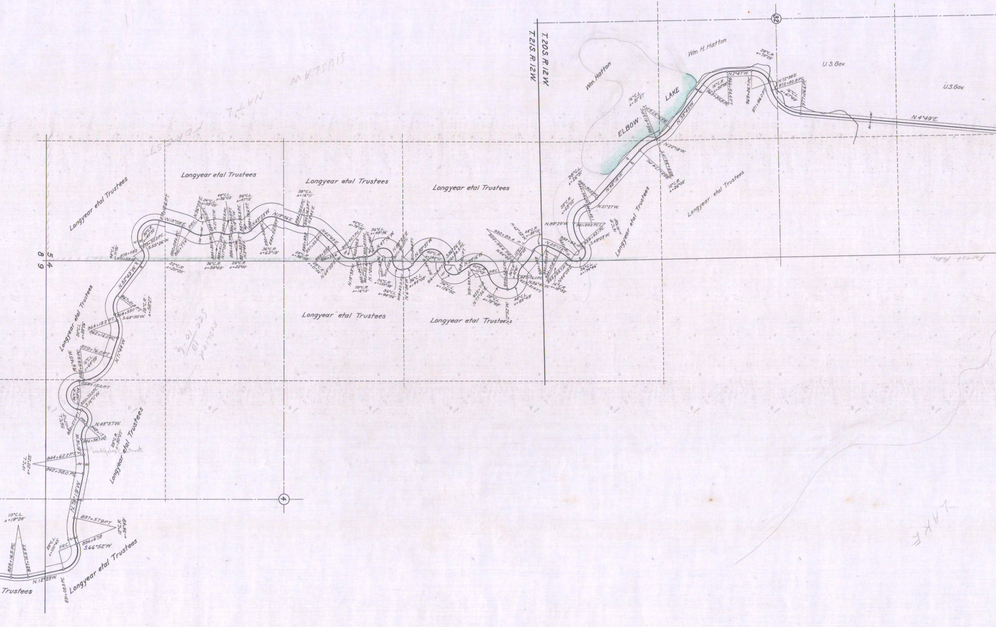

T.20S.R.12W.
T.21S.R.12W.
Wm. Hatton
Wm. H. Hatton
ELBOW LAKE
U.S.Gov.
U.S.Gov.
32
4
8 9
5 4
SIUSLAW NAT'L FOREST
Forest Bdry.
LAKE
Longyear etal Trustees
Longyear etal Trustees
Trustees
N.4°49'E.
N.72°38'E.
972+82.8 P.C.
16°C.L. Δ=67°49'
977+06.6 P.T.
971+96.0 P.T.
969+26.7 P.C.
28°C.R. Δ=75°25'
N.2°47'W.
966+54.4 P.T.
16°C.R. Δ=50°58'
963+35.8 P.C.
N.53°45'W.
955+41.3 P.C.
957+37.9 P.T.
16°C.L. Δ=31°27'
N.22°18'W.
955+34.1 P.T.
953+17.4 P.C.
12°C.R. Δ=26°00'
N.48°18'W.
945+90.5 P.T.
944+96 P.C.
28°C.L. Δ=26°51'
28°C.R. Δ=68°02'
N.21°27'W.
941+99.2 P.C.C.
16°C.R. Δ=14°18'
N.89°29'W.
939+42.1 P.C.
S.49°23'W.
939+33.1 P.T.
N.25°17'E.
56°C.L. Δ=174°46'
16°C.R. Δ=18°52'
N.44°09'E.
935+55.7 P.T.
N.62°53'W.
48°C.R. Δ=88°10'
927+76.0 P.C.
927+31.4 P.T.
N.86°41'W.
48°C.L. Δ=85°49'
N.52°43'W.
867+01.8 P.T.
864+93.0 P.C.
28°C.R. Δ=58°27'
S.68°50'W.
864+13.2 P.T.
862+16.0 P.C.
859+76.0 P.T.
16°C.L. Δ=64°59'
N.71°44'W.
N.6°45'W.
855+69.9 P.C.
853+15.2 P.T.
36°C.R. Δ=189°04'
850+73.3 P.C.
S.14°11'W.
56°C.L. Δ=117°12'
850+27.0 P.T.
P.R.C.
N.48°37'W.
848+17.7
846+38.7 P.C.
28°C.R. Δ=50°07'
S.81°16'W.
Sand Gates Contract
844+62.2 P.T.
10°C.L. Δ=20°25'
842+58.0 P.C.
N.78°19'W.
837+57.9 P.T.
12°C.R. Δ=34°49'
834+67.8
S.66°52'W.
28°C.L. Δ=100°45'
P.R.C.
831+08.0 P.C.
N.12°23'W.
10°C.L. Δ=19°24'
825+16.5 P.C.
827+10.5 P.T.
N.15°58'E.
S.55°26'W.
22°C.R. Δ=20°25'
36°C.R. Δ=39°49'
28°C.R. Δ=22°00'
N.43°23'W.
N.19°56'E.
28°C.L. Δ=16°11'
48°C.L. Δ=36°03'
56°C.L. Δ=47°12'
36°C.R. Δ=63°19'
40°C.L. Δ=79°38'
56°C.L. Δ=48°36'
56°C.L. Δ=135°04'
N.50°37'W.
40°C.R. Δ=47°03'
56°C.L. Δ=126°50'
28°C.L. Δ=78°48'
48°C.L. Δ=83°49'
N.56°47'W.
Sec 10-6
18
Revised

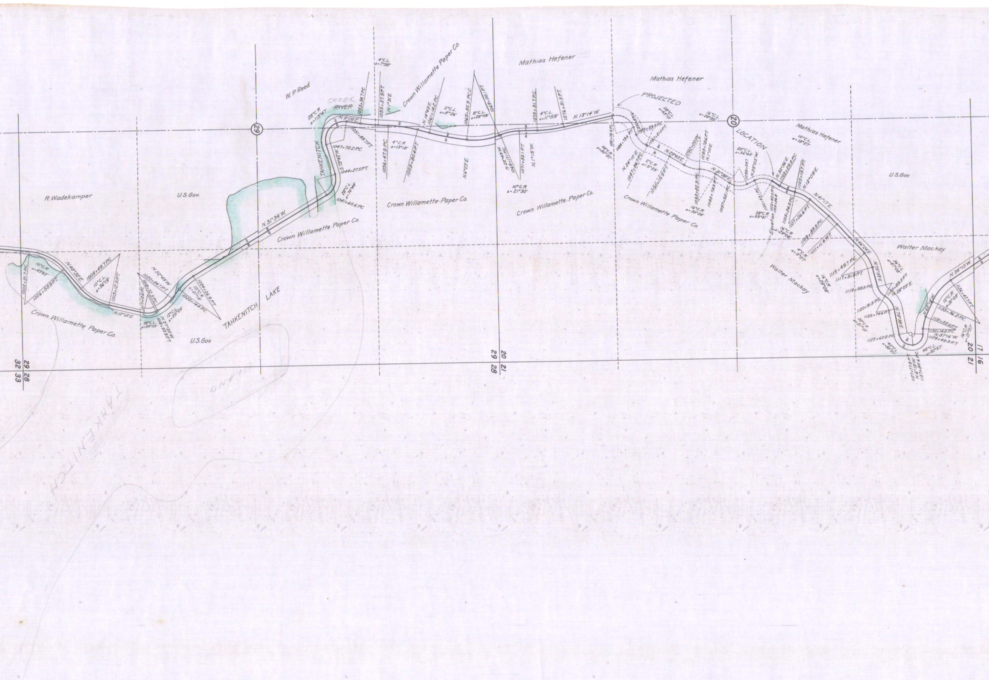
R. Wadekamper
U.S. Gov.
U.S. Gov.
Crown Willamette Paper Co.
1002+21.7 P.C.
10°C.R. Δ=43°43'
1006+58.9 P.T.
N.48°32'E.
1009+49.7 P.C.
10°C.L. Δ=36°19'
1013+12.9 P.T.
N.12°13'E.
1017+12.6 P.C.
28°C.L. Δ=39°33'
1018+72.3 P.C.
1018+53.9 P.T.
N.27°20'W.
1020+84.7 P.T.
N.52°49'W.
12°C.L. Δ=25°29'
1022+14.4 P.C.
10°C.R. Δ=21°15'
1024+26.9 P.T.
TAHKENITCH LAKE
N.31°34'W.
Crown Willamette Paper Co.
29
32 33
29 28
W. P. Reed
CREEK
~~RIVER~~
TAHKENITCH
28°C.R. Δ=115°47'
N.9°29'E.
1053+38.7 P.C.
1051+83.7 P.T.
1047+70.2 P.C.
S.73°42'W.
1044+27.5 P.T.
28°C.L. Δ=74°44'
1041+60.6 P.C.
4°C.L. Δ=7°58'
1055+37.9 P.T.
N.1°31'E.
1056+47.9 P.C.
4°C.R. Δ=13°18'
1059+80.4 P.T.
Crown Willamette Paper Co.
N.14°49'E.
1061+14.2 P.C.
2°C.L. Δ=8°26'
1065+35.9 P.C.C.
8°C.L. Δ=29°08'
N.6°23'E.
1069+00.1 P.T.
Crown Willamette Paper Co.
N.22°45'W.
1069+17.1 P.C.
10°C.R. Δ=21°30'
1071+32.1 P.T.
N.1°15'W.
1073+31.7 P.C.
4°C.L. Δ=11°59'
1076+31.3 P.T.
N.13°14'W.
Mathias Hefener
Crown Willamette Paper Co.
29 28
20 21
Mathias Hefener
PROJECTED
1081+78.5 P.C.
28°C.R. Δ=82°37'
N.69°23'E.
1084+73.6 P.T.
1085+59.5 P.C.
28°C.L. Δ=45°13'
1087+21.0 P.T.
N.24°10'E.
1087+36.7 P.C.
2°C.R. Δ=5°35'
1090+15.9 P.T.
N.29°45'E.
1092+00 P.C.
1093+78.6 P.T.
N.1°10'E.
1093+82.9 P.C.
16°C.R. Δ=30°28'
1095+73.3 P.T.
N.31°38'E.
16°C.L. Δ=28°35'
1097+52.1 P.C.
Crown Willamette Paper Co.
20
LOCATION
28°C.L. Δ=56°43'
1099+54.7
N.25°05'W.
1100+43.1 P.C.
28°C.R. Δ=55°41'
Equation
1102+42.0 P.T.
1102+26.8
N.30°36'E.
1103+29.8 P.C.
16°C.R. Δ=29°08'
Mathias Hefener
10°C.L. Δ=18°27'
1105+24.5 P.C.
1105+13.7 P.T.
N.12°09'E.
1107+06.6 P.T.
N.41°17'E.
1109+83.5 P.C.
1111+11.4 P.T.
4°C.R. Δ=5°07'
Walter Mackay
U.S. Gov.
Walter Mackay
N.46°24'E.
1115+49.7 P.C.
1117+31.9 P.T.
16°C.R. Δ=29°09'
N.75°33'E.
36°C.L. Δ=47°08'
1119+58.8 P.C.
1120+89.5 P.T.
N.28°25'E.
1120+91.5 P.C.
1122+74.4 P.T.
28°C.R. Δ=51°13'
N.79°38'E.
1125+62.9 P.C.
40°C.L. Δ=85°57'
1127+77.8 P.T.
N.6°19'W.
1127+80.6 P.C.
48°C.L. Δ=80°57'
1129+49.3 P.T.
N.87°16'W.
1130+14.8 P.C.
1131+52.0 P.T.
N.65°19'W.
10°C.R. Δ=31°09'
1133+36.2 P.C.
1136+47.7 P.T.
N.34°10'W.
16°C.R. Δ=21°57'
20 21
17 16
ISLAND
TAHKENITCH

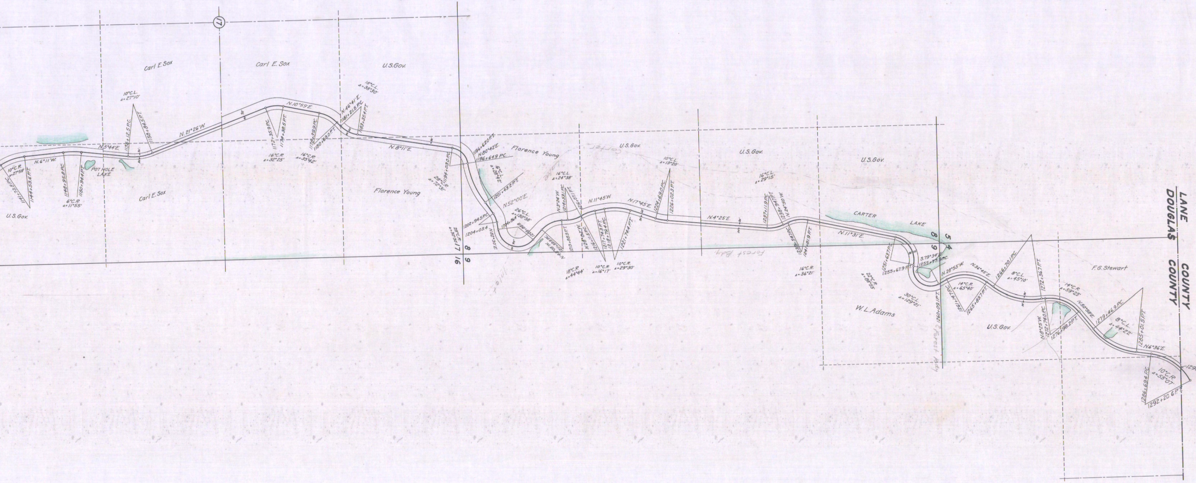
17
Carl E. Sox
Carl E. Sox
U.S.Gov.
Carl E. Sox
U.S. Gov.
POT HOLE LAKE
10°C.R. Δ=27°59'
1141+73.8 P.C.
1144+53.6 P.T.
N.6°11'W.
1148+95.8 P.C.
1150+94.4 P.T.
6°C.R. Δ=11°55'
N.5°44'E.
10°C.L. Δ=27°10'
1156+12.5 P.C.
1158+84.5 P.T.
N.21°26'W.
N.10°59'E.
1172+35.9 P.C.
1174+38.5 P.T.
16°C.R. Δ=32°25'
1178+39.9 P.C.
1180+63.0 P.T.
16°C.R. Δ=35°42'
N.46°41'E.
1181+21.5 P.C.
1183+35.4 P.T.
18°C.L. Δ=38°30'
N.8°11'E.
1194+03.0 P.C.
28°C.R. Δ=72°31'
Florence Young
1196+62.0 P.T.
N.80°42'E.
1196+64.9 P.C.
Florence Young
6°C.L. Δ=28°42'
1201+43.2 P.T.
N.52°00'E.
1202+94.5 P.C.
1204+03.4
28°C.R. Δ=30°30'
N.82°30'E.
26°C.L. Δ=130°38'
1204+86.4
1209+98.8
17
16
8
9
Lake
Inlet
16°C.L. Δ=24°38'
N.3°24'W.
1214+53.1 P.C.
1216+07.1 P.T.
N.48°00'W.
1211+39.8 P.C.
1213+88.3 P.T.
N.28°04'W.
1216+11.5 P.C.
18°C.R. Δ=44°44'
1217+74.3 P.T.
1218+79.4 P.C.
10°C.R. Δ=16°17'
1221+74.4 P.T.
10°C.R. Δ=29°30'
N.11°45'W.
N.17°45'E.
Carter
U.S. Gov.
10°C.L. Δ=13°20'
1224+69.0 P.C.
1226+02.3 P.T.
U.S. Gov.
N.4°25'E.
Forest Bdy.
16°C.L. Δ=29°15'
1237+11.9 P.C.
1238+94.7 P.T.
N.24°50'W.
1239+54.7 P.C.
1241+81.9 P.T.
16°C.R. Δ=36°21'
U.S.Gov.
CARTER LAKE
N.11°31'E.
1251+63.7 P.C.
1255+67.9 P.T.
22°C.R. Δ=88°55'
S.79°34'E.
1255+77.9 P.C.
30°C.L. Δ=129°21'
1260+09.1 P.T.
Forest Bdy.
W. L. Adams
8
9
5
4
N.28°55'W.
1261+14.7 P.C.
14°C.R. Δ=65°40'
1265+83.7 P.T.
N.36°45'E.
1266+70.1 P.C.
8°C.L. Δ=45°10'
1272+36.7 P.T.
U.S.Gov.
N.8°25'W.
1272+74.0 P.C.
14°C.R. Δ=59°23'
1276+98.2 P.T.
N.50°58'E.
F.G. Stewart
1279+46.9 P.C.
8°C.L. Δ=44°22'
1285+01.5 P.T.
N.6°36'E.
1286+69.4 P.C.
10°C.R. Δ=55°07'
1292+20.6 P.T.
129
LANE COUNTY
DOUGLAS COUNTY

0+91

Gardiner Summit-Lane Co. Line
DR'G. No. 3B23-26

SUPERSEDED BY DRG. 4B-23-15
1B-24-16