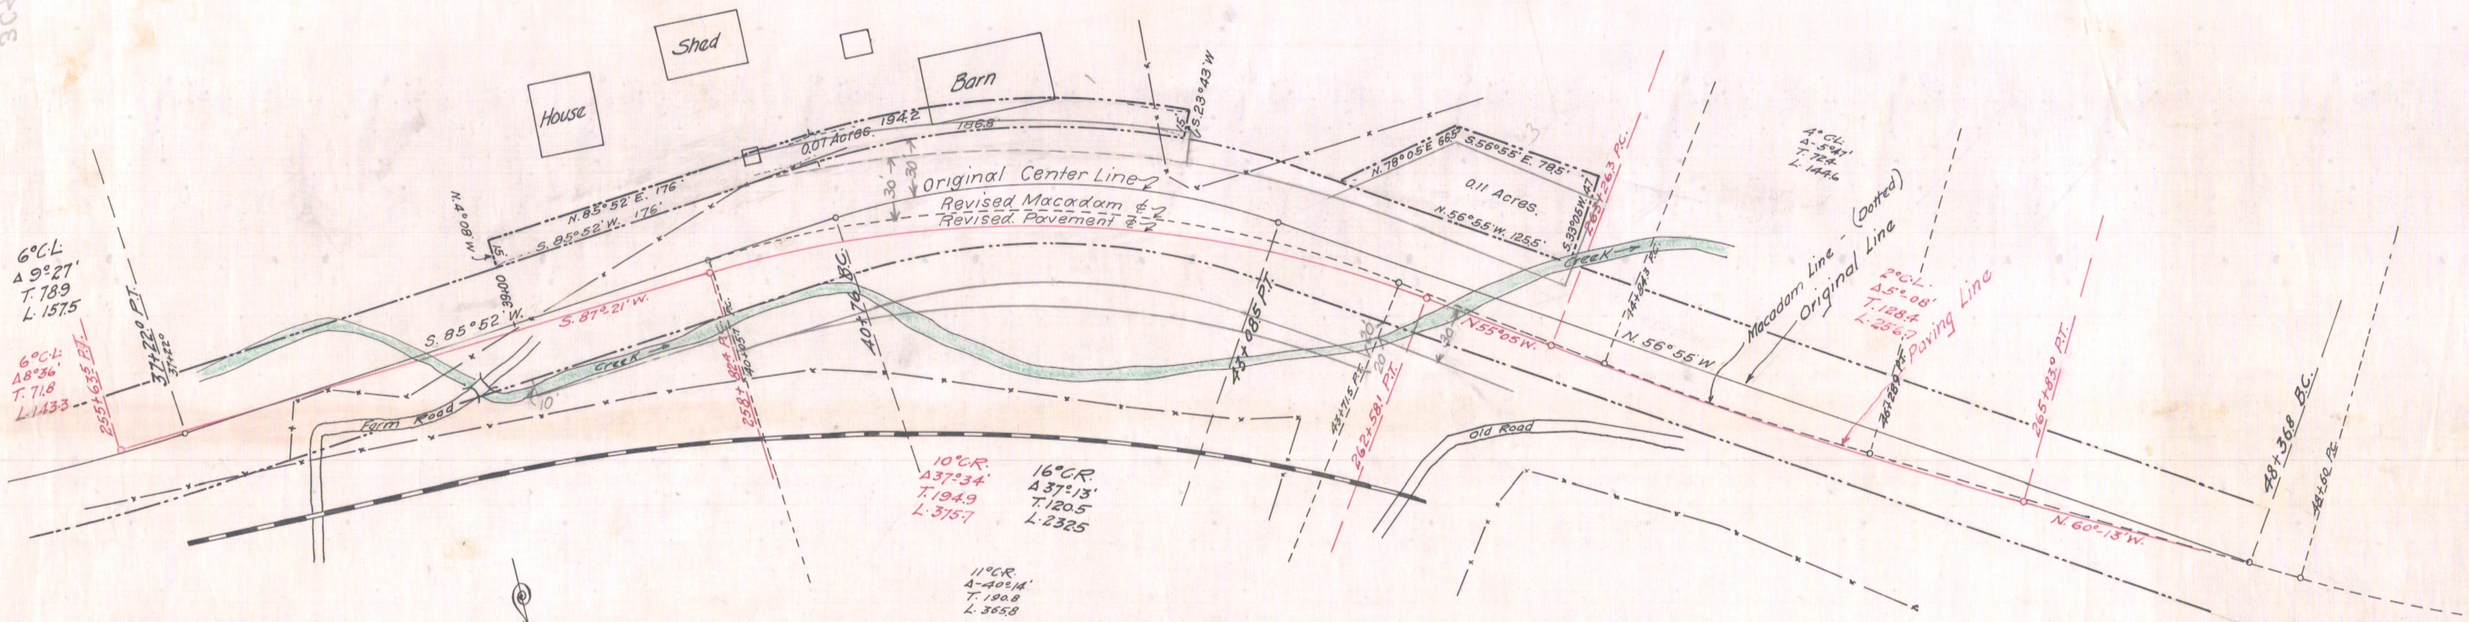

OREGON STATE HIGHWAY DEPARTMENT

MAP SHOWING

Additional Right of Way required over Property of Frank Turner near Divide in Douglas Co. Ore. Section 11 T21S R 4W

Sec 3B-11-11

Scale 1 in = 50'

DR'G. No. 3C-4-15

Appr. Sta 258±

HIGHWAY 99 (1-5)