WINSTON BRIDGE SECTION PACIFIC HIGHWAY DOUGLAS COUNTY				SHEET NO 2
FED. ROAD DIST. NO.	STATE	PROJ. NO.	FISCAL YEAR	TOTAL SHEETS
1	OREGON	NRH 78B	1934	2

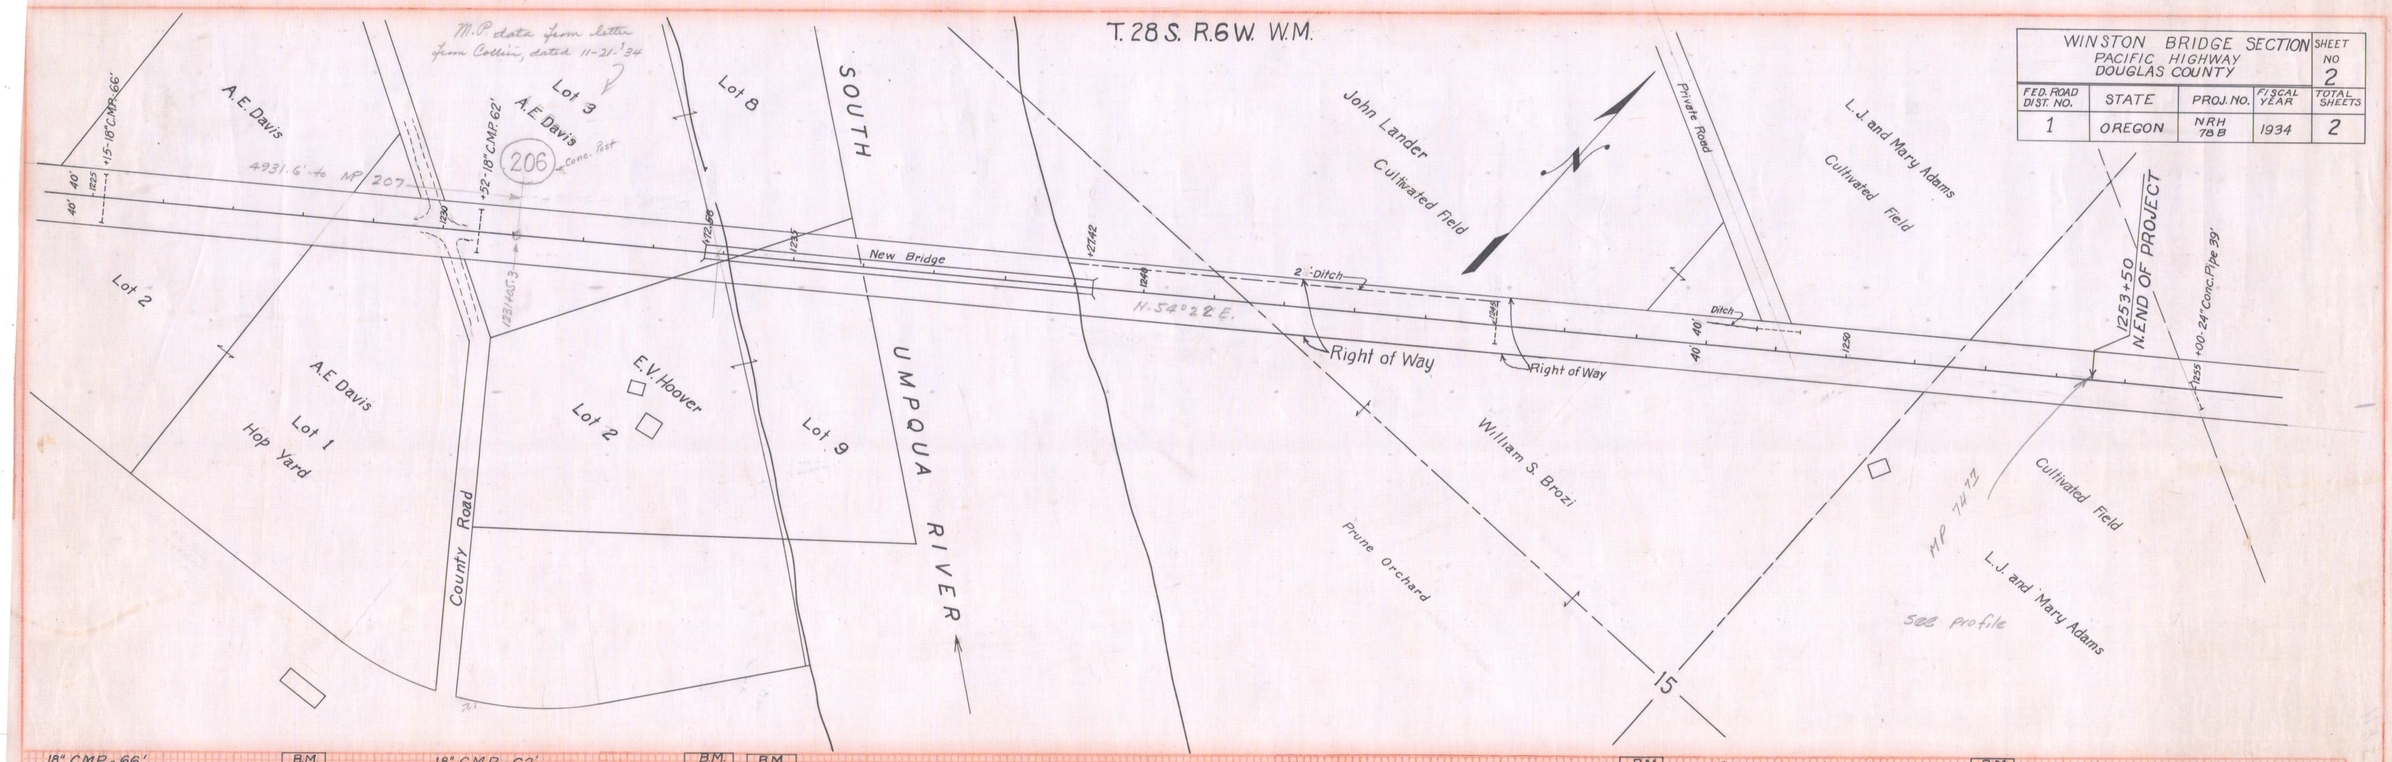

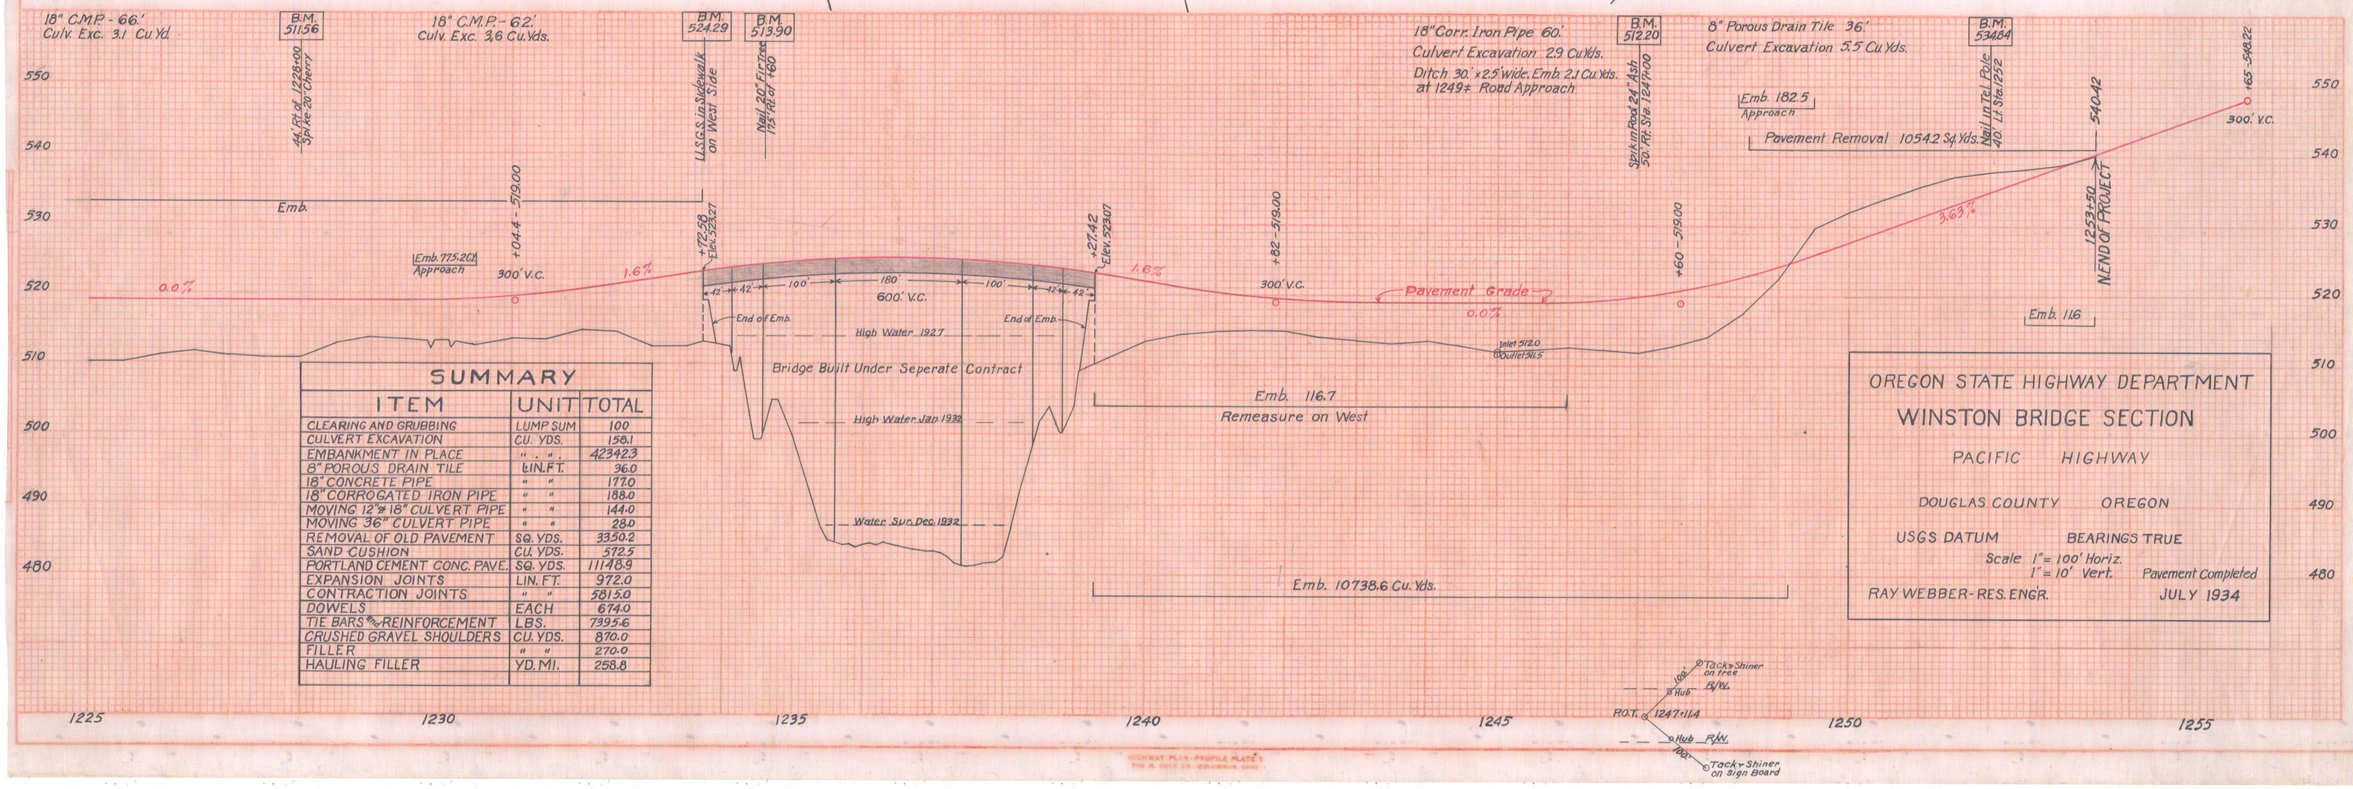

SUMMARY

ITEM	UNIT	TOTAL
CLEARING AND GRUBBING	LUMP SUM	100
CULVERT EXCAVATION	CU. YDS.	158.1
EMBANKMENT IN PLACE	" " "	42342.3
8" POROUS DRAIN TILE	LIN. FT.	36.0
18" CONCRETE PIPE	" "	177.0
18" CORROGATED IRON PIPE	" "	188.0
MOVING 12" & 18" CULVERT PIPE	" "	144.0
MOVING 36" CULVERT PIPE	" "	28.0
REMOVAL OF OLD PAVEMENT	SQ. YDS.	3350.2
SAND CUSHION	CU. YDS.	512.5
PORTLAND CEMENT CONC. PAVE.	SQ. YDS.	11148.9
EXPANSION JOINTS	LIN. FT.	972.0
CONTRACTION JOINTS	" "	5815.0
DOWELS	EACH	674.0
TIE BARS & REINFORCEMENT	LBS.	7395.6
CRUSHED GRAVEL SHOULDERS	CU. YDS.	870.0
FILLER	" "	270.0
HAULING FILLER	YD. MI.	258.8

OREGON STATE HIGHWAY DEPARTMENT

WINSTON BRIDGE SECTION

PACIFIC HIGHWAY

DOUGLAS COUNTY OREGON

USGS DATUM BEARINGS TRUE

Scale 1" = 100' Horiz.
1" = 10' Vert.

Pavement Completed

RAY WEBBER - RES. ENGR. JULY 1934