U. S. DEPARTMENT OF AGRICULTURE
BUREAU OF PUBLIC ROADS-CIRC. NO. 1
Diamond Lake Hwy.
NATIONAL FOREST ROAD
Grading.
Oregon

PROJECT N-43-C1
SHEET No.
Total Sheets

1932 Std.

ROGUE RIVER NATIONAL FOREST

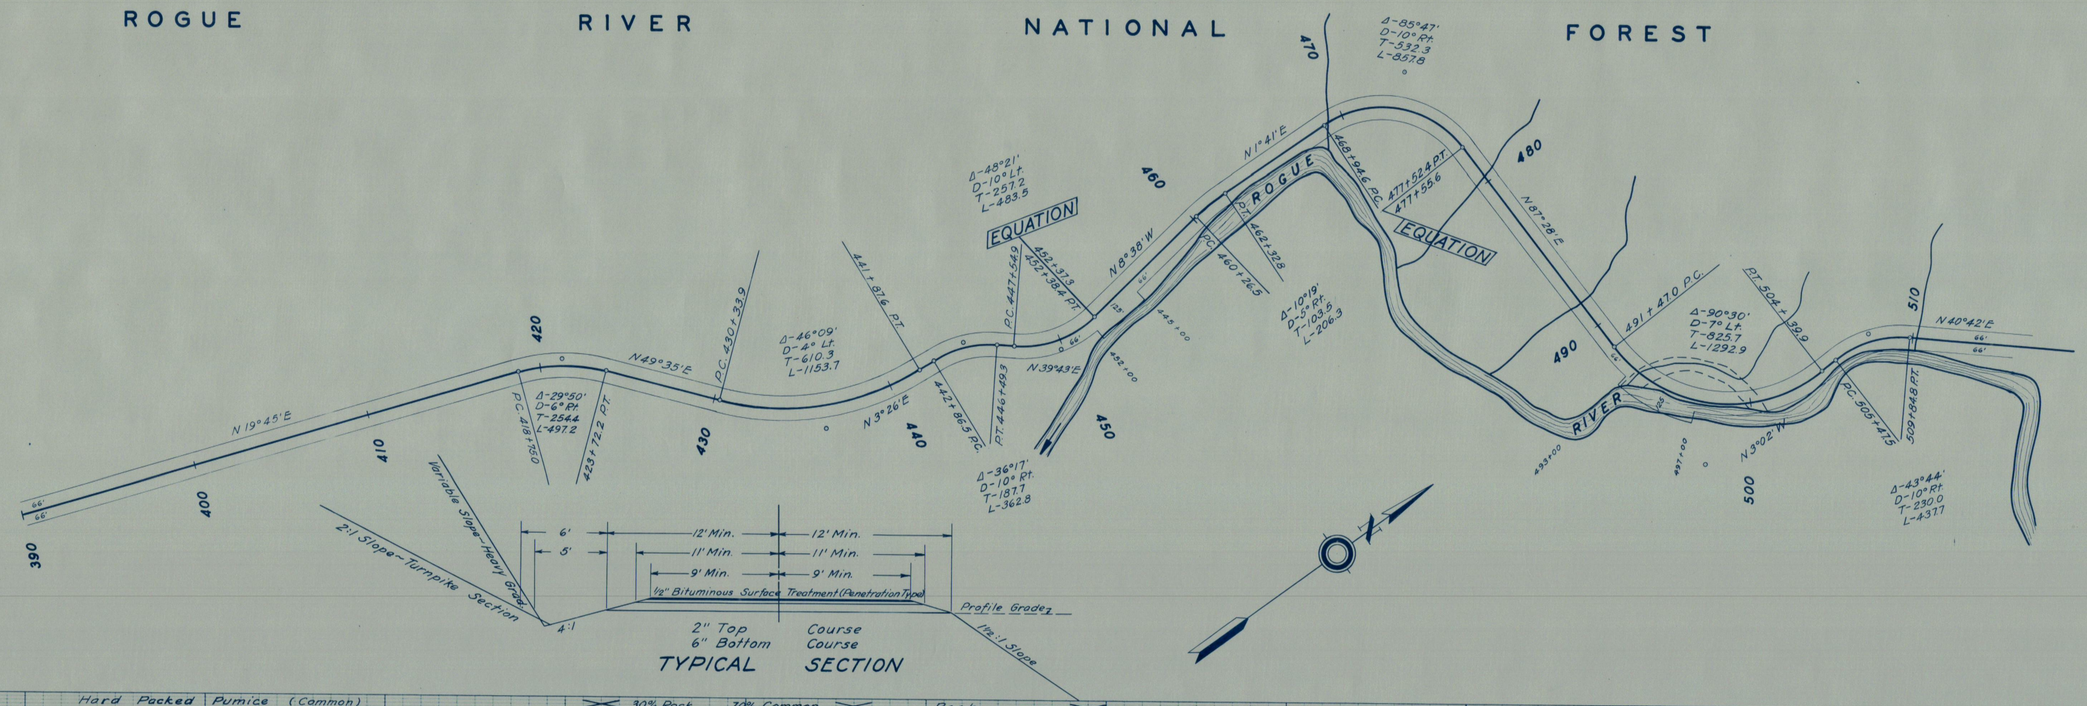

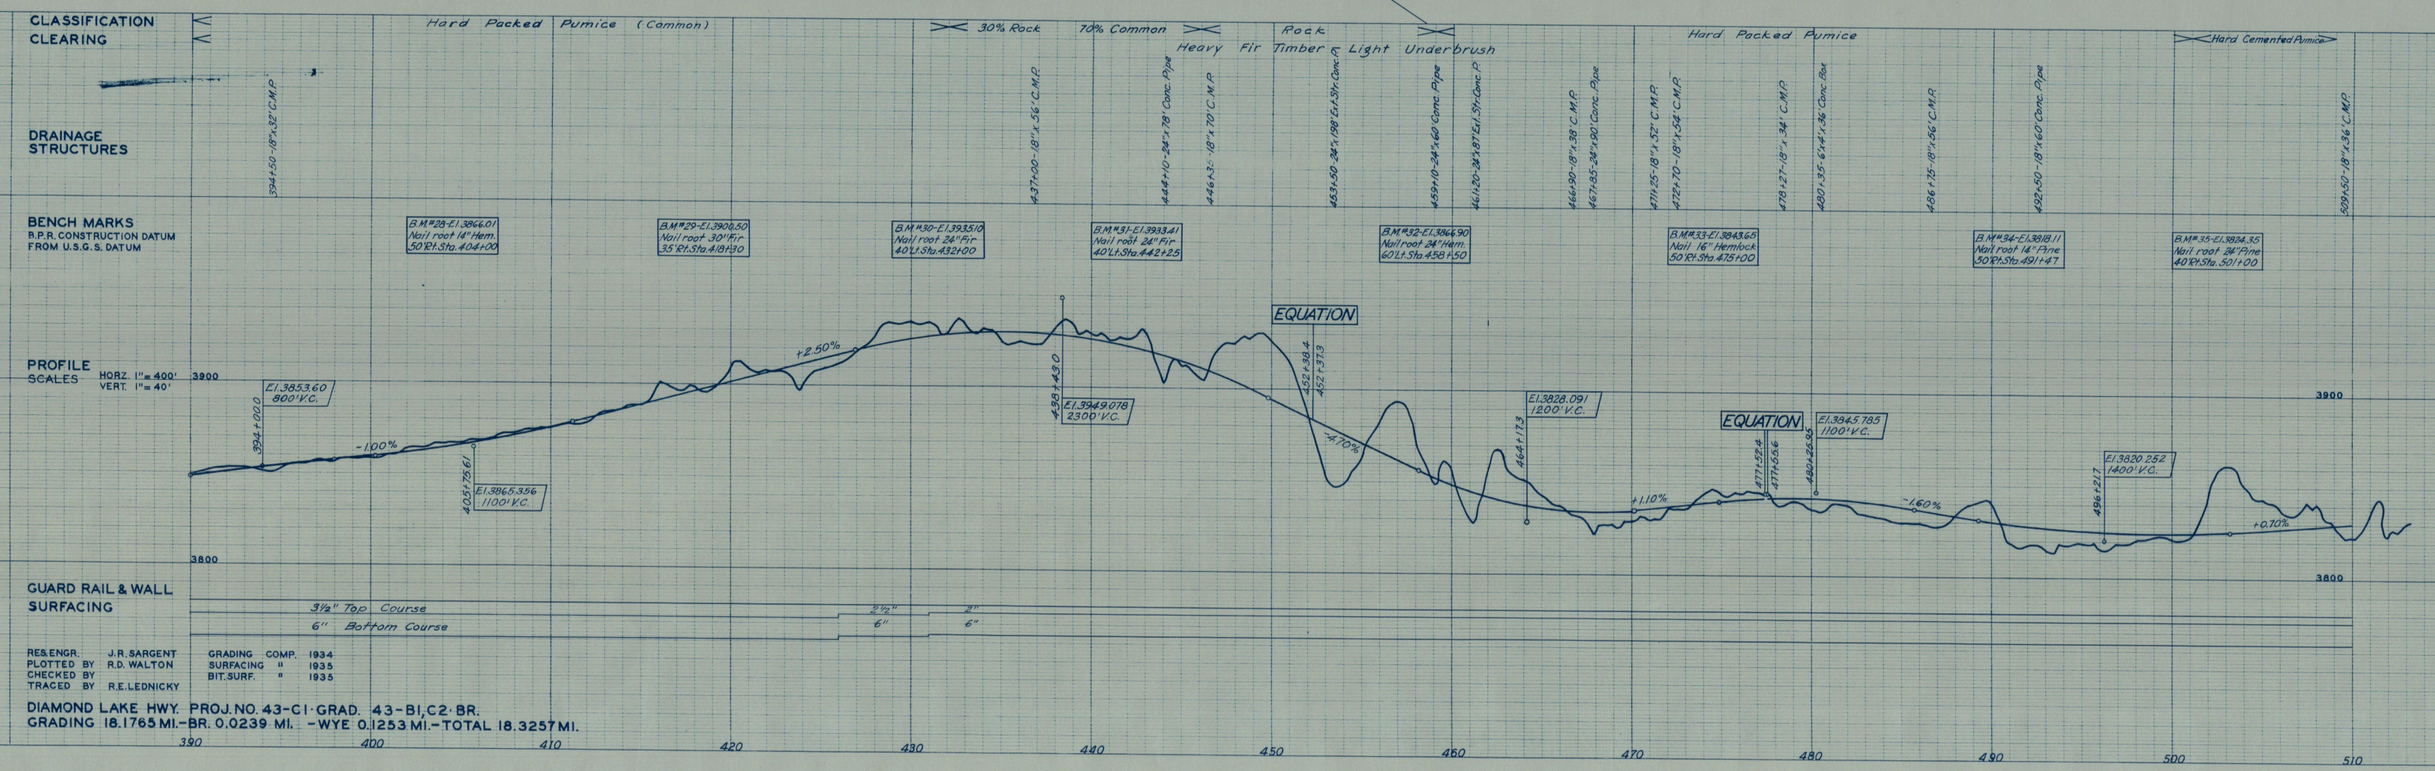

RES. ENGR. J. R. SARGENT
PLOTTED BY R. D. WALTON
CHECKED BY
TRACED BY R. E. LEDNICKY

GRADING COMP. 1934
SURFACING " 1935
BIT. SURF. " 1935

DIAMOND LAKE HWY. PROJ. NO. 43-C1 · GRAD. 43-B1, C2 · BR.
GRADING 18.1765 MI. - BR. 0.0239 MI. - WYE 0.1253 MI. - TOTAL 18.3257 MI.