U. S. DEPARTMENT OF AGRICULTURE
BUREAU OF PUBLIC ROADS-DIST. NO. 1
Diamond Lake Hwy.
NATIONAL FOREST ROAD
Grading
STATE Oregon WIDTH 22'

PROJECT No. 43-C1
SHEET No.
Total Sheets

1932 Std.

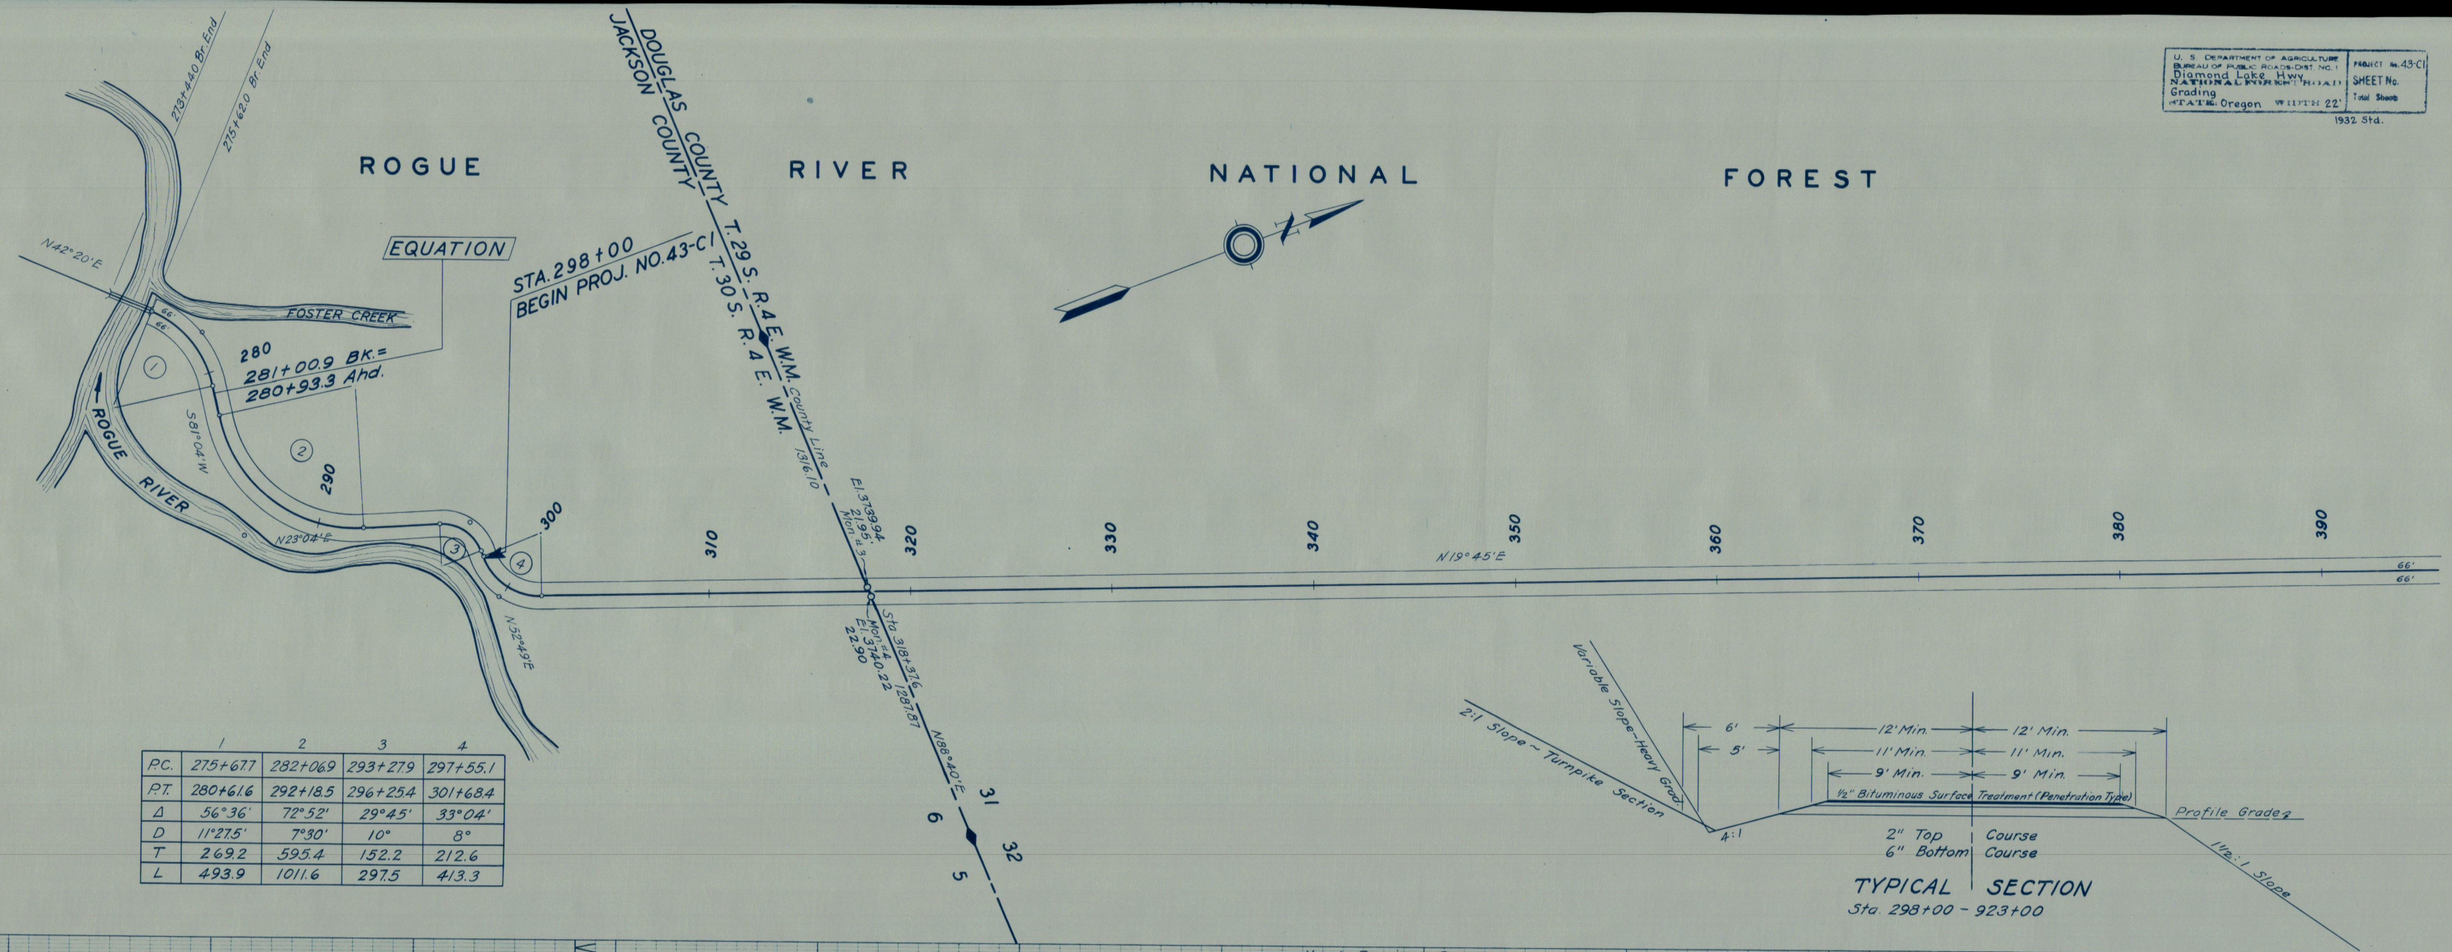

	1	2	3	4
P.C.	275+67.7	282+06.9	293+27.9	297+55.1
P.T.	280+61.6	292+18.5	296+25.4	301+68.4
Δ	56°36'	72°52'	29°45'	33°04'
D	11°27.5'	7°30'	10°	8°
T	269.2	595.4	152.2	212.6
L	493.9	1011.6	297.5	413.3

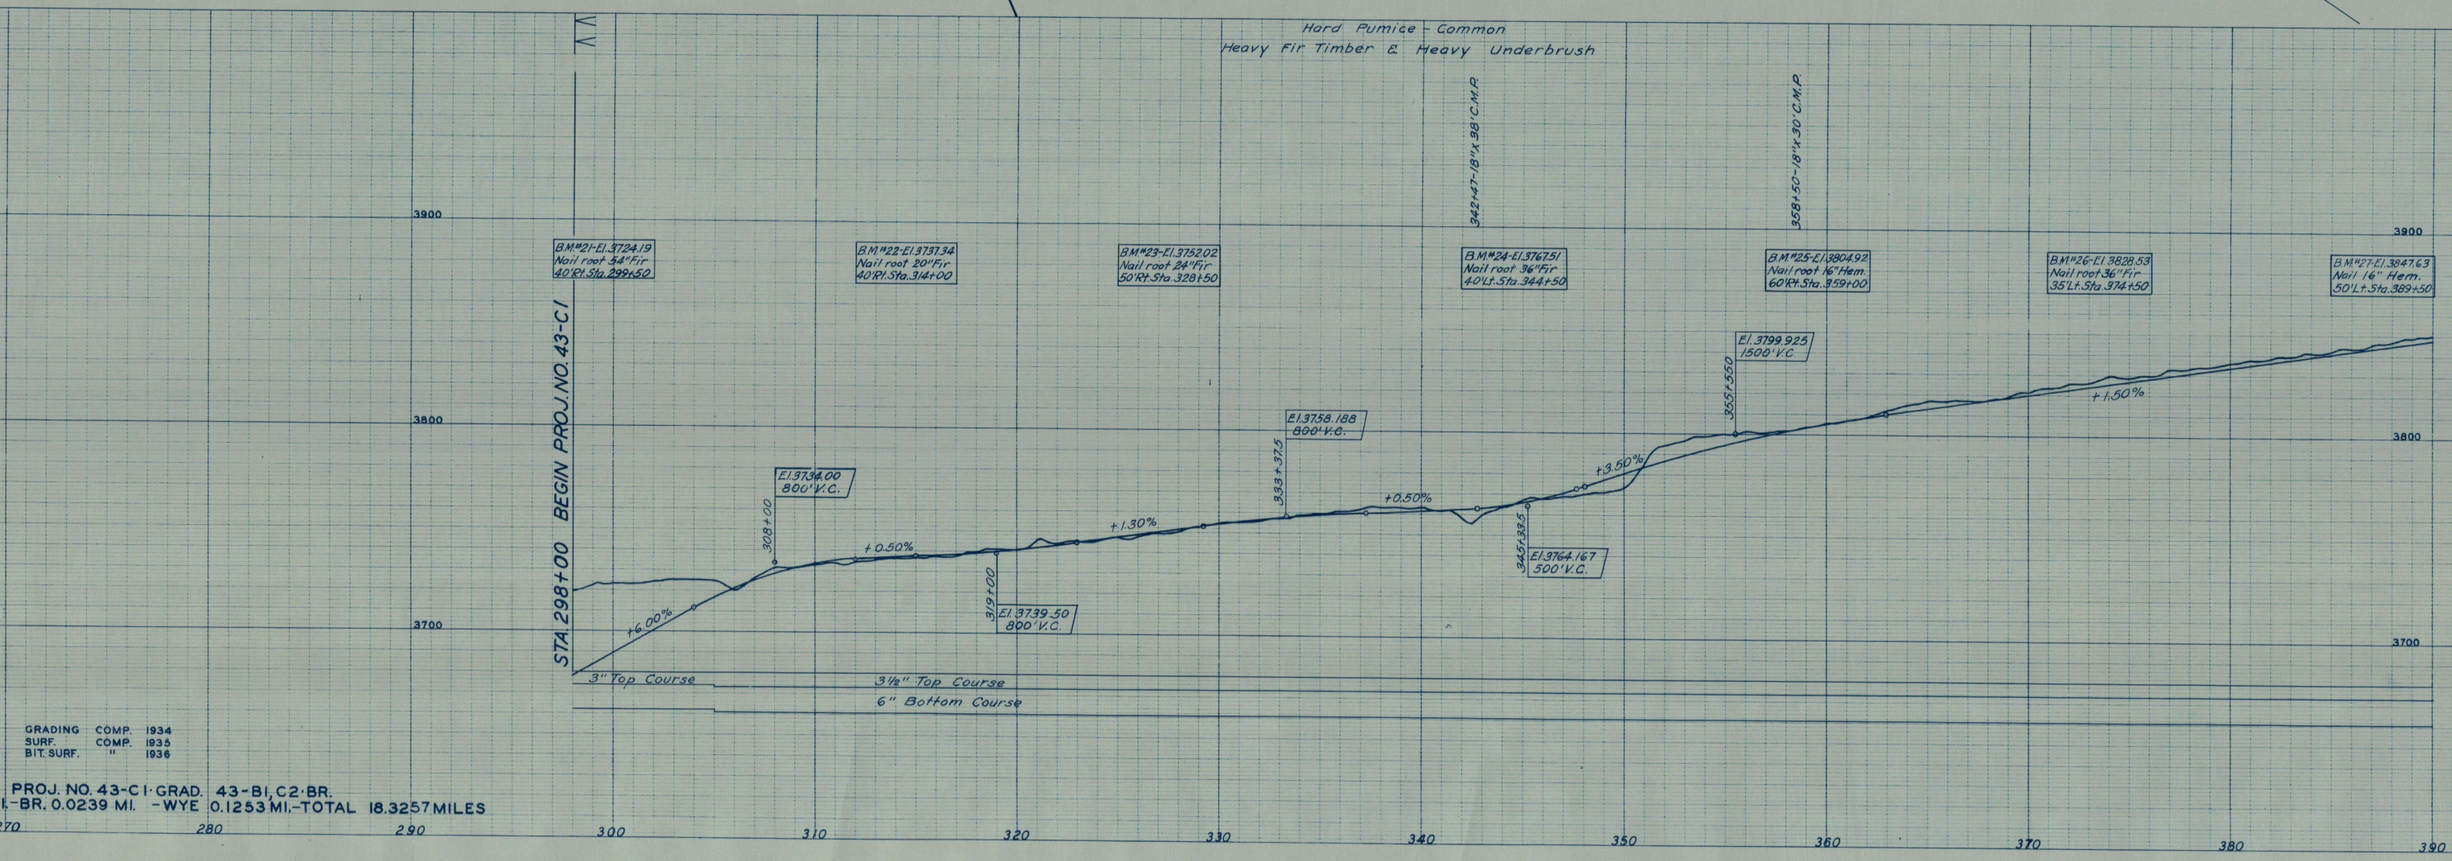

GRADING COMP. 1934
SURF. COMP. 1935
BIT. SURF. " 1936

PROJ. NO. 43-C1 GRAD. 43-B1, C2 BR.
I.-BR. 0.0239 MI. -WYE 0.1253 MI.-TOTAL 18.3257 MILES