OREGON STATE HIGHWAY DEPARTMENT

Constructed Line

CAMAS MOUNTAIN-WINSTON SECTION

COOS BAY – ROSEBURG HIGHWAY

DOUGLAS COUNTY

Scale: 1 inch = 100 feet

Traced by W.M.D. Sept. 7, 1948

PART 1 OF 2 PARTS

DRG. NO. 6B-28-21

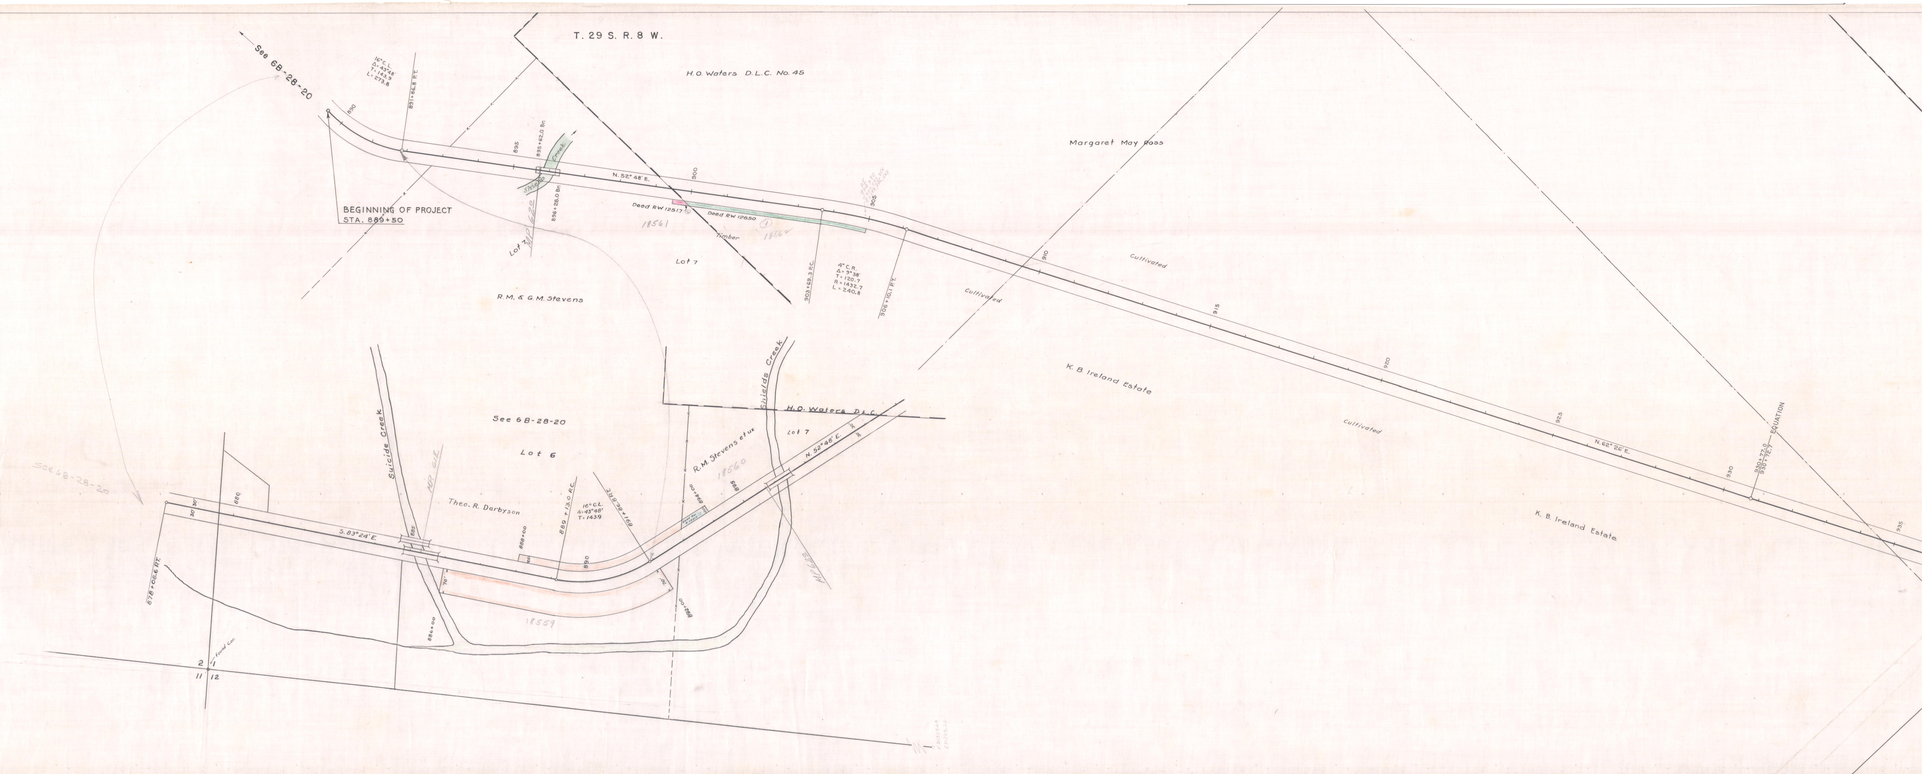

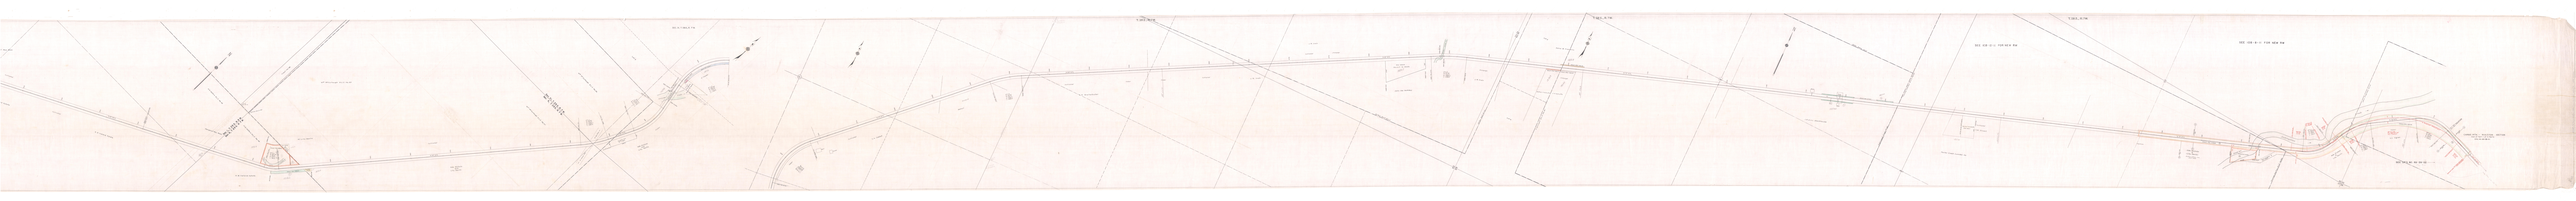
SEE DWG 0-1 FOR NEW RW
SEE DWG 0-1 FOR NEW RW
DETAILS IN DWG 0-2