OREGON STATE HIGHWAY DEPARTMENT

Located Line

WINCHESTER - SHADY POINT SECTION

PACIFIC HIGHWAY

DOUGLAS COUNTY

Scale: 1 inch = 100 feet

Traced by M.S. May, 1951

Rev. June, 1990
July, 1990
March, 2006 pjm

(Part 1 of 3 Parts)
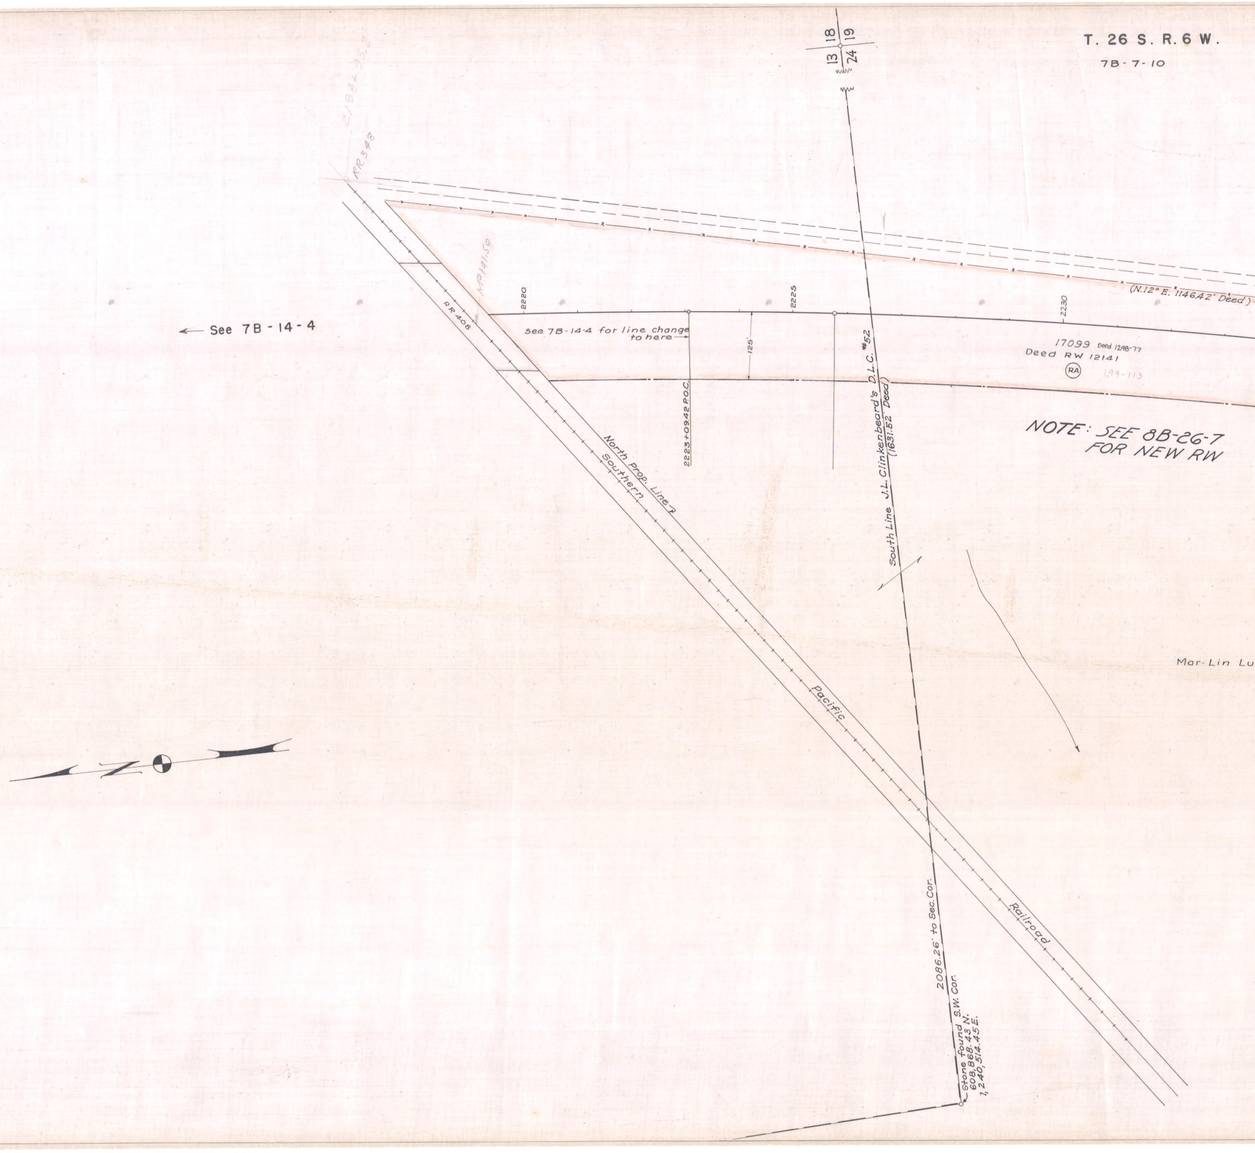
DRG. NO. 7B-7-10