OREGON STATE HIGHWAY DEPARTMENT

Located Line

CANYONVILLE - DAYS CREEK SECTION, W. UNIT

TILLER - TRAIL HIGHWAY

DOUGLAS COUNTY

Scale: 1 inch = 100 feet

Traced by H.K.E. June, 1952

TRUE BEARINGS

DRG. NO. 7B-13-18

Revised March 1956

SEE RW. MAPS FOR RECORDING OF FINAL COUNTY ROAD

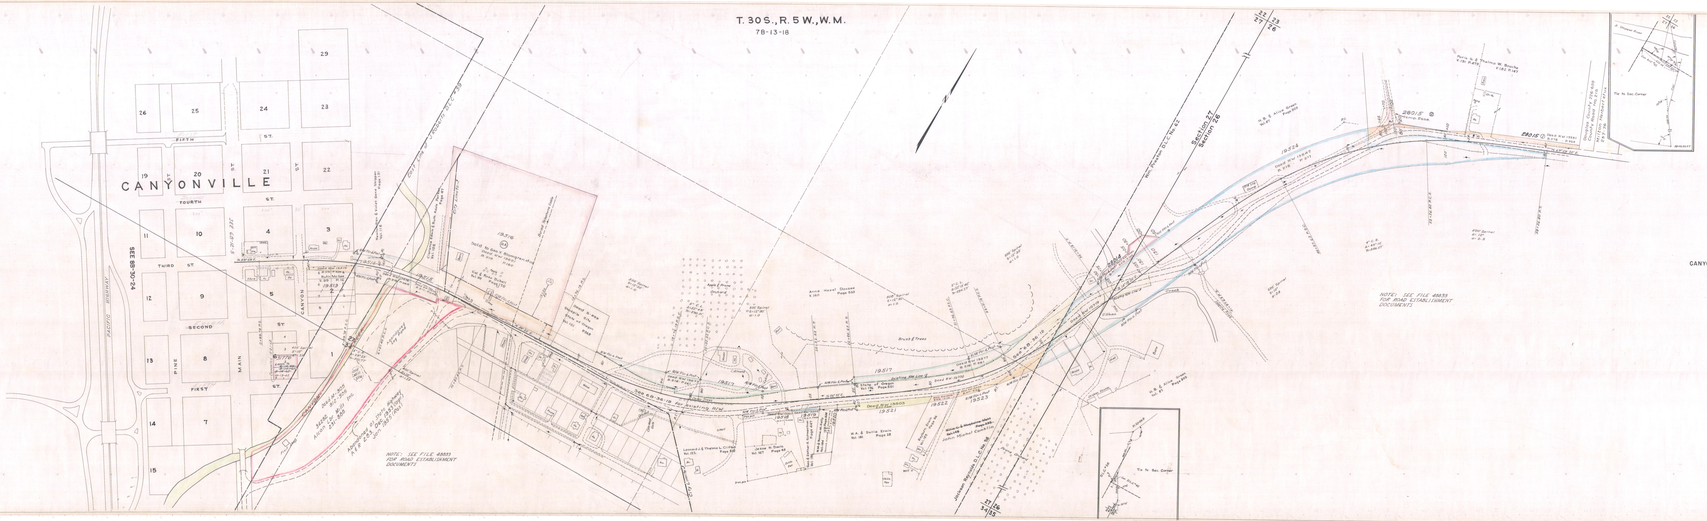
T. 30 S., R. 5 W., W.M.
7B-13-18
CANYONVILLE
FIRST
SECOND
THIRD
FOURTH
FIFTH
MAIN
PACIFIC HIGHWAY
P.C. 00+00.335
P.T. 23+00.335
Sections 27 Section 26
Section 34 Section 35
