OREGON STATE HIGHWAY DEPARTMENT

CONSTRUCTED LINE

# LONE ROCK BRIDGE - ROCK CREEK SECTION

NORTH UMPQUA HIGHWAY

DOUGLAS COUNTY

STATION 951+60 TO 1162+79.13

SCALE 1"=100' AUGUST 1933

CLAY M. CORNETT RES. ENGR.
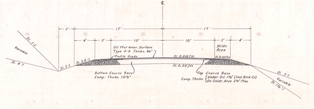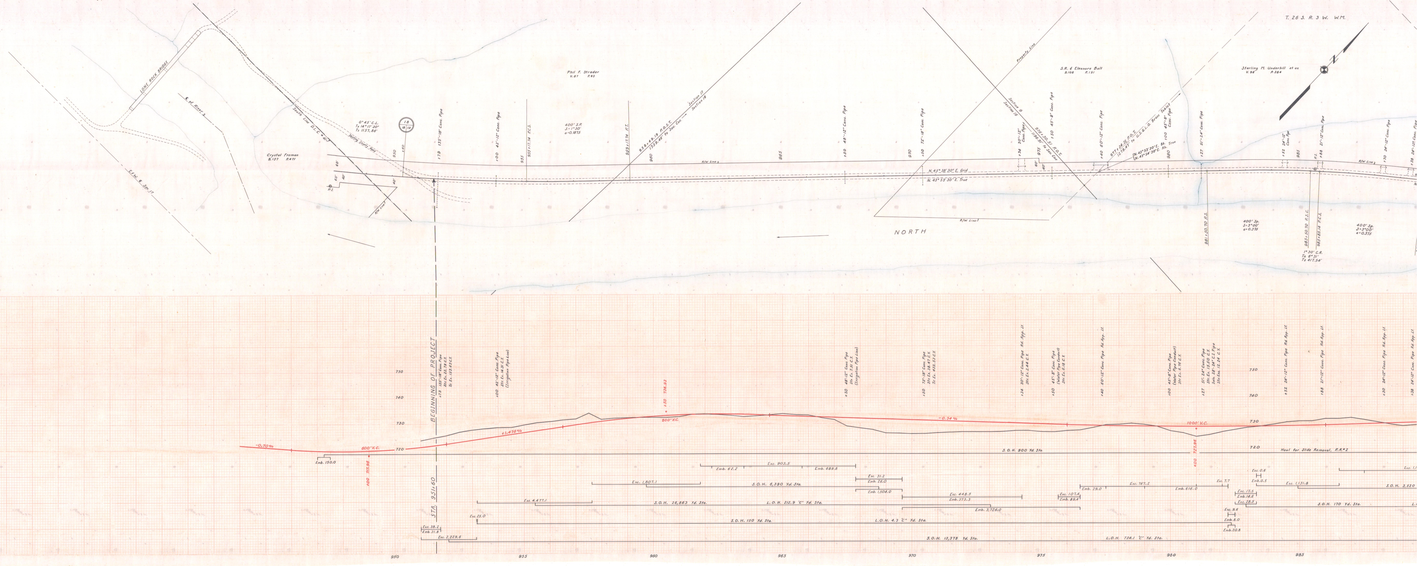
TYPICAL SECTION