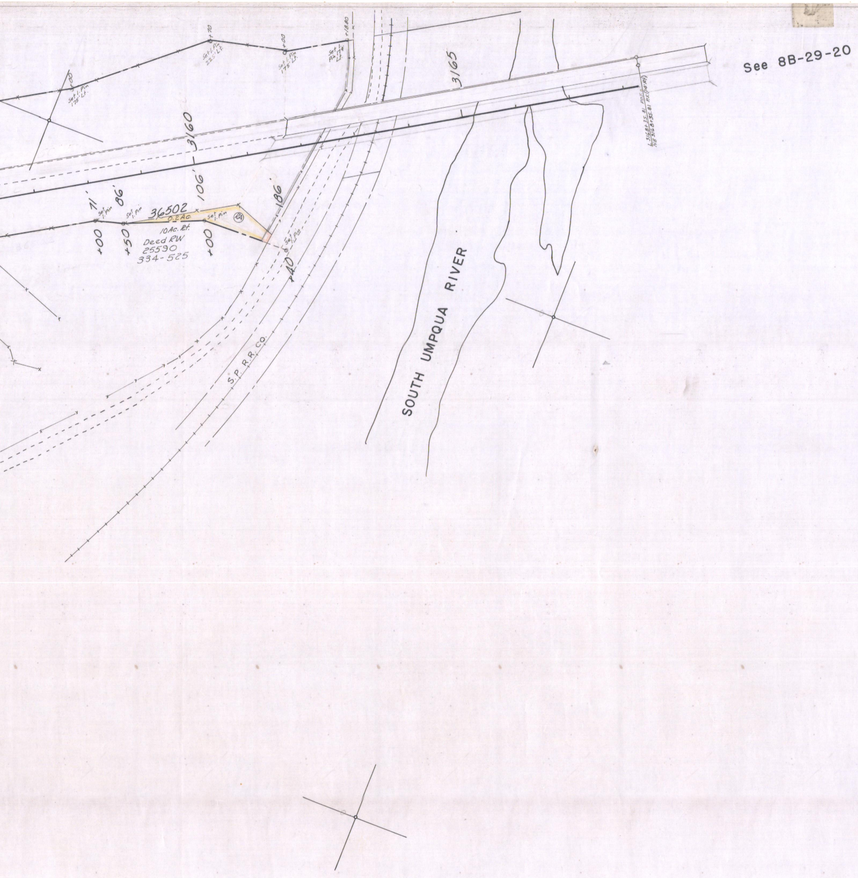

ROBERTS MOUNTAIN - MYRTLE CREEK SECTION

PACIFIC HIGHWAY

DOUGLAS COUNTY

SCALE: 1" = 100'

PART 1 of 2 PARTS

AUGUST, 1963

DRG. NO. 8B-29-3

Rev 1979
" 1982