OREGON STATE HIGHWAY DEPARTMENT

Constructed Line

RICE HILL – CHENOWETH PARK SECTION

PACIFIC HIGHWAY

DOUGLAS COUNTY

Scale 1" = 400'

Drawn by L.E.K. Sept. / 1933

GRID BEARINGS - NORTH ZONE
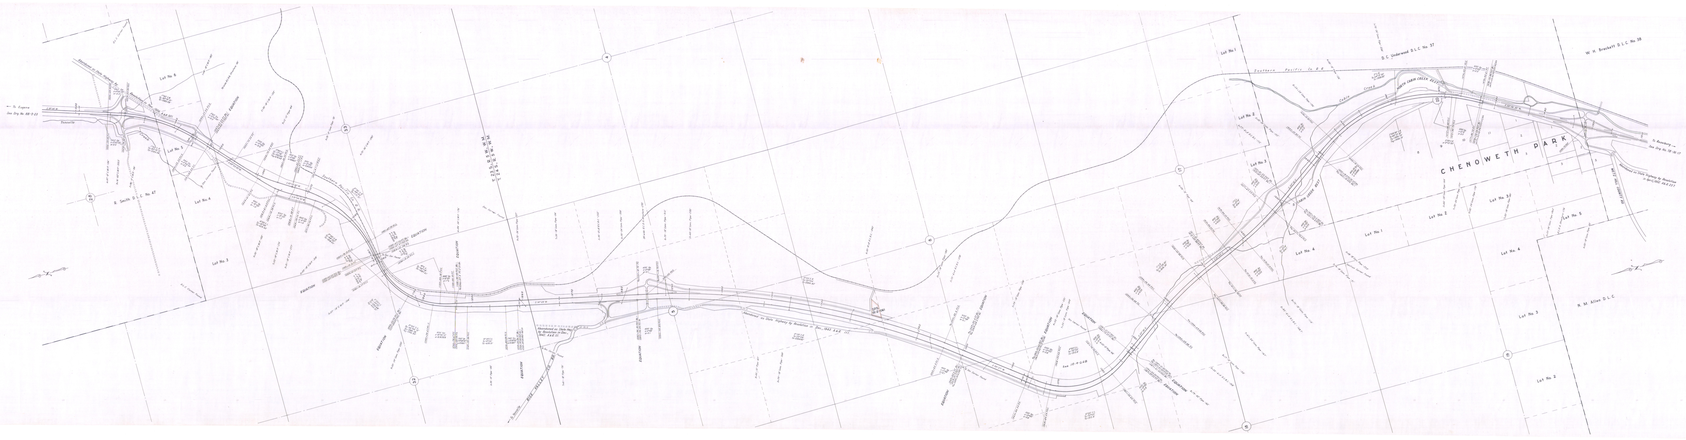
DRG. NO. 88-33-19