Recd 1/1/01 JA

P.9 B

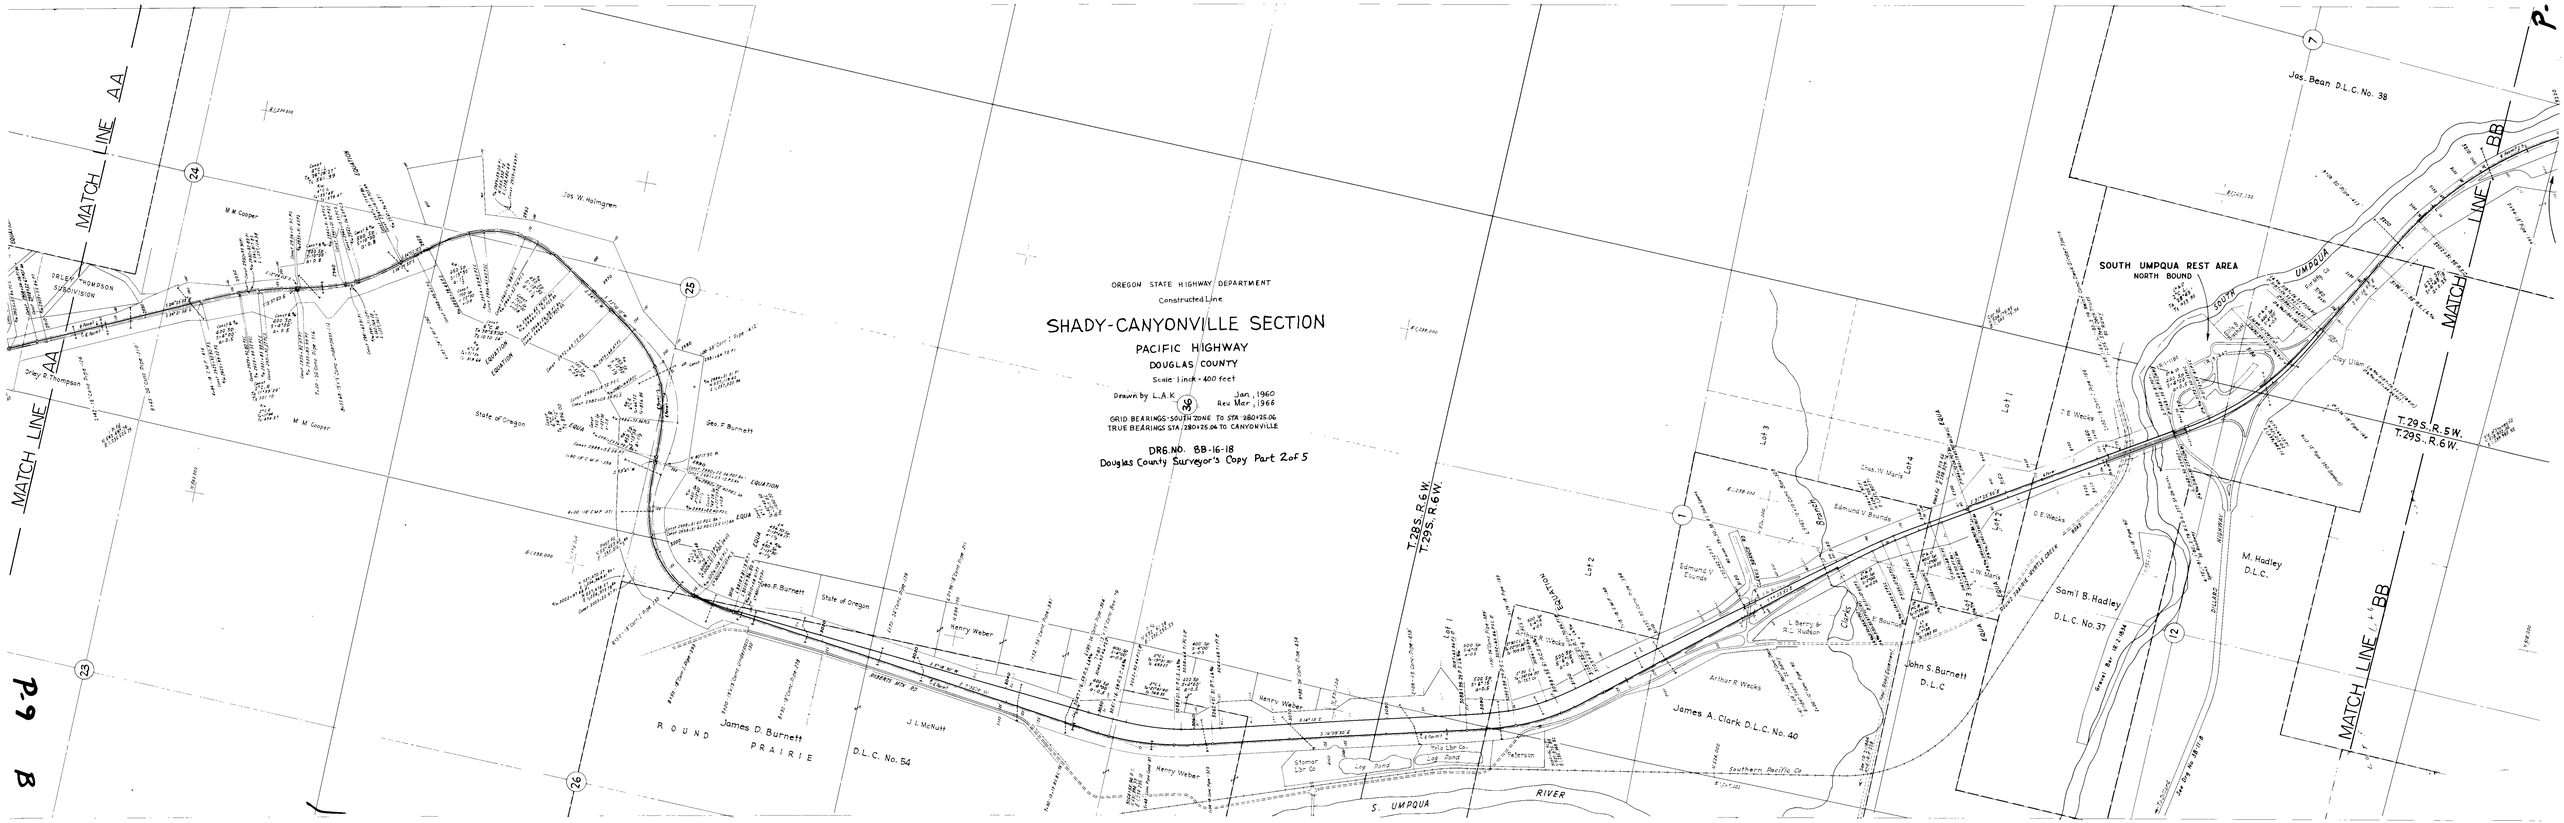

P.9 B