Rec'd 1/7/91 JR

P-9 C.

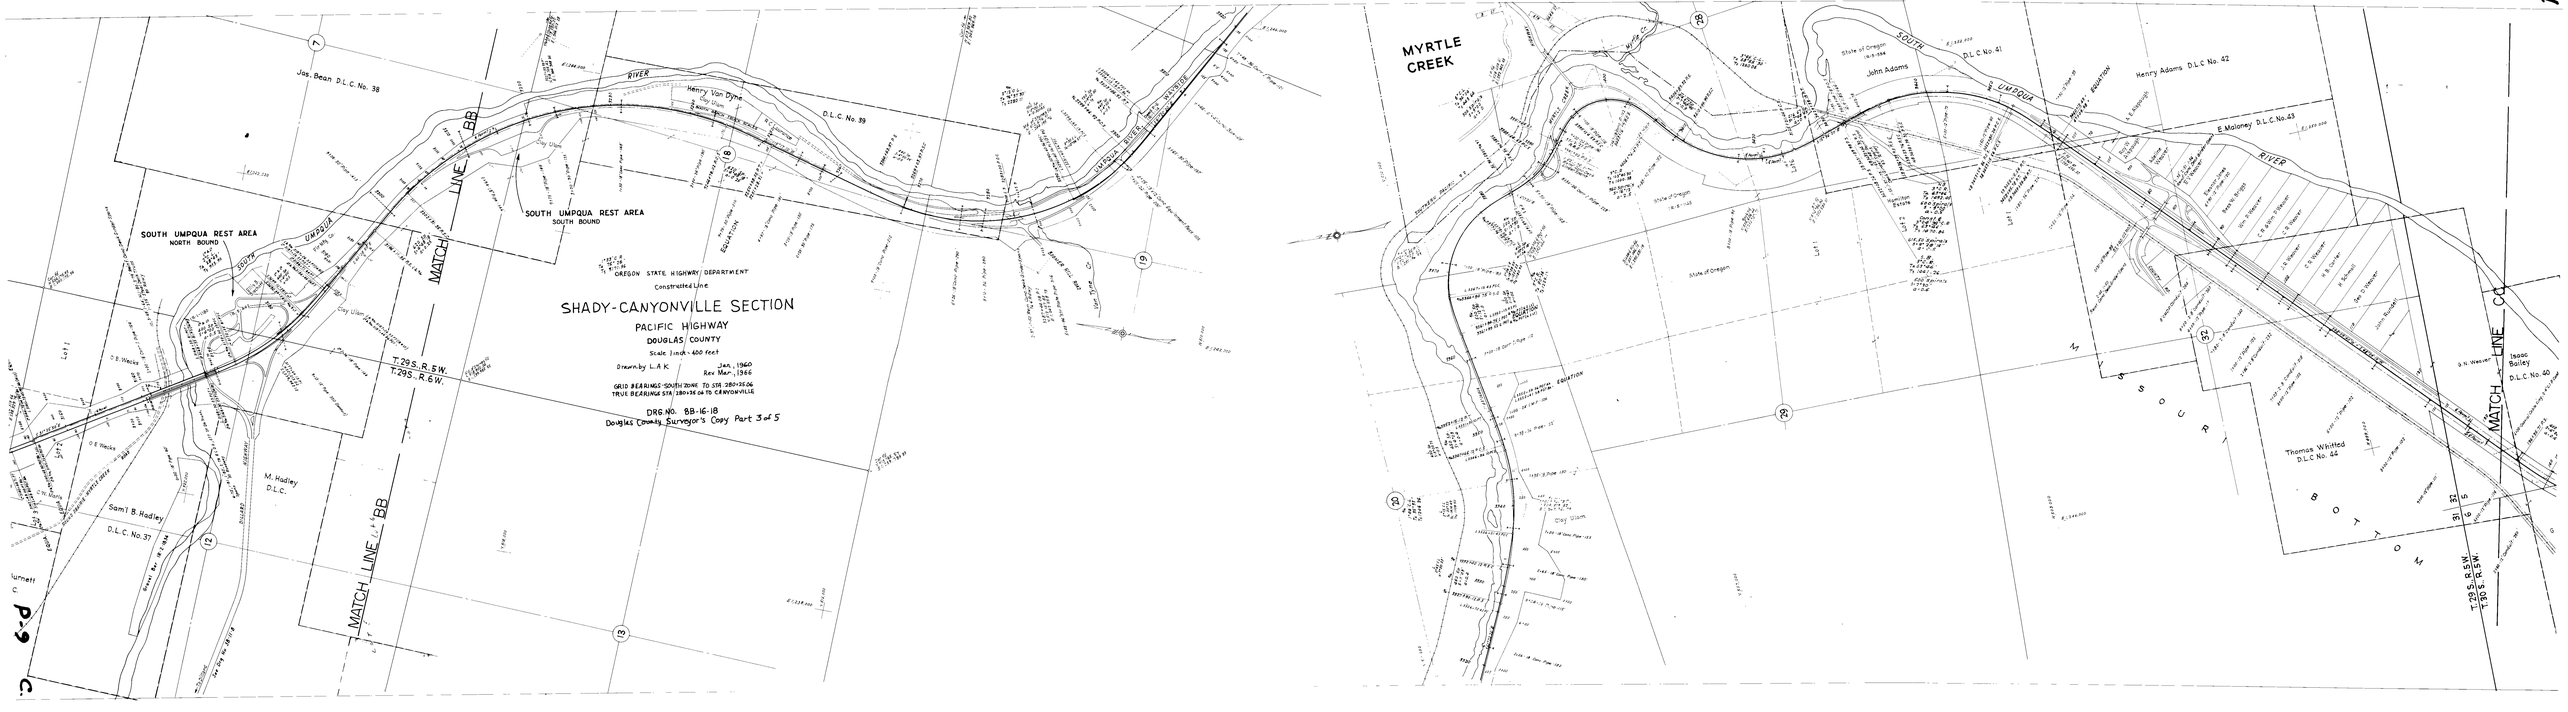

P-9 C.