Rec'd 1/7/91 DP

P-9 D.

OREGON STATE HIGHWAY DEPARTMENT

Constructed Line

# SHADY-CANYONVILLE SECTION

PACIFIC HIGHWAY

DOUGLAS COUNTY

Scale: 1 inch = 400 feet

Drawn by L. A. K. Jan., 1960
Rev Mar., 1966

GRID BEARINGS-SOUTH ZONE TO STA. 280+25.06
TRUE BEARINGS STA 280+25.06 TO CANYONVILLE
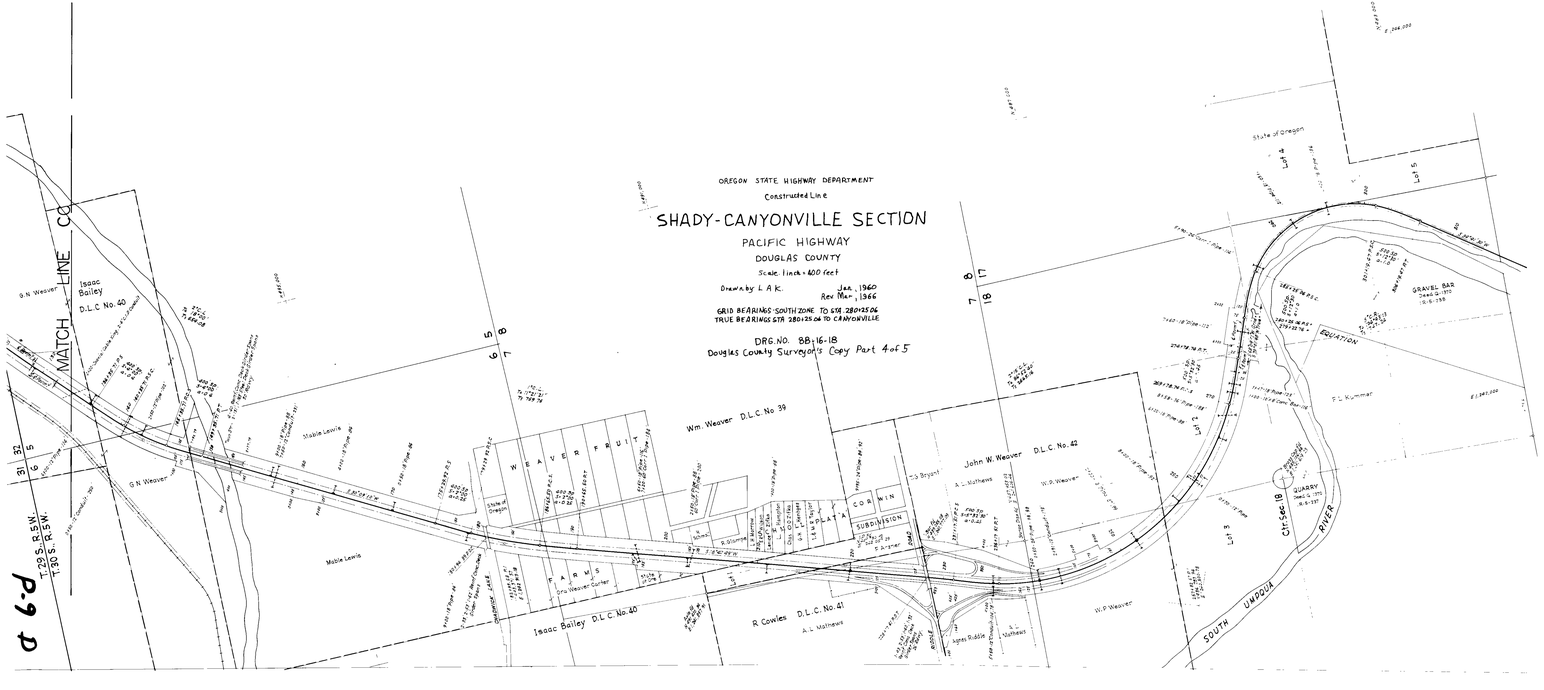
DRG. NO. BB-16-18
Douglas County Surveyor's Copy Part 4 of 5