OREGON STATE HIGHWAY DEPARTMENT

Located Line

ROBERTS MOUNTAIN-MYRTLE CREEK SECTION

PACIFIC HIGHWAY

DOUGLAS COUNTY

Scale: 1 inch = 100 feet

Traced by M.L.J. Aug. 1963
Survey Computed 9-16-67
Revised Mar. 1979 Revised Apr. 1979
Revised Jul. 1985
Revised Nov. 1983 - Nov. 1986

GRID BEARINGS-SOUTH ZONE

PART I OF 2 PARTS

DRG. NO. 8B-29-3

Access Control Line _____ _ _____

SEE 7B-24-12
AND 7B-25-10
FOR PRIOR RW

● Set I Pin Indicates - Set 5/8" Iron Pin & Stamped RW Guard Post
△ Set Mon Indicates - Set Concrete Monument With Brass Disc.
Submitted to County 9-19-67

For Monuments Set From Nov. 1983 To Nov. 1986 See Field Book No. 2857
● Set Rod Indicates - Set 5/8" x 30" Iron Rod with Alum. Cap (Punched), or Red Plastic Cap
△ Highway Centerline Control Point - 1/4A Stationing - NO MONUMENT SET
● Found Monument - As Noted

NARRATIVE DOCUMENT FILED SEPARATELY

O.S.H.D.
P.O.BOX 1128
ROSEBURG, OREGON 97470

Page 1 of 5

REGISTERED PROFESSIONAL LAND SURVEYOR
OREGON
JULY 13, 1967
JERRY L. MILLER
1396

FILED
MAY 5 1988
COUNTY SURVEYOR
DOUGLAS COUNTY, ORE.

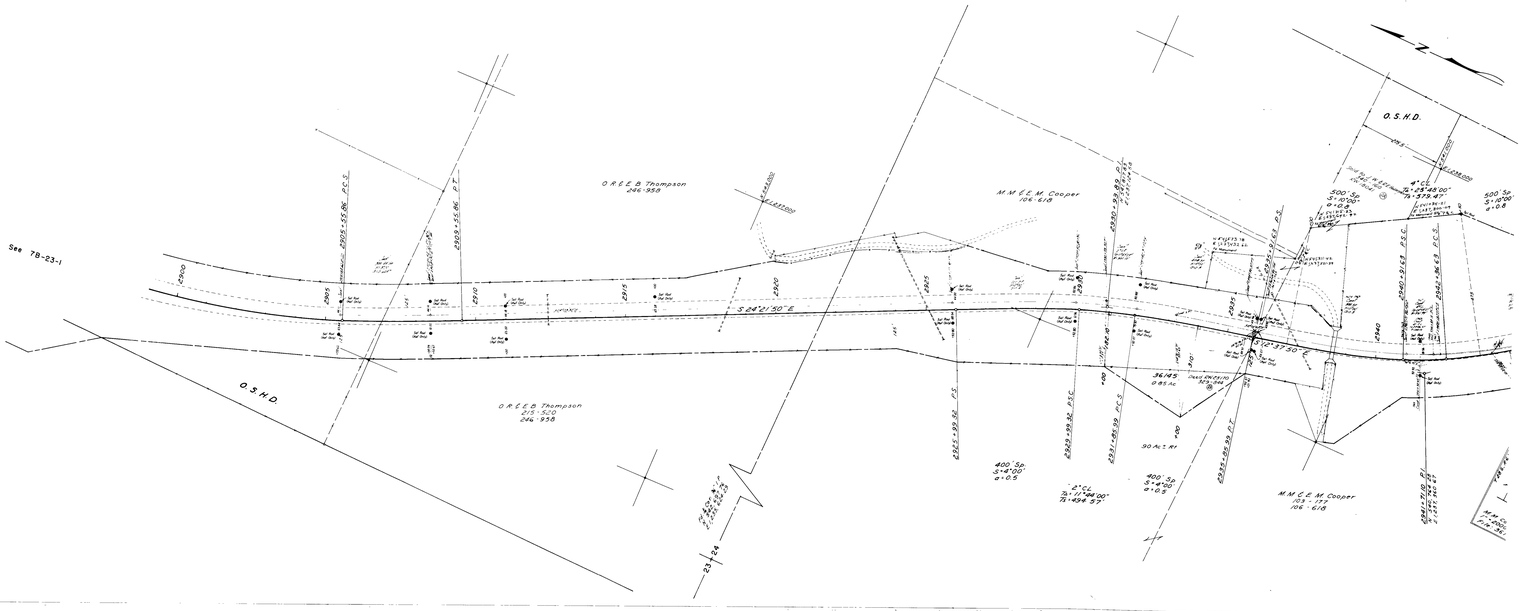
See 7B-23-1
O.S.H.D.
O.R.E.B. Thompson
246-938
O.R.E.B. Thompson
323-520
246-938
M.M.E.M. Cooper
106-618
M.M.E.M. Cooper
103-178
106-618
S 24°21'50" E
S 24°37'50" E
36.45
0.83 ac
90 Ac. Ft.
