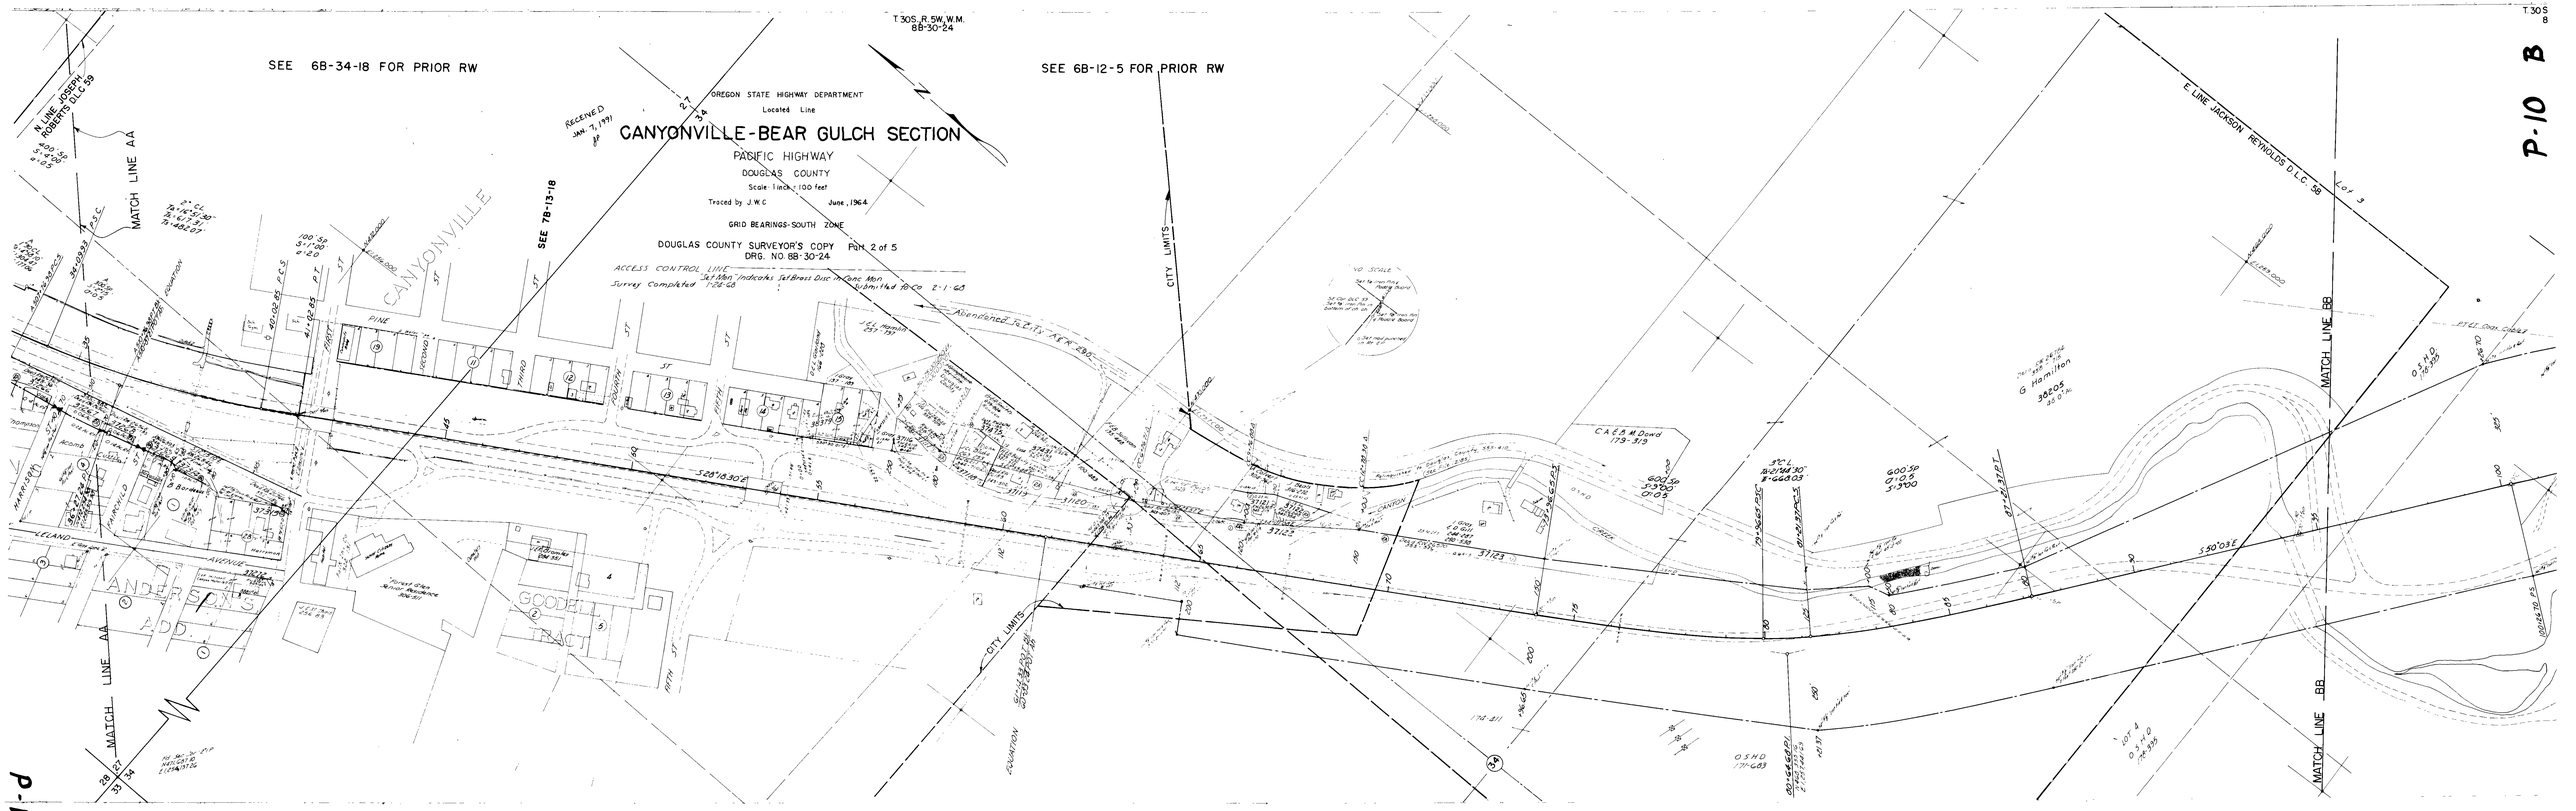
T 30S, R 5W, W.M.
88-30-24
T 30S
8
SEE 6B-34-18 FOR PRIOR RW
SEE 6B-12-5 FOR PRIOR RW
OREGON STATE HIGHWAY DEPARTMENT
Located Line
CANYONVILLE-BEAR GULCH SECTION
PACIFIC HIGHWAY
DOUGLAS COUNTY
Scale: 1 inch = 100 feet
Traced by J.W.C
June, 1964
GRID BEARINGS-SOUTH ZONE
DOUGLAS COUNTY SURVEYOR'S COPY Part 2 of 5
DRG. NO. 88-30-24
ACCESS CONTROL LINE
Set Mon. indicates Set Brass Disc in Conc. Mon.
Survey Completed 1-28-65
Submitted to Co. 2-1-65
RECEIVED
JAN. 7, 1971
N. LINE JOSEPH ROBERTS D.L.C. 59
MATCH LINE AA
SEE 7B-13-18
CANYONVILLE
PINE
FIRST
SECOND
THIRD
FOURTH
FIFTH
ST
AVENUE
LELAND
HARRISON
HAROLD
ANDERSON'S ADD.
GOODEL TRACT
CITY LIMITS
EXPIRATION
Abandoned to City
S 28°18'30" E
S 50°03'E
E LINE JACKSON REYNOLDS D.L.C. 58
Lot 3
Lot 4
MATCH LINE BB
C.A.E.B. McDowd
G. Hamilton
P-10 B

P-10 B