T.30 S., R.5W., W.M.
88-30-24

RECEIVED
JAN. 2, 1991
JP

OREGON STATE HIGHWAY DEPARTMENT
Located Line.

SEE 6B-12-5 FOR PRIOR RW

CANYONVILLE-BEAR GULCH SECTION

PACIFIC HIGHWAY
DOUGLAS COUNTY
Scale: 1 inch = 100 feet
Traced by J.W.C. June, 1964

GRID BEARINGS-SOUTH ZONE

DOUGLAS COUNTY SURVEYOR'S COPY Part 3 of 5
DRG. NO. 88-30-24

ACCESS CONTROL LINE
Survey Completed 1-26-68 Set Aluminum Indicator Set Brass Disc in Conc. Mon. Submitted to Co. 2-1-68

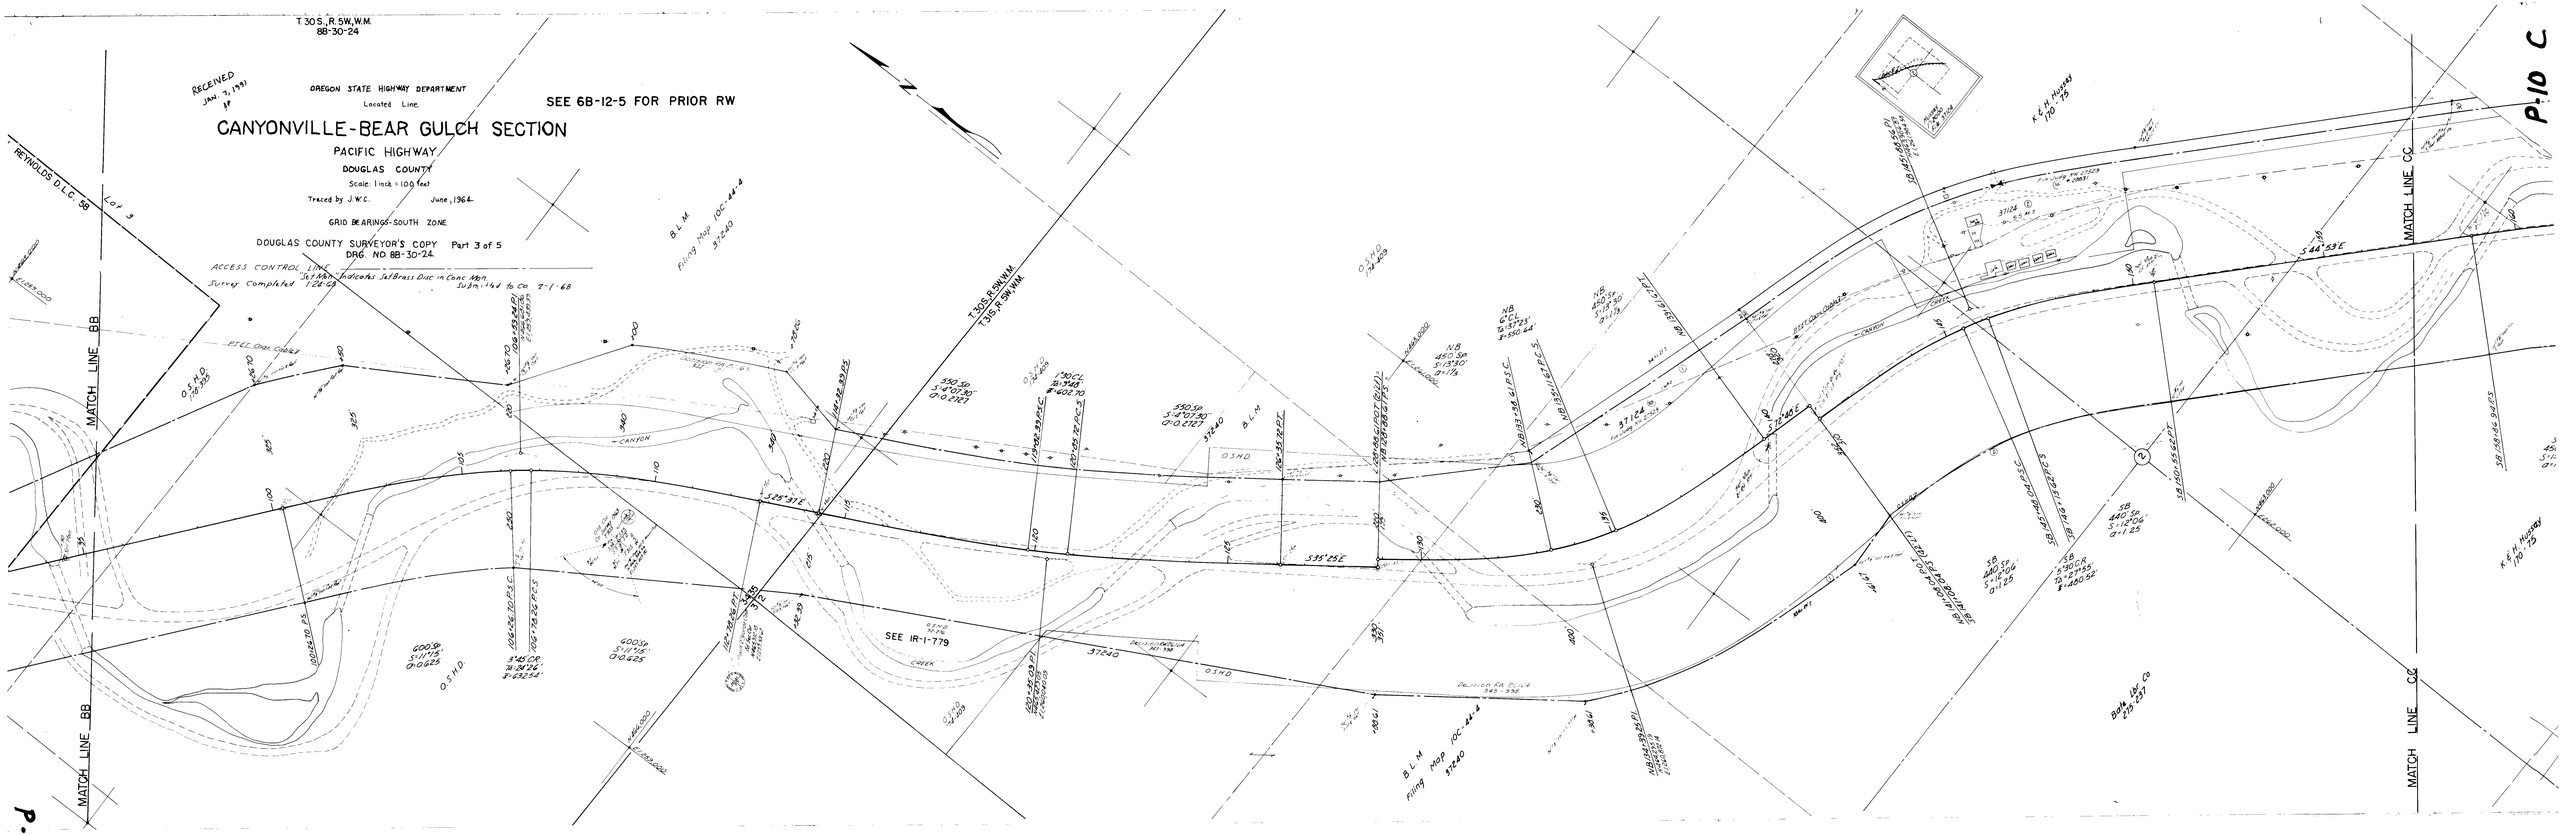

P-10 C