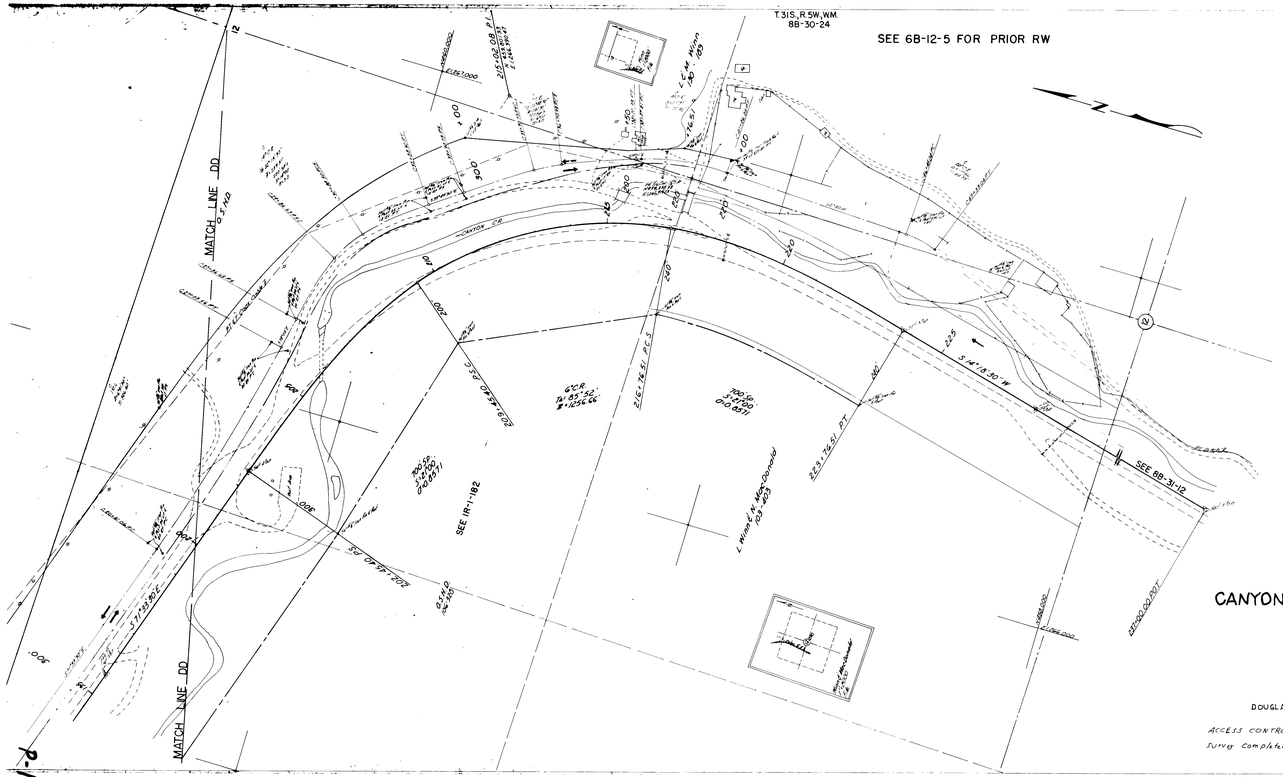

RECEIVED
JAN. 7, 1991

CANYONVILLE-BEAR GULCH SEC.
PACIFIC HWY.
DOUGLAS CO.
JUNE, 1964
1" = 100'
8B-30-24

OREGON STATE HIGHWAY DEPARTMENT

Located Line

CANYONVILLE-BEAR GULCH SECTION

PACIFIC HIGHWAY

DOUGLAS COUNTY

Scale: 1 inch = 100 feet

Traced by J.W.C. June, 1964

GRID BEARINGS-SOUTH ZONE

DOUGLAS COUNTY SURVEYOR'S COPY Part 5 of 5
DRG. NO. 8B-30-24.

ACCESS CONTROL LINE _____

"Submitted" indicates Jeff Ness Disc in Conc Mon.

Survey completed 1-24-66 Submitted to Co 2-1-68

CANYONVILLE-BEAR GULCH SEC.

PACIFIC HWY.


1:100

8B-30-24

P-10 E