OREGON DEPARTMENT OF TRANSPORTATION

Located Line

MP 59.1 SLIDE SECTION

Rev. Apr. 1999 SJS
Mar. 1999 SMW
Oct. 1999 SMW

COOS BAY - ROSEBURG HIGHWAY

DOUGLAS COUNTY

Scale: 1:500

FEBRUARY, 1999

BEARINGS: Based on Oregon Coordinate System of 1927, South Zone

COORDINATES: This drawing utilizes a Local datum Plane (LDP) which is relative to the Oregon Coordinate System of 1927 South Zone, with respect to the local latitude and ground elevation. The LDP coordinates define true ground distances. To convert the LDP coordinates to the Oregon Coordinate System Of 1927 multiply the LDP coordinates by 0.99996139

FIELD NOTES: This drawing shows the results of an Oregon Department Of Transportation (ODOT) survey. The field survey notes, book number 3642 are available from ODOT files in Salem, Oregon.

PROJECT NO. 6804

DRG. NO. 10B-13-3

SEE 1S-380 FOR RETRACEMENT SURVEY

c:\usr\projects\10047 mp 59.1 slide\10047rw.dgn 17-FEB-1999 SJS

Relative property line locations were determined with the following Douglas County Record Surveys:

SCALE 1:500

10 5 0 10 20 30 40 50
METERS

50 25 0 50 100 150
FEET

Deed Recording Information

INSERT — BASIS OF BEARING — NO SCALE

T. 29 S., R. 8 W., W.M.
DRG. NO. 10B-13-3
PROJECT NO. 6804

SEE 1A-15-45 & 1A-15-46 FOR PRIOR RW

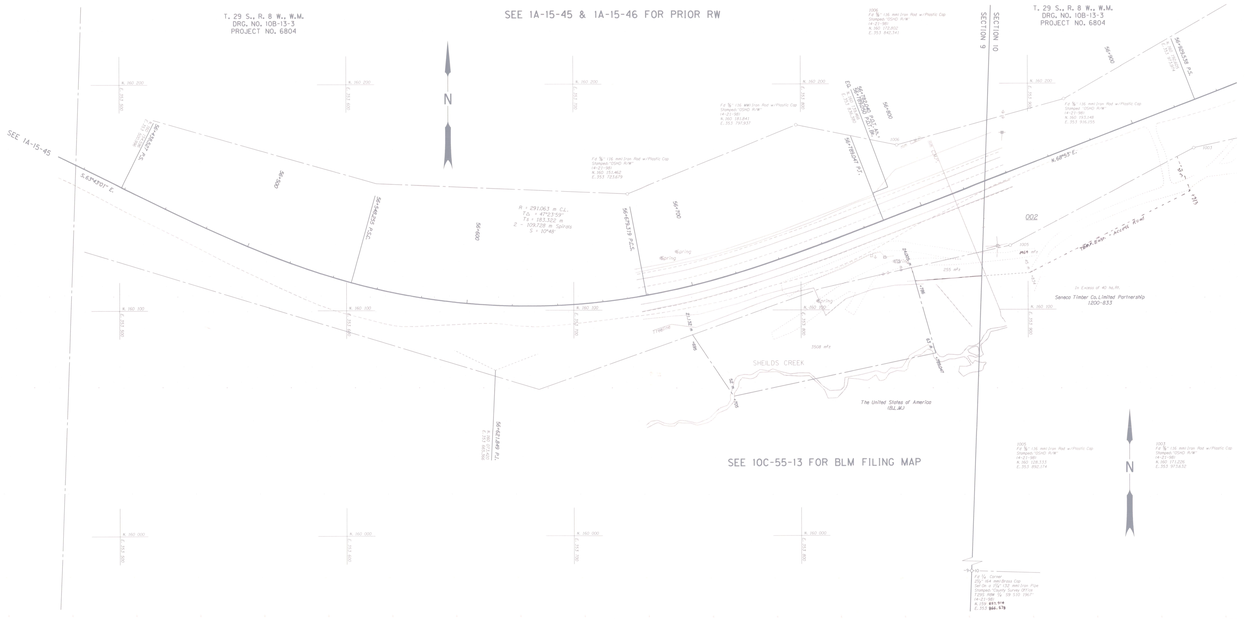

MP 59.1 SLIDE SECTION

COOS BAY - ROSEBURG HIGHWAY

DOUGLAS COUNTY

LOCATED LINE

SCALE: 1:500

DRG. NO. 10B-13-3

PROJECT NO. 6804

PLOTTED BY: SJS TIME PLOTTED: 24-FEB-1999 10:32:12 PM
DGN: 10047rw.dgn DATE: 24-FEB-1999 10:32:12 PM
COOS BAY - ROSEBURG HIGHWAY DOUGLAS COUNTY
10047rw.dgn
MP 59.1 SLIDE SECTION
BY: SJS DATE: 24-FEB-1999 10:32:12 PM