OREGON DEPARTMENT OF TRANSPORTATION
Located Line

OR138E @ RIFLE RANGE ROAD (ROSEBURG)

NORTH UMPQUA HIGHWAY

DOUGLAS COUNTY

DRAFTED BY MARSHALL WAGSTAFF, O.D.O.T., DECEMBER 2006

BEARINGS: Are based on County Survey No. St. Hwy. 138-008.

COORDINATES: This drawing utilizes a Local Datum Plane (LDP) which is relative to the Oregon Coordinate System of 1927, south zone, with respect to the local latitude and ground elevation. The LDP coordinates define true ground distances. To convert the LDP coordinates, for the control points, to the Oregon Coordinate System of 1927, south zone, multiply the LDP coordinates by 0.99987353.

FIELD NOTES: This drawing shows the results of an Oregon Department Of Transportation (ODOT) survey. The field survey notes, book number 4314, are available from ODOT files in Salem, Oregon.

DRAWING 10B-22-27
PROJECT NO. 7305

ACCESS CONTROL LINE ——— - ——— - ———

\\Scdata\r wmaps\Region3\DOUGLAS\14473_RifleRange\14473RW.dgn 12/7/2006

SCALE 1" = 50'
50 25 0 50 100 150
FEET

R/W ENGINEERING
ORIGINAL
DO NOT REMOVE FROM FILE

ACTIVE COPY
THE R/W SHOWN ON THIS MAP MAY LATER BE REVISED TO REFLECT NEW OR PENDING CHANGES OR OTHER NEEDS
RIGHT OF WAY ENGINEERING

REVISION HISTORY

DATE	NAME	DESCRIPTION

SEC. 20, T. 27 S., R. 5 W., W.M.
DRAWING 10B-22-27
PROJECT NO. 7305

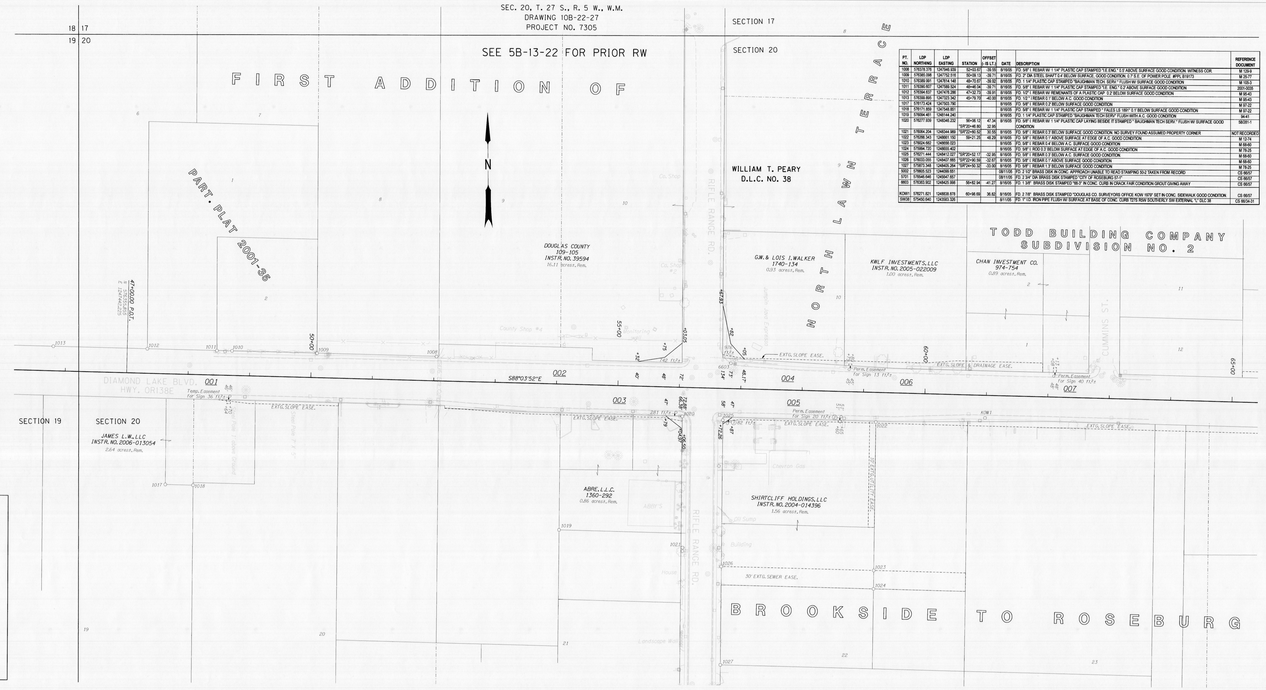

PT. NO.	LDP NORTHING	LDP EASTING	STATION	OFFSET (L.&R.)	DATE	DESCRIPTION	REFERENCE DOCUMENT

SEE COUNTY SURVEY ST. HWY. 138-008 FOR HORIZONTAL CONTROL, RECOVERY, AND RETRACEMENT SURVEY

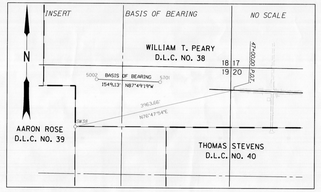

OR138E @ RIFLE RANGE ROAD (ROSEBURG)

NORTH UMPQUA HIGHWAY

DOUGLAS COUNTY

LOCATED LINE

SCALE 1" = 50'

DRAWING 10B-22-27

PROJECT NO. 7305

ACTIVE COPY
THE R/W SHOWN ON THIS MAP MAY LATER BE REVISED TO REFLECT NEW OR PENDING CHANGES OR OTHER NEEDS
RIGHT OF WAY ENGINEERING

R/W ENGINEERING
ORIGINAL
DO NOT REMOVE FROM FILE

OR138E @ RIFLE RANGE ROAD (ROSEBURG) NORTH UMPQUA HIGHWAY DOUGLAS COUNTY LOCATED LINE 2CATE 1"= 20' DRAWING 10B-22-27 MARSHALL WAGSTAFF
OR138E @ RIFLE RANGE ROAD (ROSEBURG) NORTH UMPQUA HIGHWAY DOUGLAS COUNTY LOCATED LINE SCALE 1"= 50' DRAWING 10B-22-27 PROJECT NO. 7305 DATE 12/7/2006 TIME 2:43:00 PM \\Scdata\r wmaps\Region3\DOUGLAS\14473_RifleRange\14473RW.dgn