OREGON STATE HIGHWAY DEPARTMENT

Located Line

S. DILLARD BR.-MYRTLE GROVE SECTION

DILLARD SECONDARY HIGHWAY

DOUGLAS COUNTY

Scale 1 inch = 100 feet

Traced by J.W.C. June, 1965 Revised June, 1983 March, 1985

TRUE BEARINGS

DRG. NO. 10C-44-21

Submitted to County 9-17-66

ACCESS CONTROL LINE

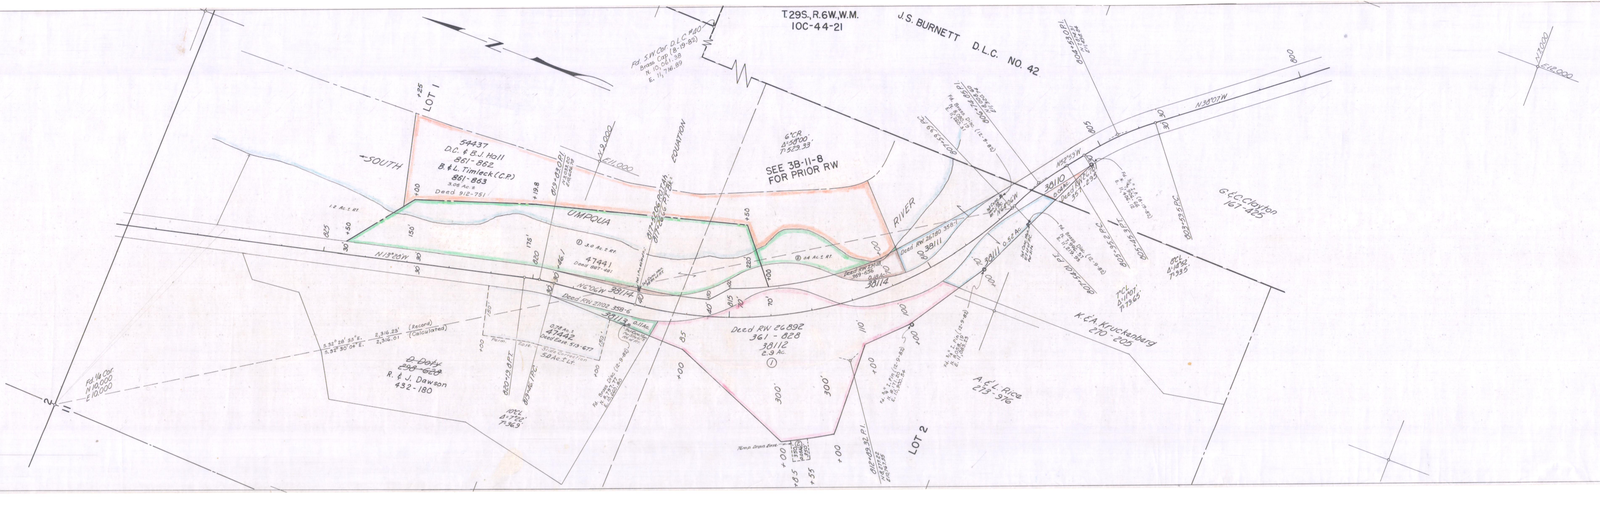

2 DILLARD BR.-MYRTLE GROVE SEC. DILLARD SEC. HWY. TOC-TIME L=100, 10C-44-21