OREGON DEPARTMENT OF TRANSPORTATION
Located Line

FOREST BOUNDARY - STEAMBOAT CREEK SECTION

NORTH UMPQUA HIGHWAY
DOUGLAS COUNTY

DRAFTED BY MICKEY CALVERT, ODOT, AUGUST, 2009

BEARINGS: Oregon Coordinate System of 1983(CORS 96 EPOCH 2002), South zone.

COORDINATES: This drawing utilizes a Local Datum Plane (LDP) which is relative to the Oregon Coordinate System of 1983(CORS 96 EPOCH 2002), South zone, with respect to the local latitude and ground elevation. The LDP coordinates define true ground distances. To convert the LDP coordinates, for the control points, to the Oregon Coordinate System of 1983(CORS 96 EPOCH 2002), South zone, multiply the LDP coordinates by 0.99984945.

FIELD NOTES: This drawing shows the results of an Oregon Department Of Transportation (ODOT) survey. The field survey notes, book number 4427, are available from ODOT files in Salem, Oregon.

DRAWING 11B-3-4 PART 1 OF 4
PROJECT NO. 6008

ACCESS CONTROL LINE —·—·—·—·—

CAD FILE NAME: 15205RW.DGN 8/20/2009

SCALE 1" = 100'
100 50 0 100 200 300
FEET

NOTE: NFSL = NATIONAL FOREST SERVICE LAND

REVISION HISTORY

DATE	NAME	DESCRIPTION

ACTIVE COPY
THE R/W SHOWN ON THIS MAP MAY LATER BE REVISED TO SUPPORT PROJECT DESIGN CHANGES OR OTHER NEEDS
RIGHT OF WAY ENGINEERING

SEE COUNTY SURVEY HWY. 138-011 FOR HORIZONTAL CONTROL AND RECOVERY SURVEY

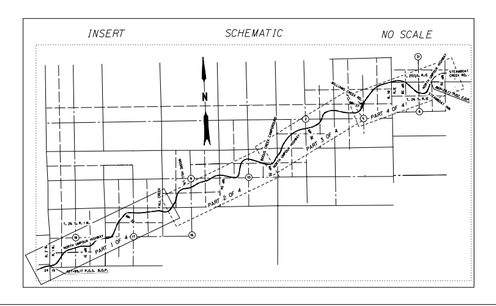
INSERT
SCHEMATIC
NO SCALE
N
PART 1 OF 4
PART 2 OF 4
PART 3 OF 4
PART 4 OF 4
NORTH UMPQUA HIGHWAY
STEAMBOAT CREEK RD.

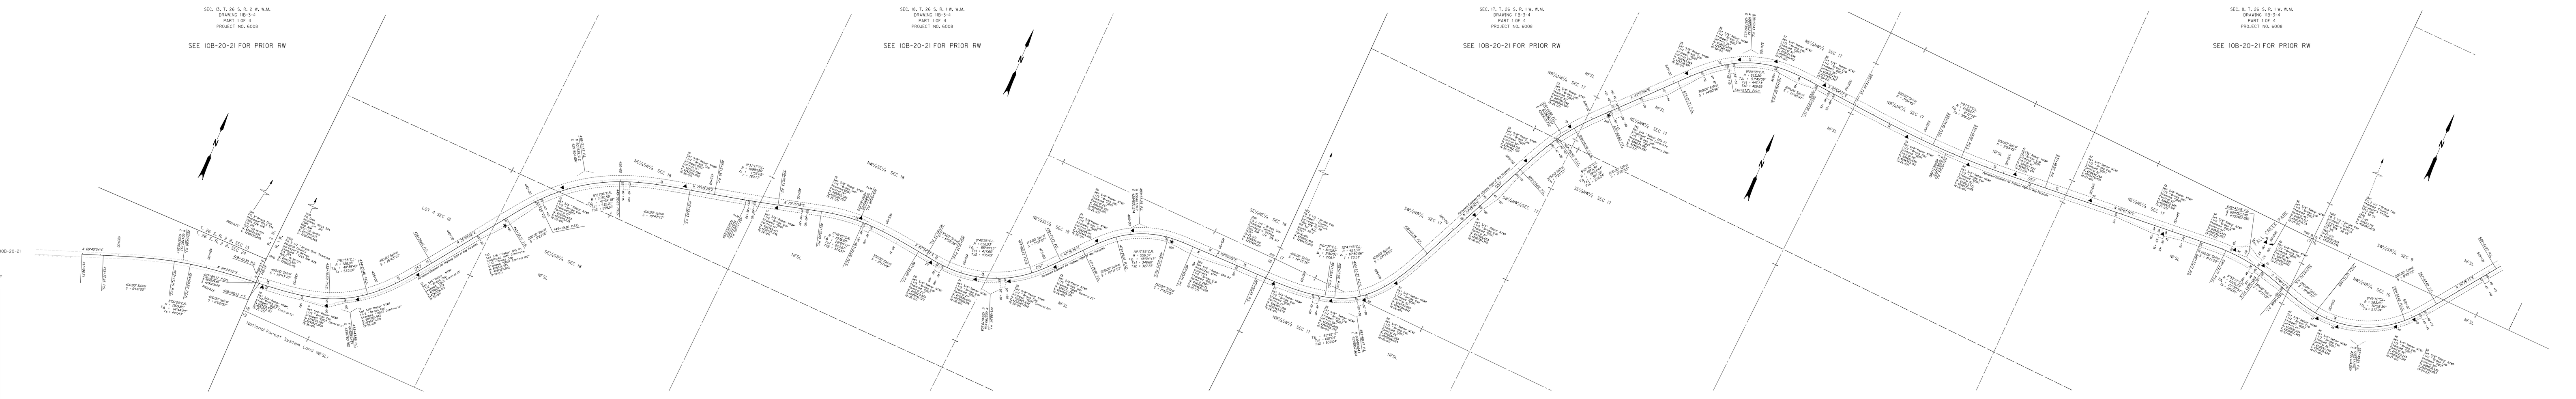
SEE 10B-20-21
SEC. 13, T. 26 S., R. 2 W., W.M.
DRAWING 11B-3-4
PART 1 OF 4
PROJECT NO. 6008
SEE 10B-20-21 FOR PRIOR RW
SEC. 18, T. 26 S., R. 1 W., W.M.
DRAWING 11B-3-4
PART 1 OF 4
PROJECT NO. 6008
SEE 10B-20-21 FOR PRIOR RW
N
LOT 4 SEC 18
NE1/4SW1/4 SEC 18
NW1/4SE1/4 SEC 18
NE1/4SE1/4 SEC 18
PRIVATE
T. 26 S., R. 2 W.
400.00' Spiral
S = 10°42'13"
5°21'06"C.R.
R = 1070.59'
N 77°09'20"E
N 75°16'18"E

FOREST BOUNDARY - STEAMBOAT CREEK SECTION
NORTH UMPQUA HIGHWAY
DOUGLAS COUNTY
LOCATED LINE
SCALE 1" = 100'
DRAWING 11B-3-4 PART 1 OF 4
PROJECT NO. 6008

FOREST BOUNDARY - STEAMBOAT CREEK SECTION NORTH UMPQUA HIGHWAY DOUGLAS COUNTY LOCATED LINE SCALE 1" = 100' DRAWING 11B-3-4 PART 1 OF 4 PROJECT NO. 6008

OREGON DEPARTMENT OF TRANSPORTATION
Located Line

FOREST BOUNDARY - STEAMBOAT CREEK SECTION

NORTH UMPQUA HIGHWAY
DOUGLAS COUNTY

DRAFTED BY MICKEY CALVERT, ODOT, AUGUST, 2009

BEARINGS: Oregon Coordinate System of 1983(CORS 96 EPOCH 2002), South zone.

COORDINATES: This drawing utilizes a Local Datum Plane (LDP) which is relative to the Oregon Coordinate System of 1983(CORS 96 EPOCH 2002), South zone, with respect to the local latitude and ground elevation. The LDP coordinates define true ground distances. To convert the LDP coordinates, for the control points, to the Oregon Coordinate System of 1983(CORS 96 EPOCH 2002), South zone, multiply the LDP coordinates by 0.99984945.

FIELD NOTES: This drawing shows the results of an Oregon Department Of Transportation (ODOT) survey. The field survey notes, book number 4427, are available from ODOT files in Salem, Oregon.

DRAWING 11B-3-4 PART 2 OF 4
PROJECT NO. 6008

ACCESS CONTROL LINE —·—·—·—·—

CAD FILE NAME: 15205RW.DGN 8/20/2009

SCALE 1" = 100'
100 50 0 100 200 300
FEET

NOTE: NFSL = NATIONAL FOREST SERVICE LAND

REVISION HISTORY

DATE	NAME	DESCRIPTION

ACTIVE COPY
THE R/W SHOWN ON THIS MAP MAY LATER BE REVISED TO SUPPORT PROJECT DESIGN CHANGES OR OTHER NEEDS
RIGHT OF WAY ENGINEERING

SEE COUNTY SURVEY HWY. 138-011 FOR HORIZONTAL CONTROL AND RECOVERY SURVEY

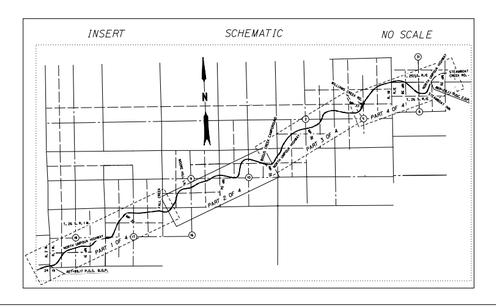
INSERT
SCHEMATIC
NO SCALE
N
PART 1 OF 4
PART 2 OF 4
PART 3 OF 4
PART 4 OF 4

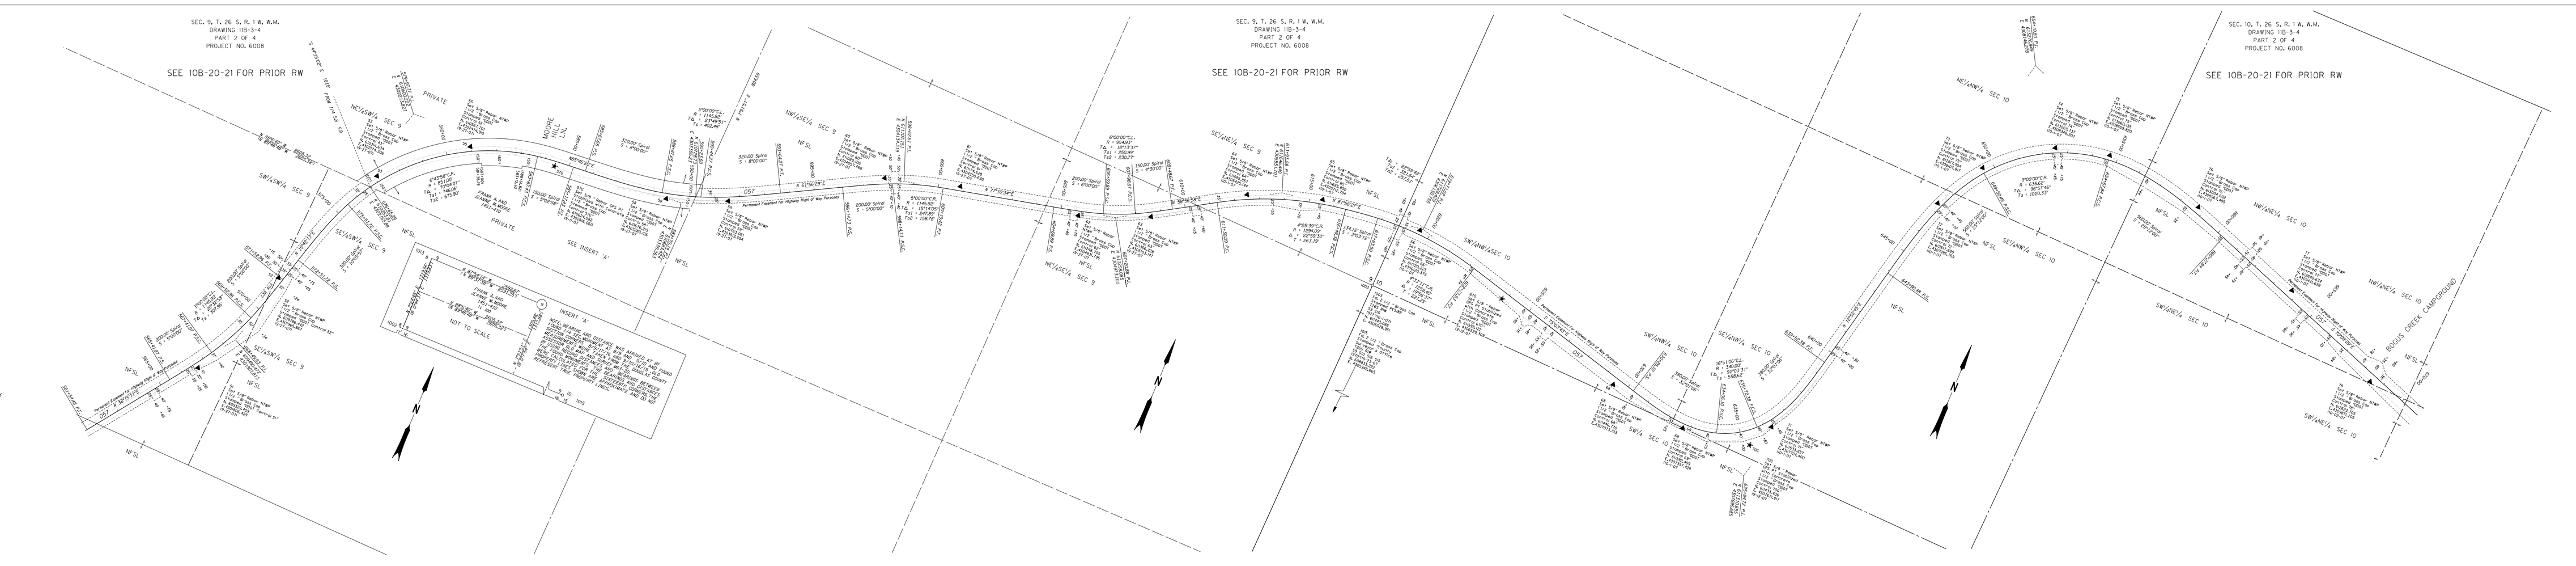
SEE 10B-20-21 FOR PRIOR RW
SEE 10B-20-21 FOR PRIOR RW
SEE 10B-20-21 FOR PRIOR RW
N
PRIVATE
NE1/4SW1/4 SEC 9
SE1/4SW1/4 SEC 9
NFSL
MOORE HILL LN.
FRANK A. AND JEANNE M. MOORE 1451-410
SEE INSERT 'A'
INSERT 'A'
NOT TO SCALE
Permanent Easement for Highway

NOTE: BEARING AND DISTANCE WAS ARRIVED AT BY FOUND 1/4 SEC. MONUMENT AT 8/9 AND 9/10 AND FOUND SECTION CORNERS 8/9/17/16 AND 9/10/16/15. GLO MEASUREMENTS WERE TAKEN FROM THE DOUGLAS COUNTY ASSESSOR GLO MAP AND SURVEY M63-20. BY USING RECORD DISTANCES AND BEARINGS BETWEEN THE FOUND MONUMENTS THE BEARINGS AND DISTANCES WERE CALCULATED FOR THE SIXTEENTH CORNERS. THE PROPERTY LINES SHOWN ARE APPROXIMATE AND DO NOT REPRESENT TRUE PROPERTY LINES.

FOREST BOUNDARY - STEAMBOAT CREEK SECTION
NORTH UMPQUA HIGHWAY
DOUGLAS COUNTY
LOCATED LINE
SCALE 1" = 100'
DRAWING 11B-3-4 PART 2 OF 4
PROJECT NO. 6008

FOREST BOUNDARY - STEAMBOAT CREEK SECTION NORTH UMPQUA HIGHWAY DOUGLAS COUNTY LOCATED LINE SCALE 1" = 100' DRAWING 11B-3-4 PART 2 OF 4 PROJECT NO. 6008

OREGON DEPARTMENT OF TRANSPORTATION
Located Line

FOREST BOUNDARY - STEAMBOAT CREEK SECTION

NORTH UMPQUA HIGHWAY
DOUGLAS COUNTY

DRAFTED BY MICKEY CALVERT, ODOT, AUGUST, 2009

BEARINGS: Oregon Coordinate System of 1983(CORS 96 EPOCH 2002), South zone.

COORDINATES: This drawing utilizes a Local Datum Plane (LDP) which is relative to the Oregon Coordinate System of 1983(CORS 96 EPOCH 2002), South zone, with respect to the local latitude and ground elevation. The LDP coordinates define true ground distances. To convert the LDP coordinates, for the control points, to the Oregon Coordinate System of 1983(CORS 96 EPOCH 2002), South zone, multiply the LDP coordinates by 0.99984945.

FIELD NOTES: This drawing shows the results of an Oregon Department Of Transportation (ODOT) survey. The field survey notes, book number 4427, are available from ODOT files in Salem, Oregon.

DRAWING 11B-3-4 PART 3 OF 4
PROJECT NO. 6008

ACCESS CONTROL LINE —·—·—·—·—

CAD FILE NAME: 15205RW.DGN 8/20/2009

SCALE 1" = 100'

NOTE: NFSL = NATIONAL FOREST SERVICE LAND

REVISION HISTORY

DATE	NAME	DESCRIPTION

ACTIVE COPY
THE R/W SHOWN ON THIS MAP MAY LATER BE REVISED TO SUPPORT PROJECT DESIGN CHANGES OR OTHER NEEDS
RIGHT OF WAY ENGINEERING

SEE COUNTY SURVEY HWY. 138-011 FOR HORIZONTAL CONTROL AND RECOVERY SURVEY

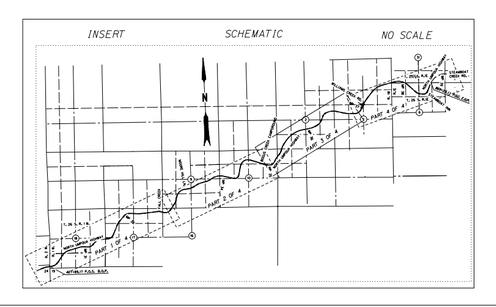
INSERT
SCHEMATIC
NO SCALE

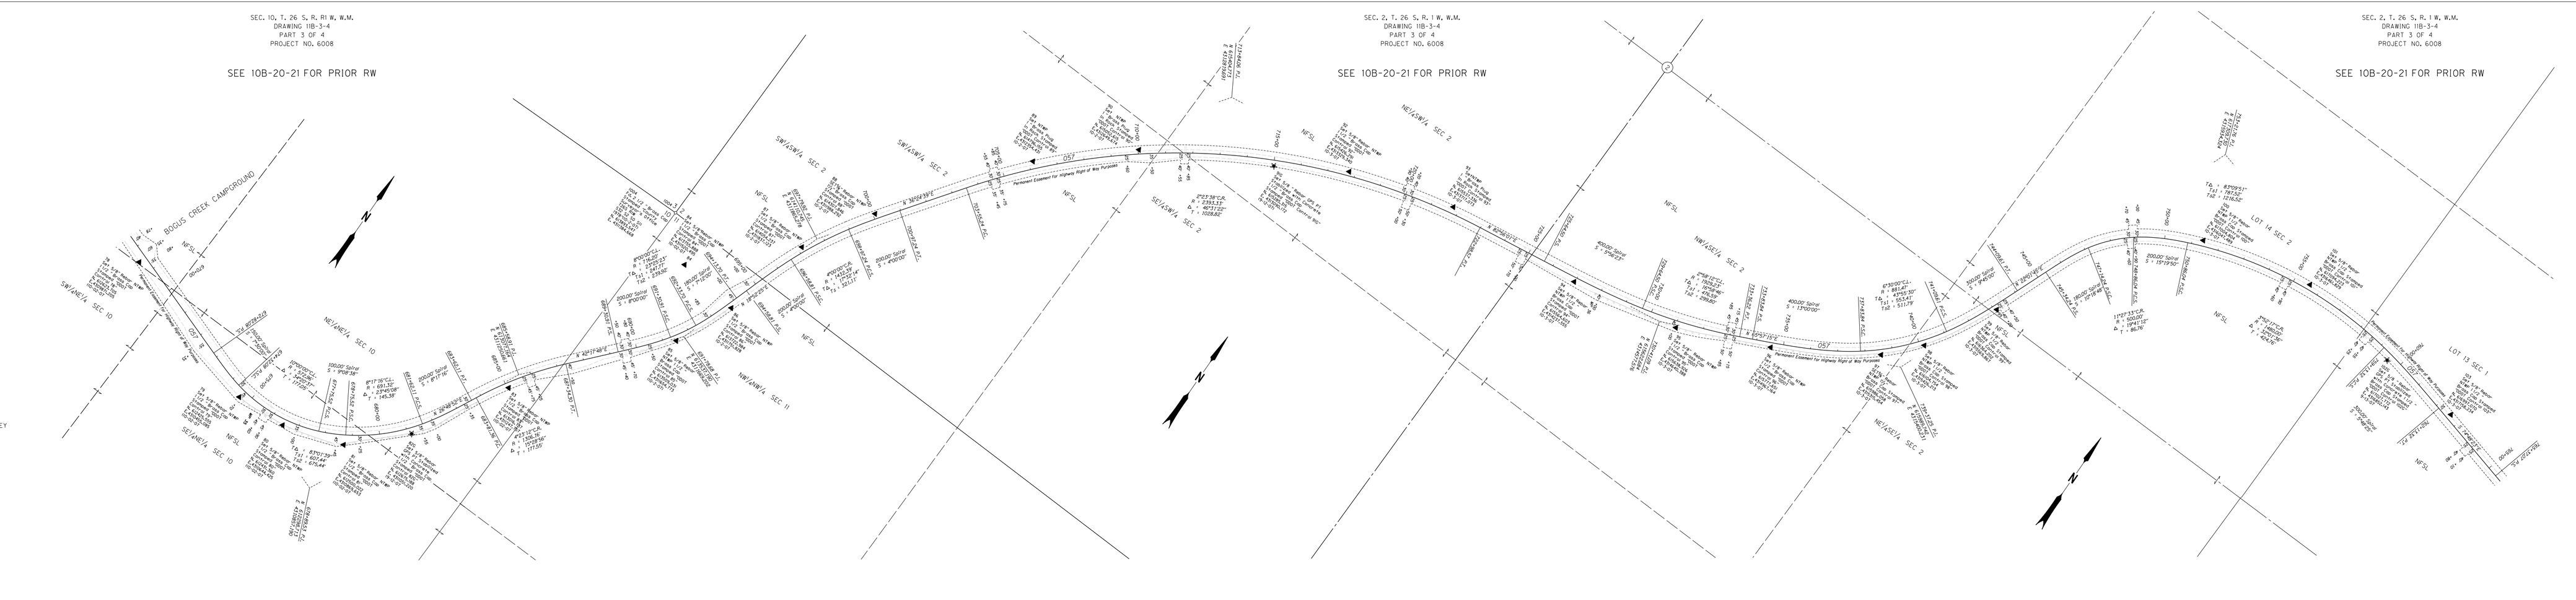
SEE 10B-20-21 FOR PRIOR RW
SEE 10B-20-21 FOR PRIOR RW
SEE 10B-20-21 FOR PRIOR RW
765+00
765+37.07 P.S.

FOREST BOUNDARY - STEAMBOAT CREEK SECTION
NORTH UMPQUA HIGHWAY
DOUGLAS COUNTY
LOCATED LINE
SCALE 1" = 100'
DRAWING 11B-3-4 PART 3 OF 4
PROJECT NO. 6008

FOREST BOUNDARY - STEAMBOAT CREEK SECTION NORTH UMPQUA HIGHWAY DOUGLAS COUNTY LOCATED LINE SCALE 1" = 100' DRAWING 11B-3-4 PART 3 OF 4 PROJECT NO. 6008

OREGON DEPARTMENT OF TRANSPORTATION
Located Line

FOREST BOUNDARY - STEAMBOAT CREEK SECTION

NORTH UMPQUA HIGHWAY
DOUGLAS COUNTY

DRAFTED BY MICKEY CALVERT, ODOT, AUGUST, 2009

BEARINGS: Oregon Coordinate System of 1983(CORS 96 EPOCH 2002), South zone.

COORDINATES: This drawing utilizes a Local Datum Plane (LDP) which is relative to the Oregon Coordinate System of 1983(CORS 96 EPOCH 2002), South zone, with respect to the local latitude and ground elevation. The LDP coordinates define true ground distances. To convert the LDP coordinates, for the control points, to the Oregon Coordinate System of 1983(CORS 96 EPOCH 2002), South zone, multiply the LDP coordinates by 0.99984945.

FIELD NOTES: This drawing shows the results of an Oregon Department Of Transportation (ODOT) survey. The field survey notes, book number 4427, are available from ODOT files in Salem, Oregon.

DRAWING 11B-3-4 PART 4 OF 4
PROJECT NO. 6008

ACCESS CONTROL LINE —·—·—·—·—

CAD FILE NAME: 15205RW.DGN 8/20/2009

SCALE 1" = 100'

NOTE: NFSL = NATIONAL FOREST SERVICE LAND

REVISION HISTORY

DATE	NAME	DESCRIPTION

ACTIVE COPY
THE R/W SHOWN ON THIS MAP MAY LATER BE REVISED TO SUPPORT PROJECT DESIGN CHANGES OR OTHER NEEDS
RIGHT OF WAY ENGINEERING

SEE COUNTY SURVEY HWY. 138-011 FOR HORIZONTAL CONTROL AND RECOVERY SURVEY

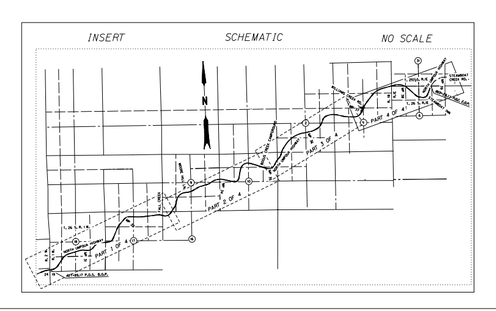
INSERT
SCHEMATIC
NO SCALE

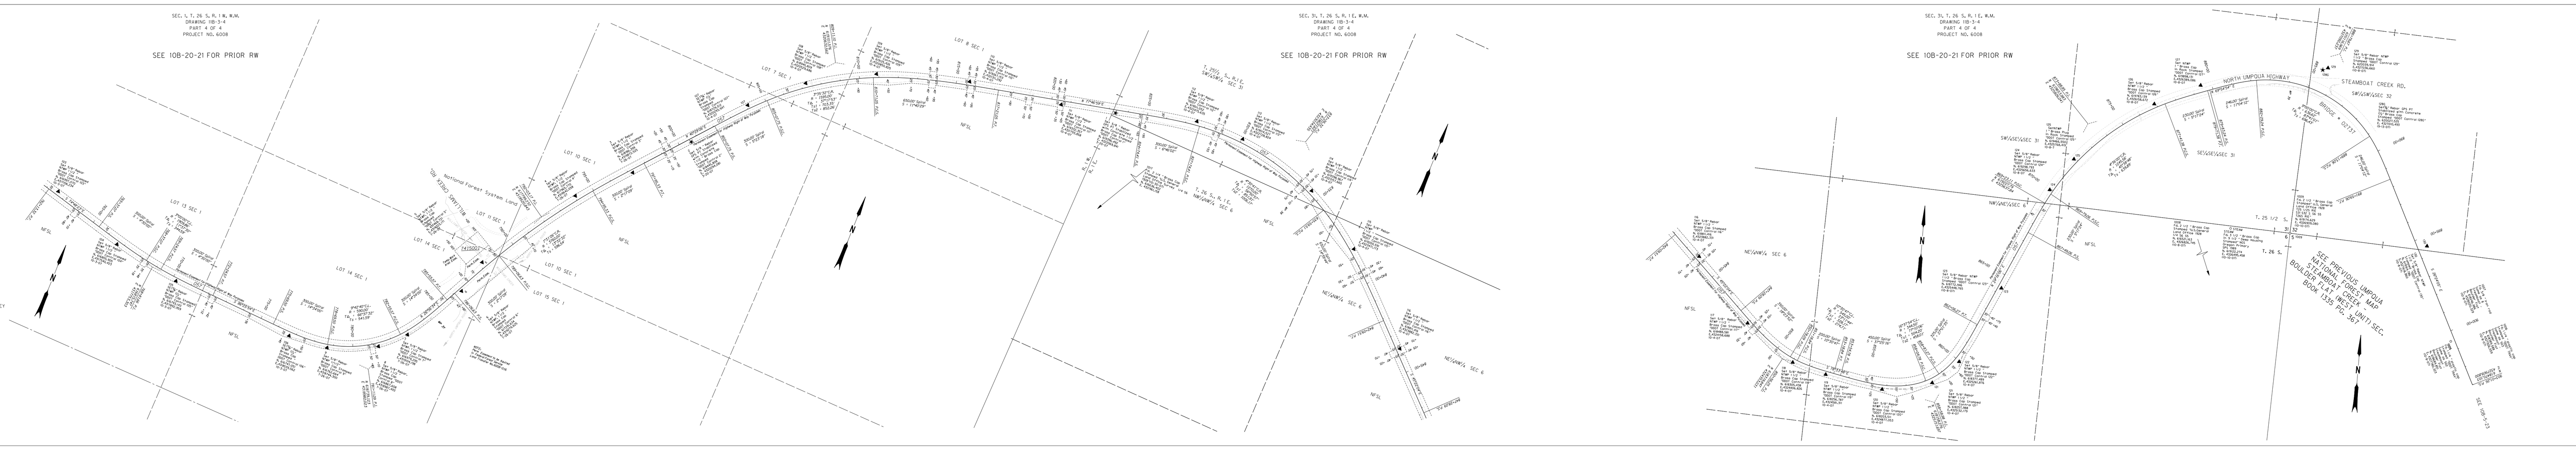
SEE 10B-20-21 FOR PRIOR RW
SEE 10B-20-21 FOR PRIOR RW
SEE 10B-20-21 FOR PRIOR RW
1006
Fd. 1 1/4" plastic cap
Stamped "ODOT TRAV" 503

FOREST BOUNDARY - STEAMBOAT CREEK SECTION
NORTH UMPQUA HIGHWAY
DOUGLAS COUNTY
LOCATED LINE
SCALE 1" = 100'
DRAWING 11B-3-4 PART 4 OF 4
PROJECT NO. 6008

FOREST BOUNDARY - STEAMBOAT CREEK SECTION NORTH UMPQUA HIGHWAY DOUGLAS COUNTY LOCATED LINE SCALE 1" = 100' DRAWING 11B-3-4 PART 4 OF 4 PROJECT NO. 6008