


U M P Q U A N A T I O N A L F O R E S T

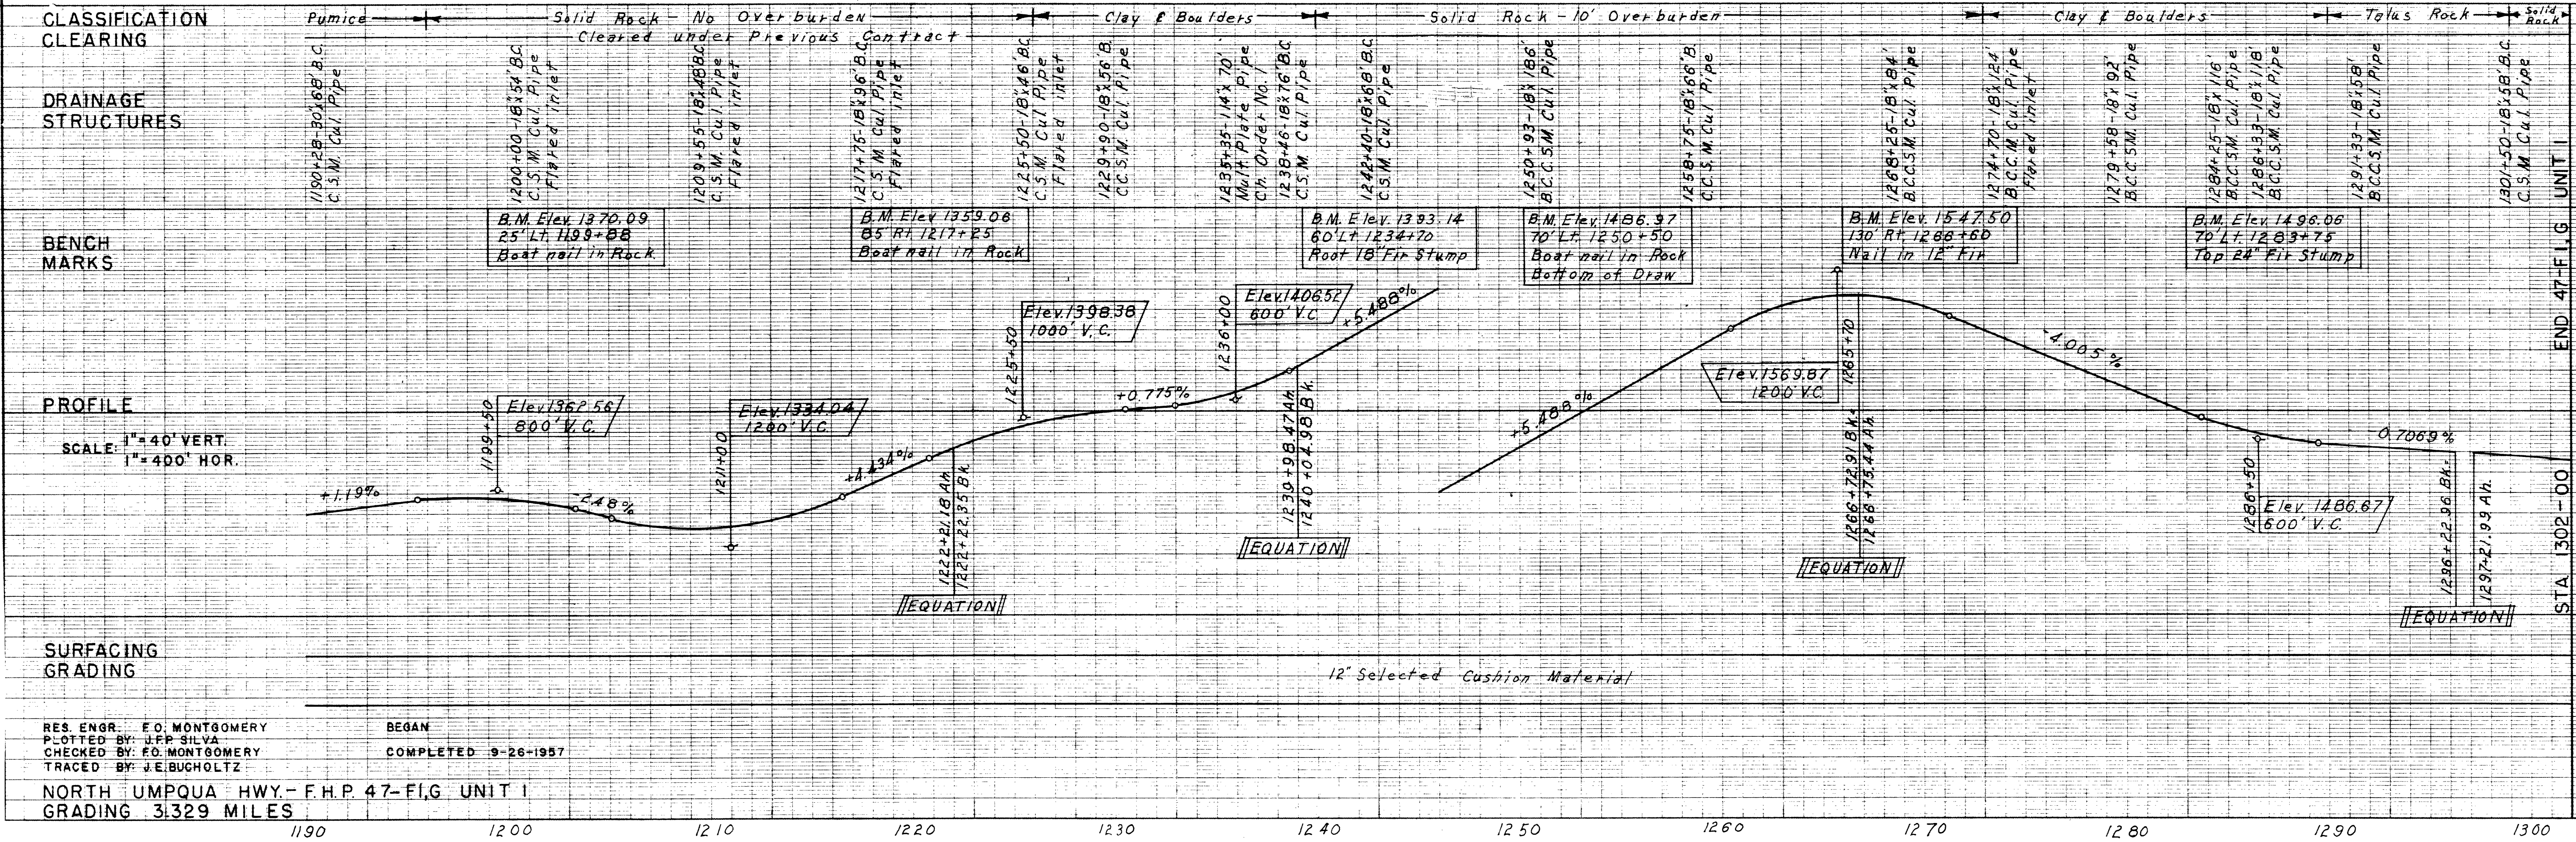

RES. ENGR. F.O. MONTGOMERY
 PLOTTED BY: JFP SILVA
 CHECKED BY: F.O. MONTGOMERY
 TRACED BY: J.E. BUGHOLTZ

BEGAN
 COMPLETED 9-26-1957

NORTH UMPQUA HWY. - F.H.P. 47-FIG UNIT I
 GRADING 3.329 MILES