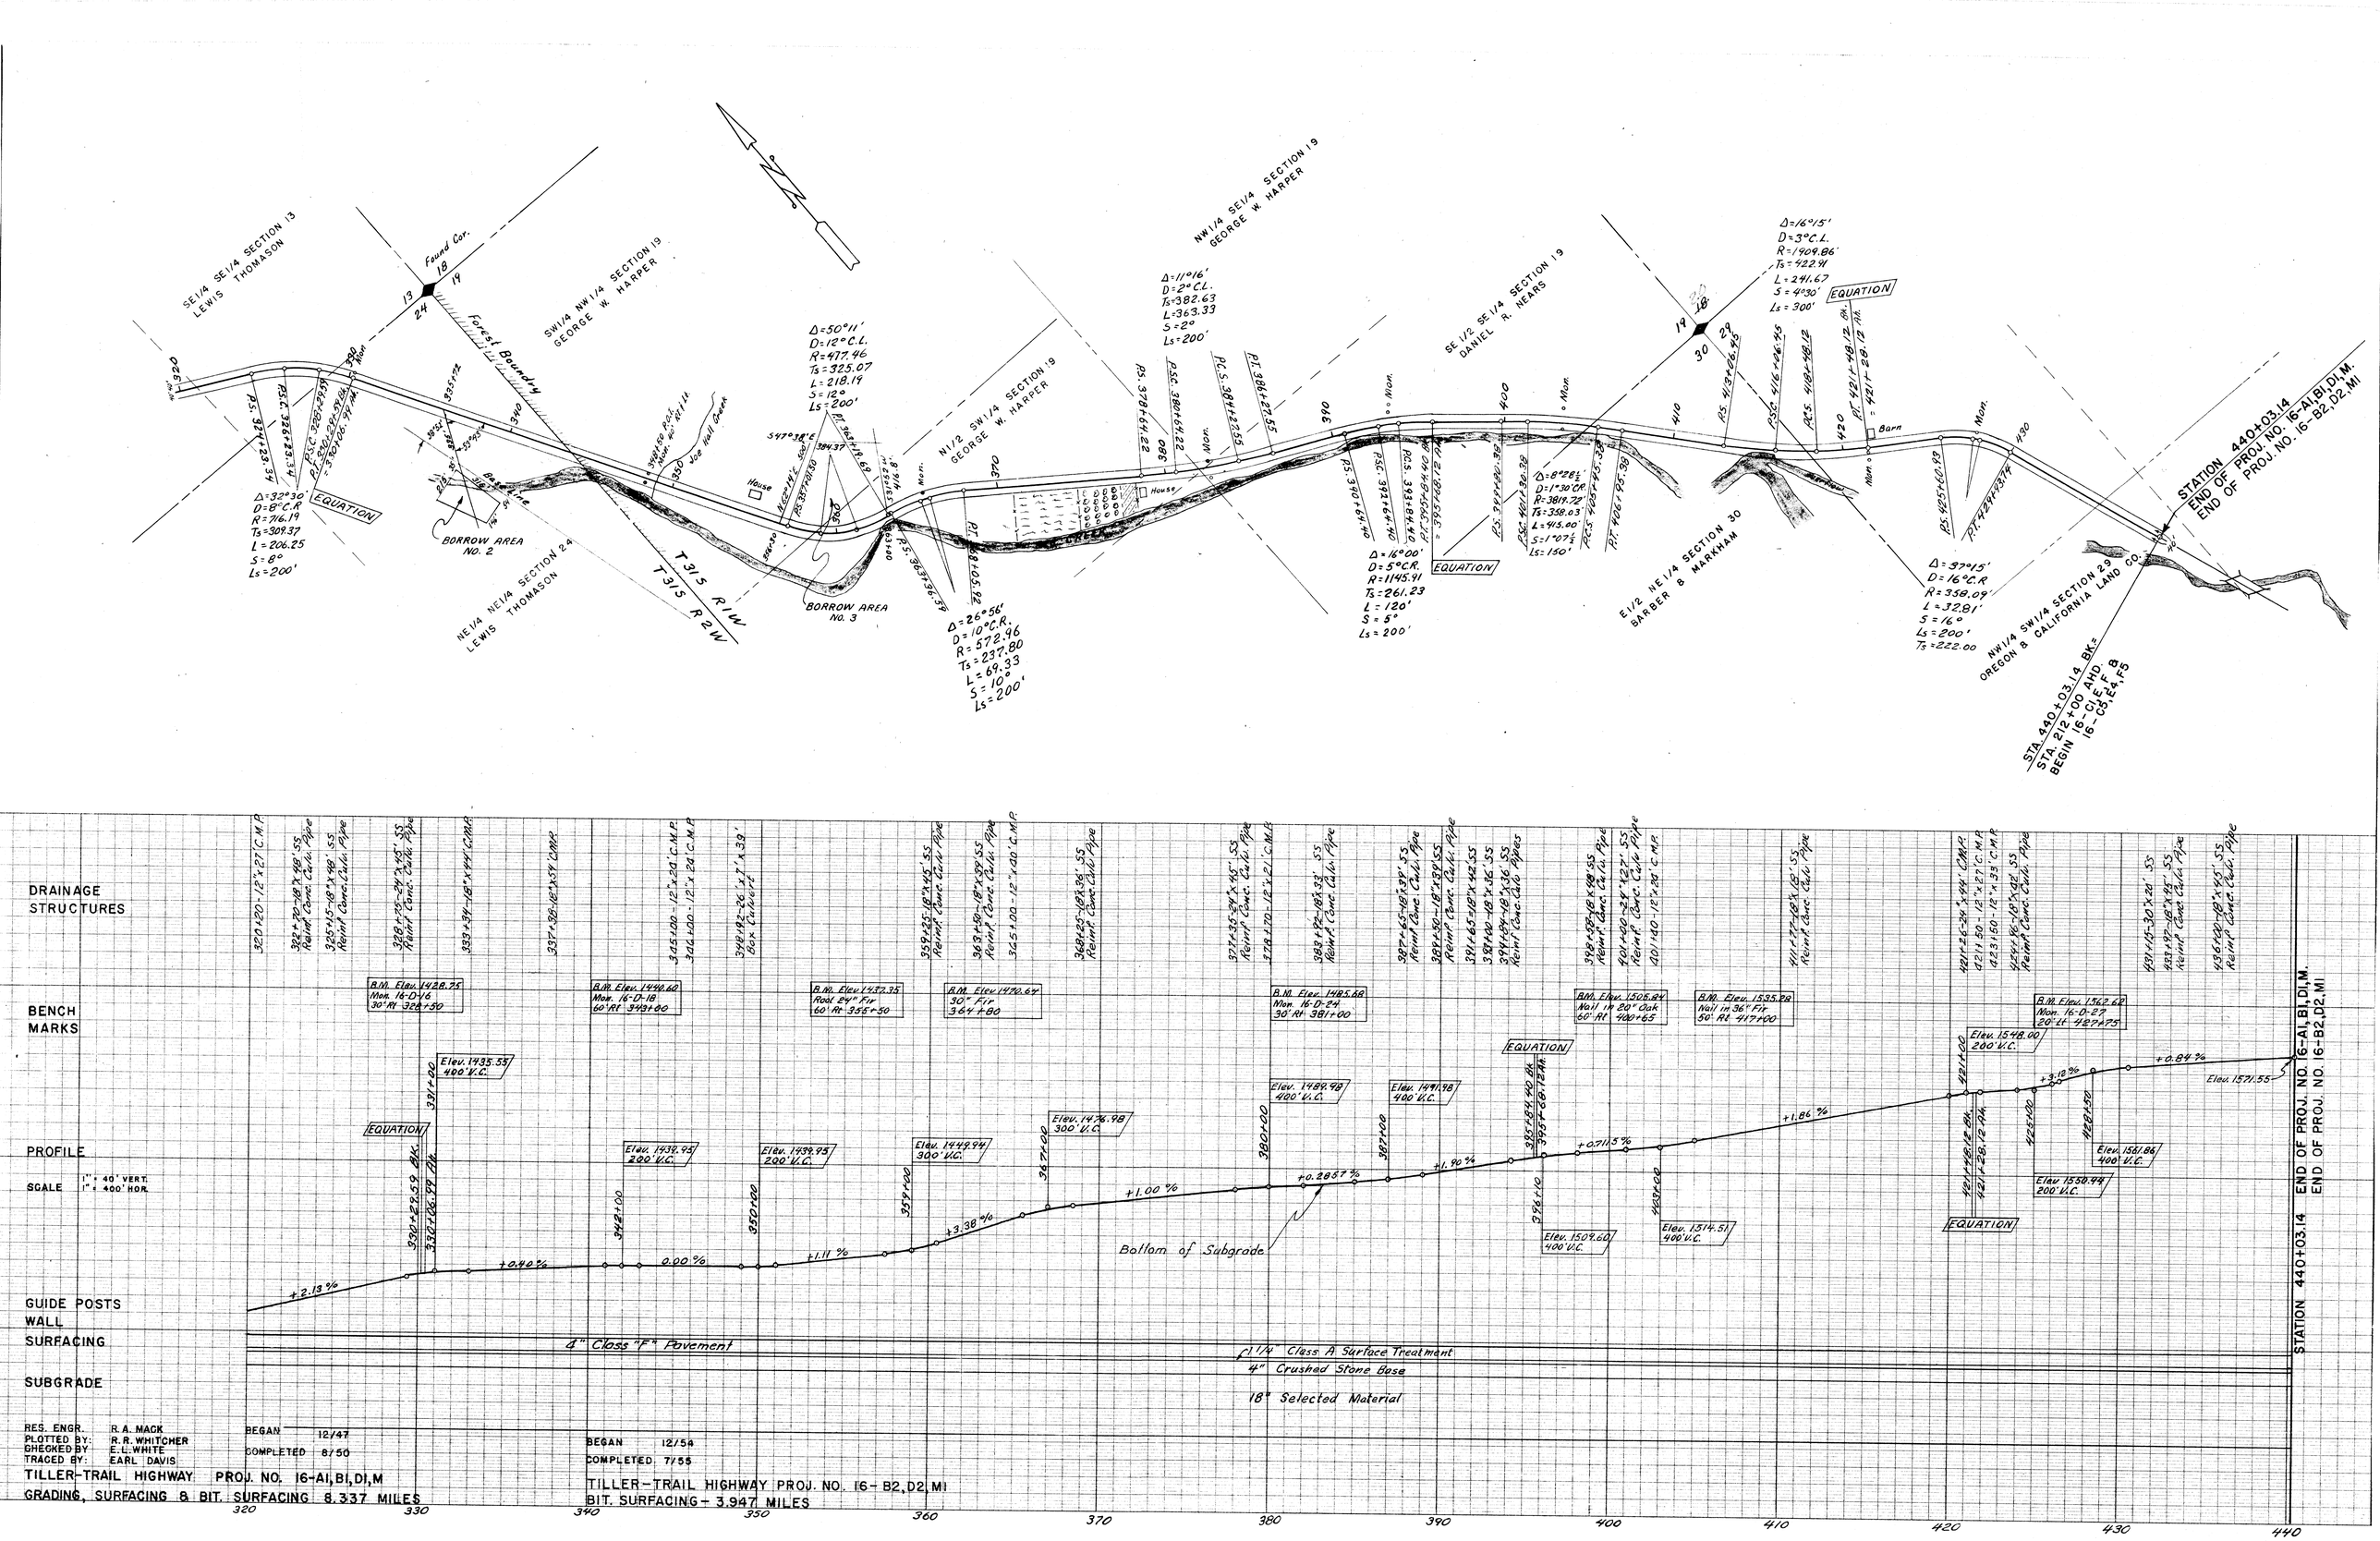

RES. ENGR.	R. A. MACK	BEGAN	12/47
PLOTTED BY:	R. R. WHITCHER		
CHECKED BY:	E. L. WHITE	COMPLETED	8/50
TRACED BY:	EARL DAVIS		

TILLER-TRAIL HIGHWAY PROJ. NO. 16-A1, B1, D1, M

GRADING, SURFACING & BIT. SURFACING 8.337 MILES

BEGAN 12/54

COMPLETED 7/55

TILLER-TRAIL HIGHWAY PROJ. NO. 16-B2, D2, M1

BIT. SURFACING - 3.947 MILES