FILED 4/3/73

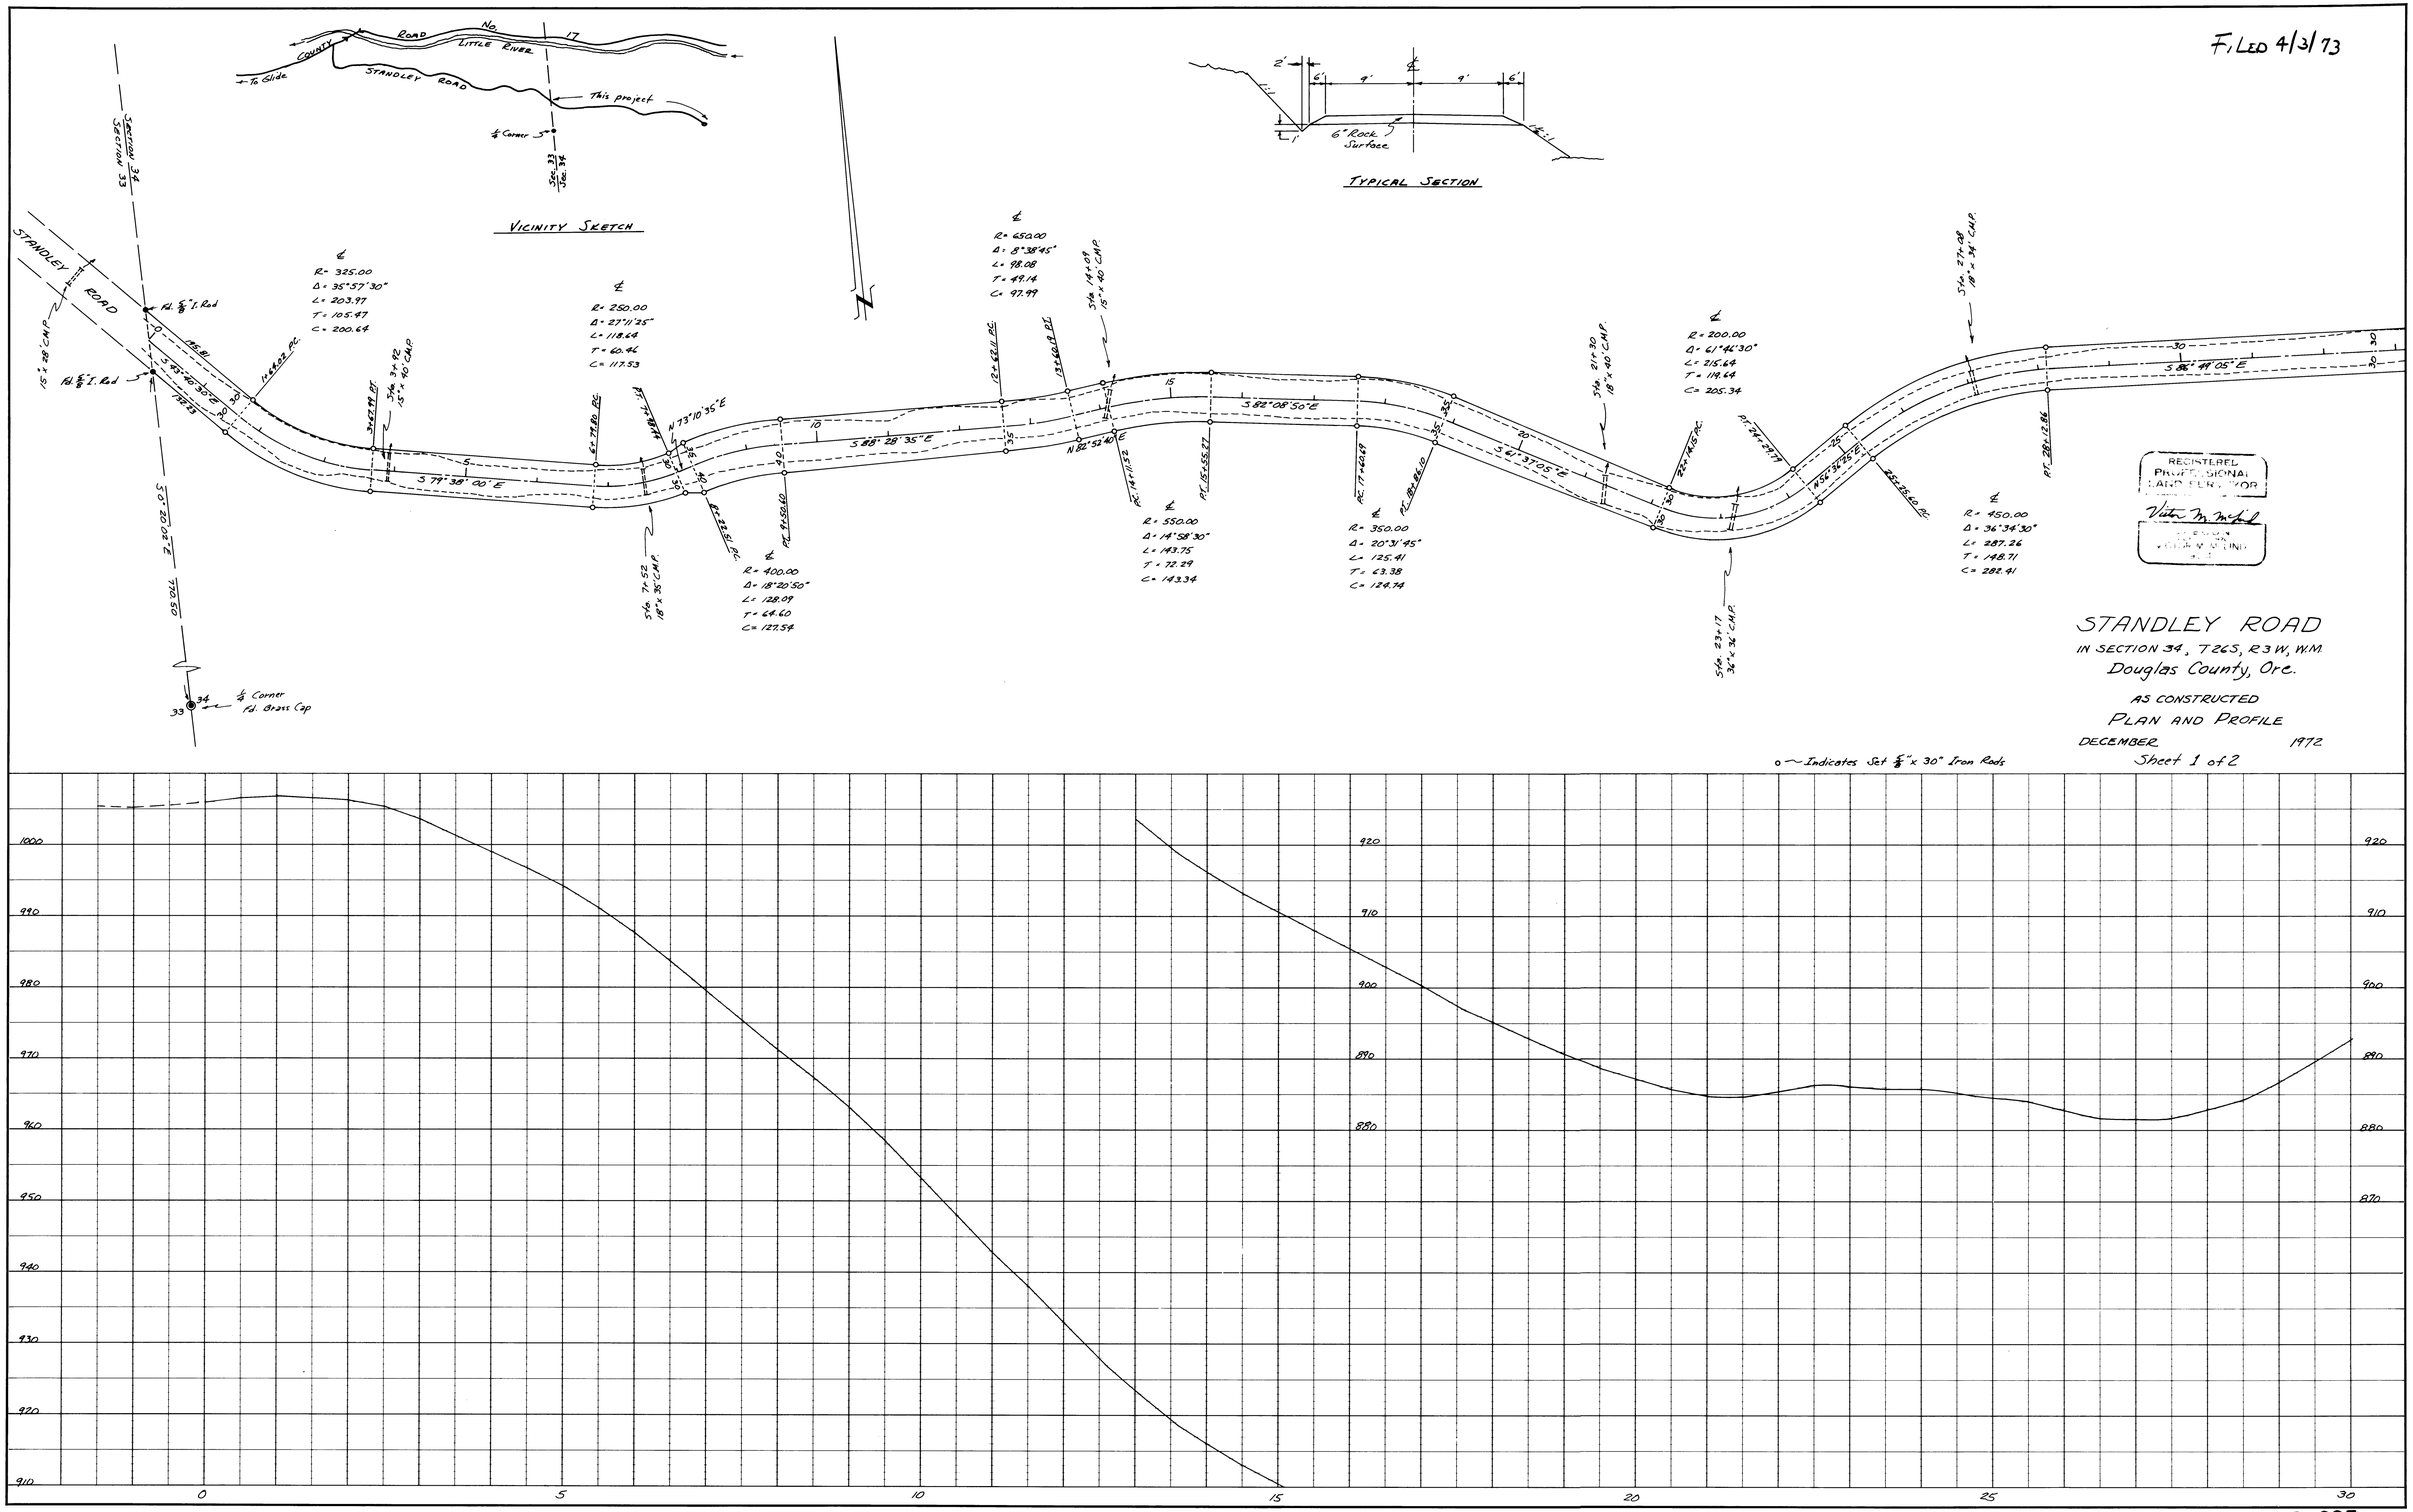

PLATE 1 PLAN-PROFILE B P R STANDARD
EUGENE DIETZGEN CO CHICAGO NEW YORK

DS-035

STANDLEY ROAD