FILED 4/24/73

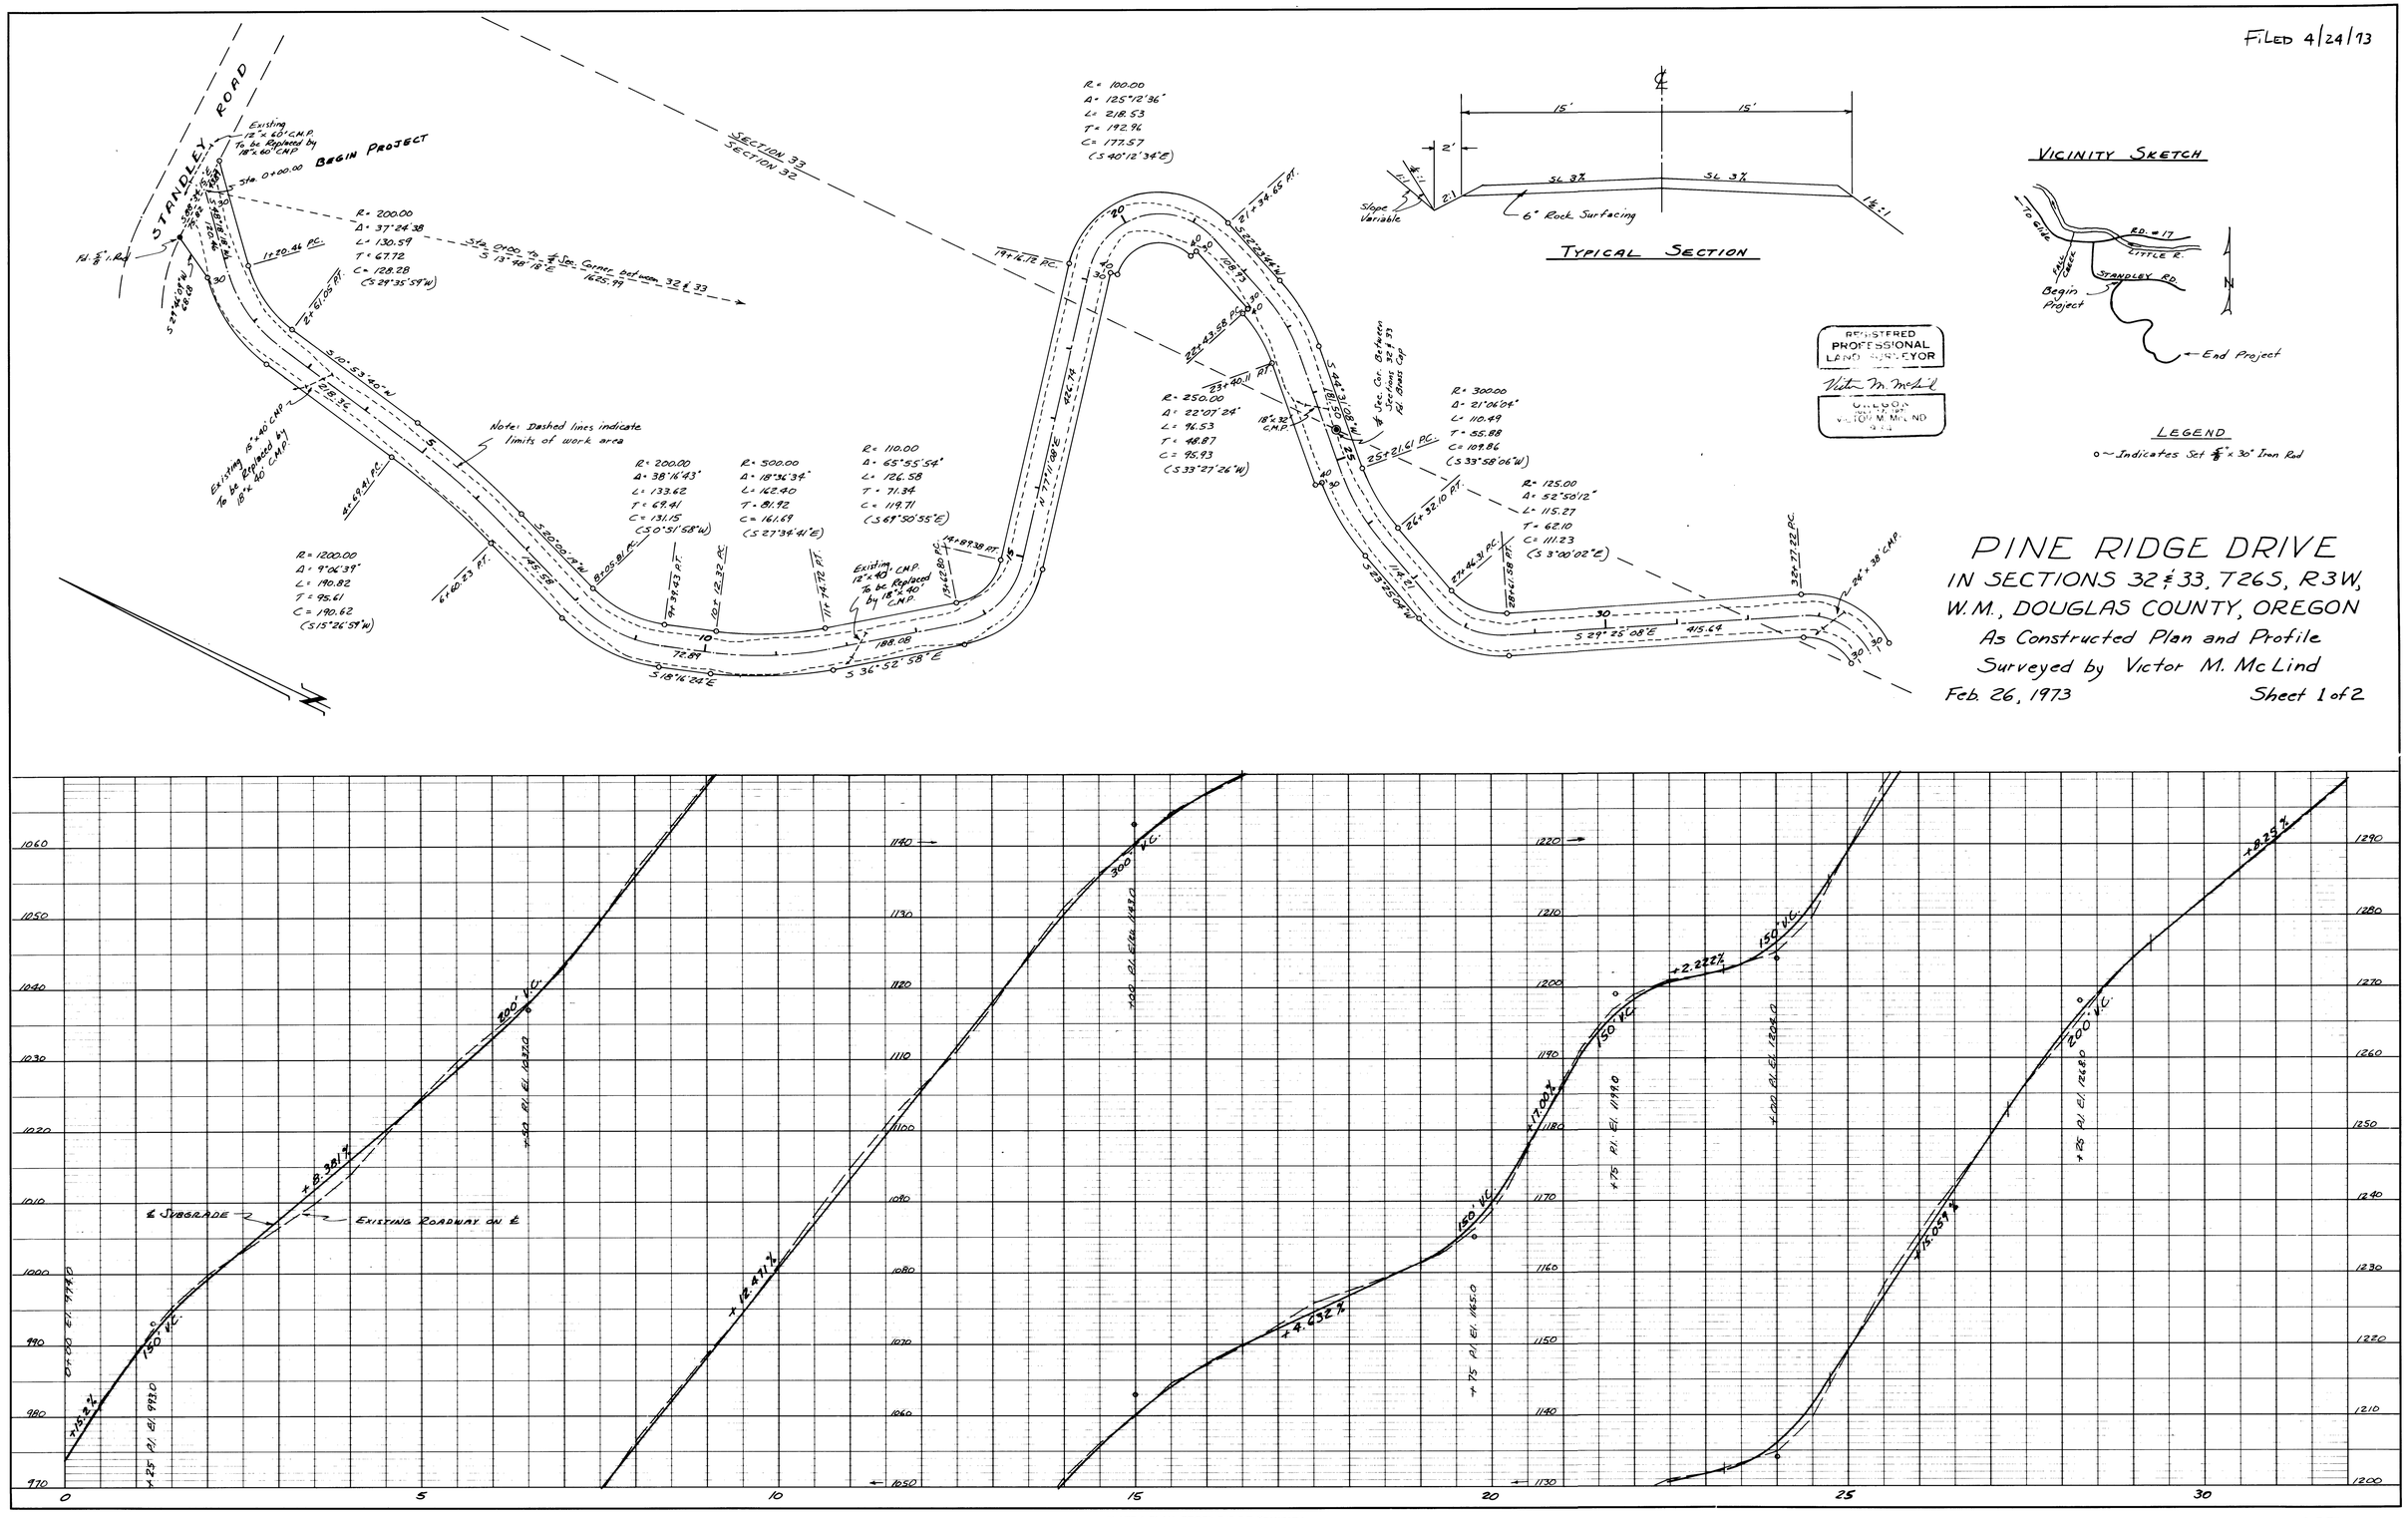

PLATE 1 PLAN-PROFILE B P R STANDARD
EUGENE DIETZGEN CO. CHICAGO - NEW YORK

DS-037