FILED 4/24/73

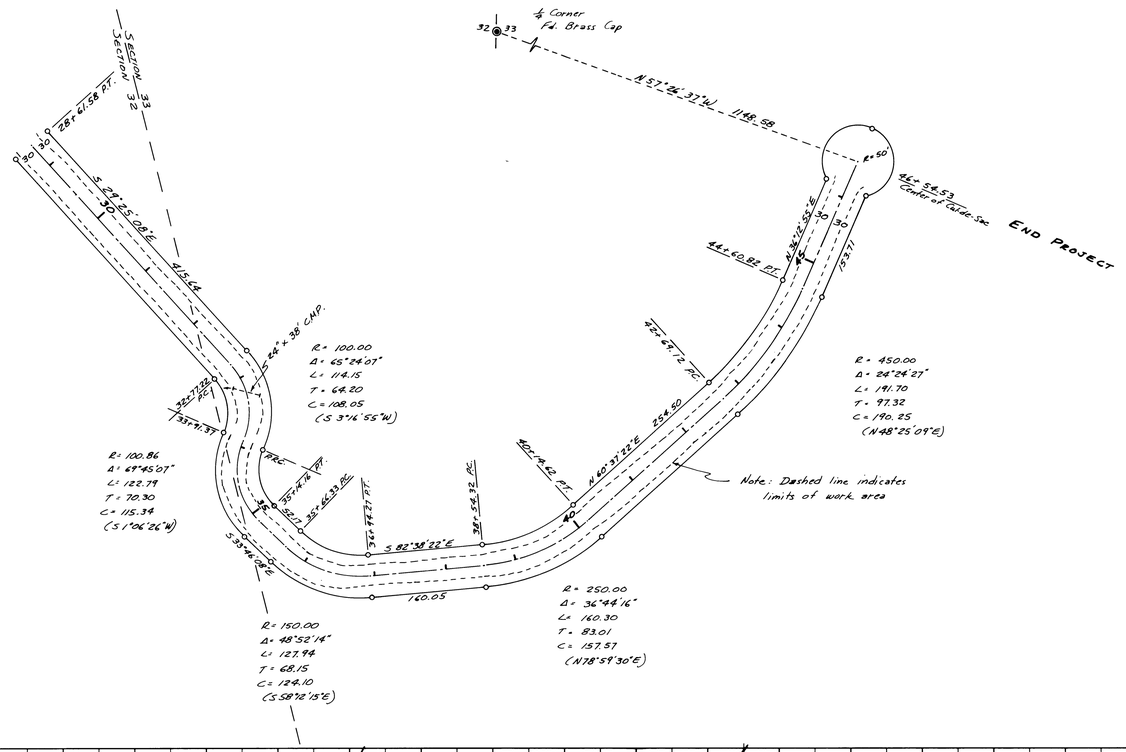

REGISTERED PROFESSIONAL LAND SURVEYOR
Victor M. McLind
OREGON
JULY 17, 1970
VICTOR M. McLIND
934

LEGEND
o— Indicates Set ⅝" x 30" Iron Rods

# PINE RIDGE DRIVE

IN SECTIONS 32 & 33, T26S, R3W, W.M., DOUGLAS COUNTY, OREGON

As Constructed Plan and Profile

Surveyed by Victor M. McLind

Feb. 26, 1973 — Sheet 2 of 2

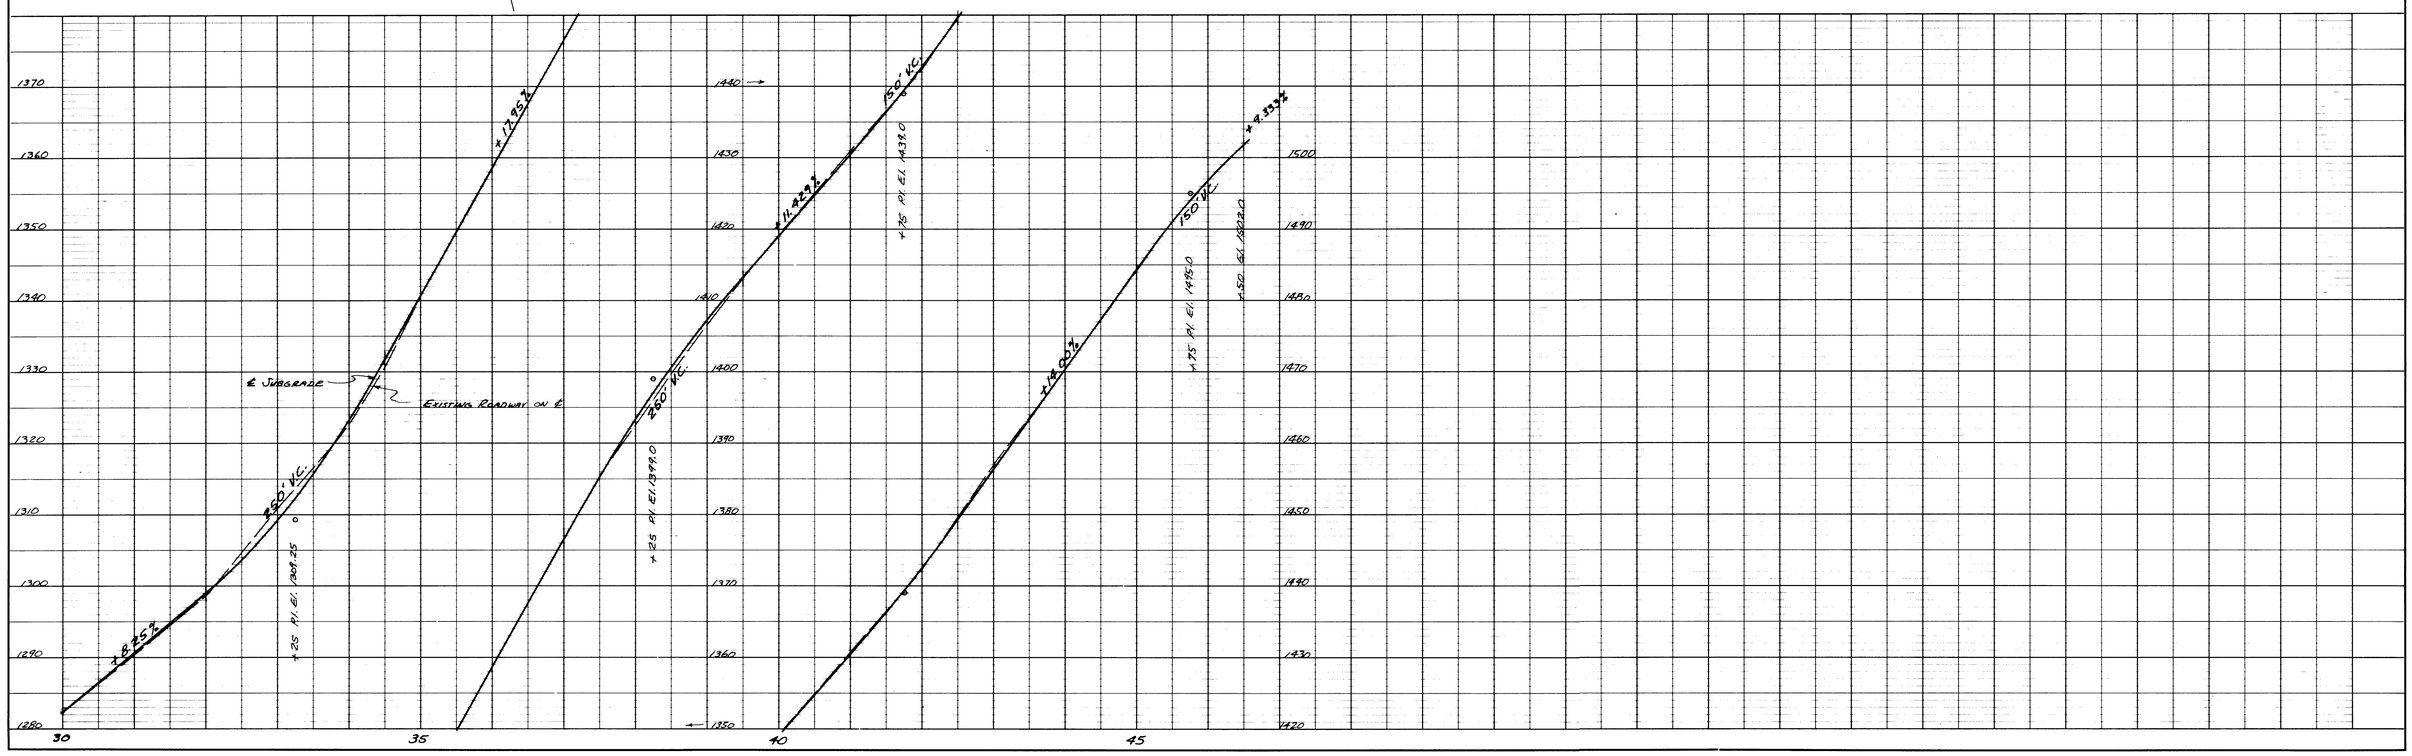


| PLAN | | BY | DATE |
|---|---|---|---|
| NOTE BOOK | SURVEYED | | |
| | PLOTTED | | |
| | ALIGNMENT CHECKED | | |
| No. | RI. OF WAY CHECKED | | |

| PROFILE | | BY | DATE |
|---|---|---|---|
| NOTE BOOK | SURVEYED | | |
| | PLOTTED | | |
| | GRADES CHECKED | | |
| | MASS DIAGRAM | | |
| No. | STRUCTURE NOTATIONS CHECKED | | |

PLATE 1 PLAN-PROFILE B P R STANDARD
EUGENE DIETZGEN CO. CHICAGO · NEW YORK

DS-038