SEC. 30, T. 30 S., R. 5 W., W.M.

FILED

AUG 10 1987

COUNTY SURVEYOR
DOUGLAS COUNTY, ORE.

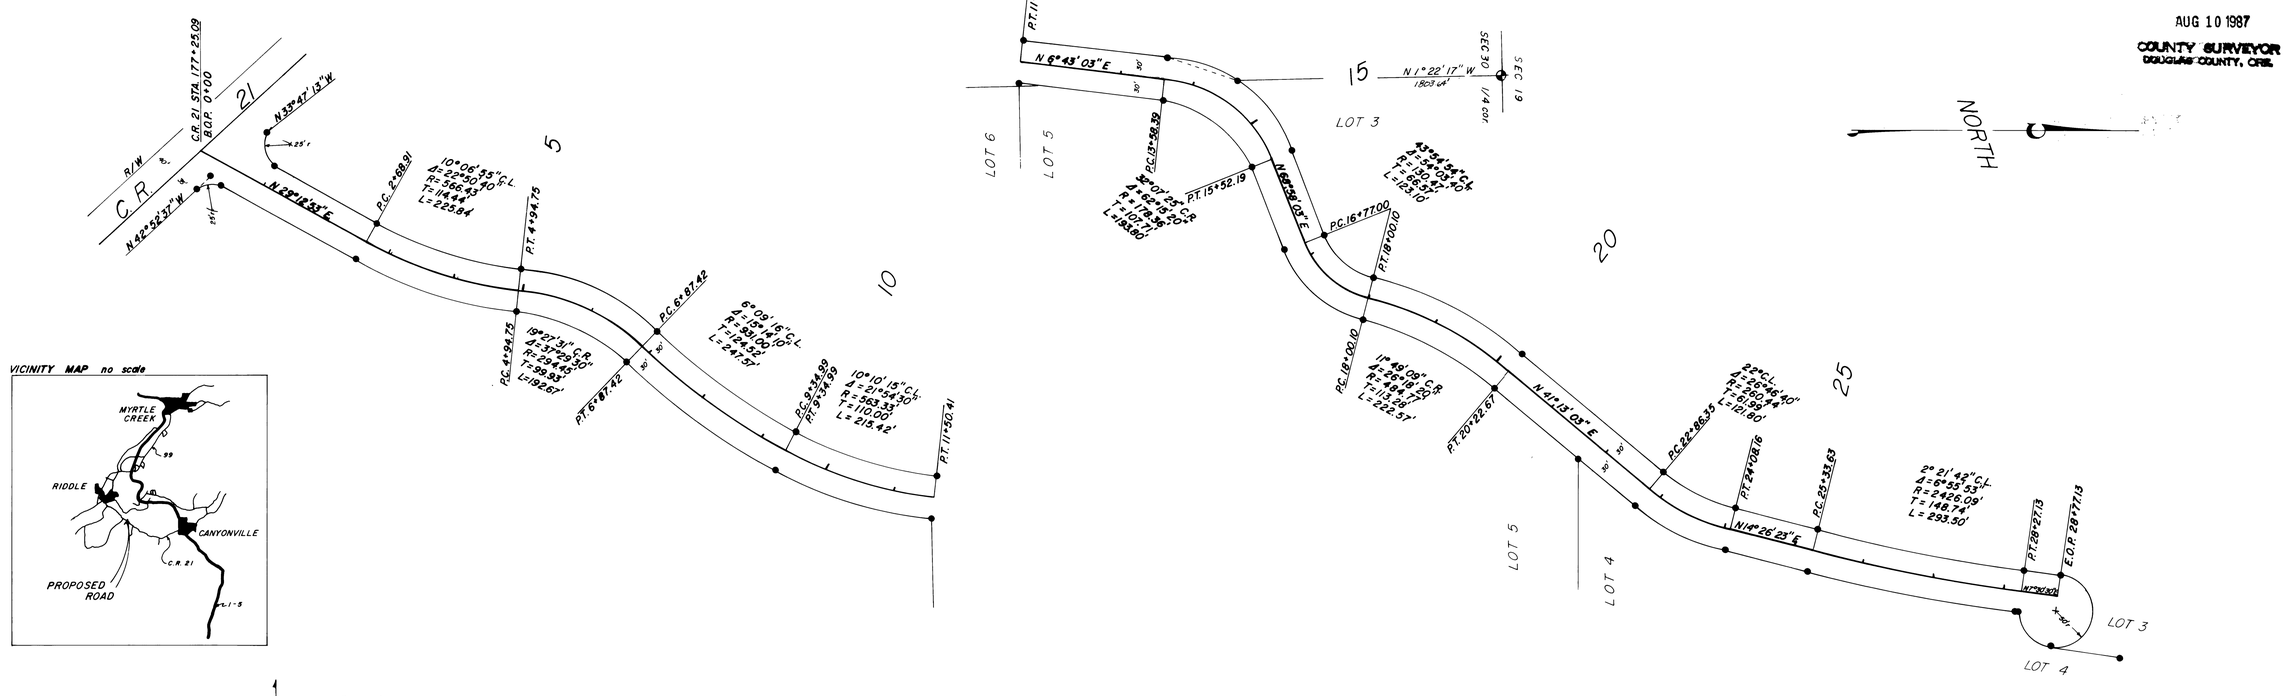

VICINITY MAP no scale

SCALE PLAN: 1" = 100'
PROFILE: HORZ. 1" = 100'
VERT. 1" = 50'

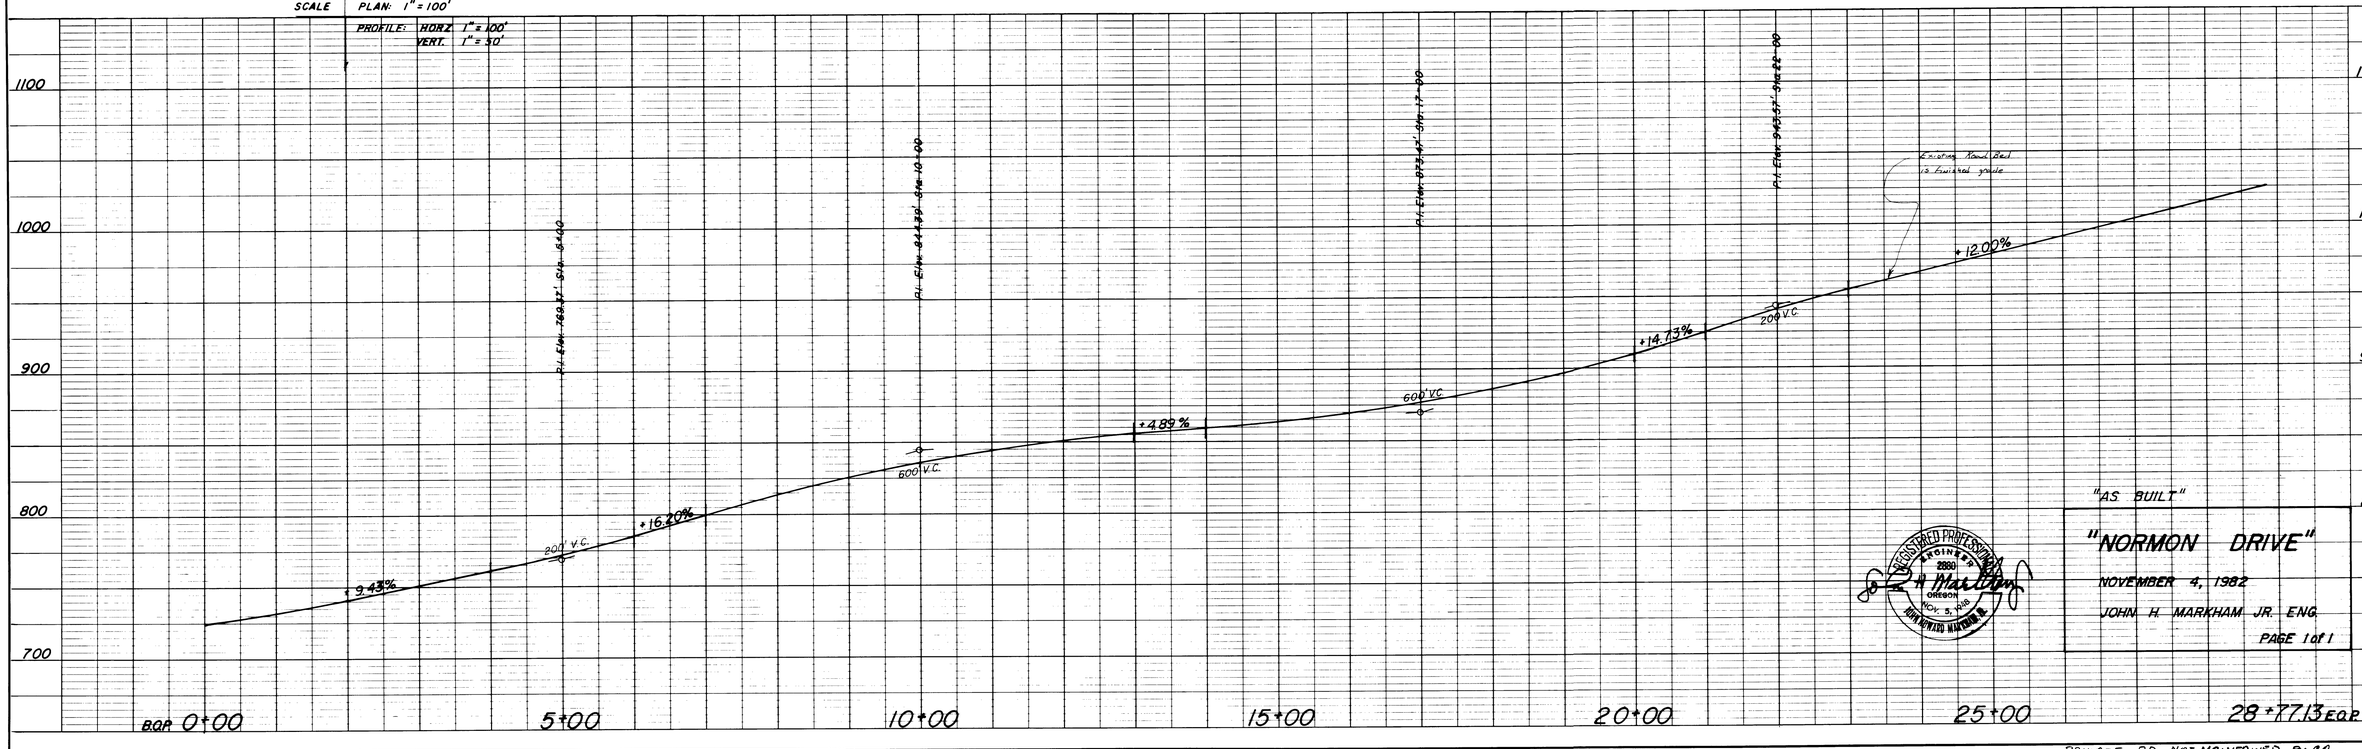

"AS BUILT"

"NORMON DRIVE"

NOVEMBER 4, 1982

JOHN H. MARKHAM JR. ENG.

PAGE 1 of 1

REGISTERED PROFESSIONAL ENGINEER
JOHN H. MARKHAM JR.
2880
OREGON
NOV. 5, 1982
RENEWAL DATE 12-31-82

PLAN		BY	DATE
NOTE BOOK	SURVEYED		
	PLOTTED		
	ALIGNMENT CHECKED		
No.	RE. OF WAY CHECKED		

PROFILE		BY	DATE
NOTE BOOK	SURVEYED		
	PLOTTED		
	GRADES CHECKED		
	B. M.'s NOTED		
No.	STRUCTURE NOTATIONS CHECKED		

PLATE 1 PLAN PROFILE 8 P R STANDARD
EUGENE DIETZGEN CO

PRIVATE RD. NOT MAINTAINED BY CO.

RECEIVED 11-8-82

DS-091