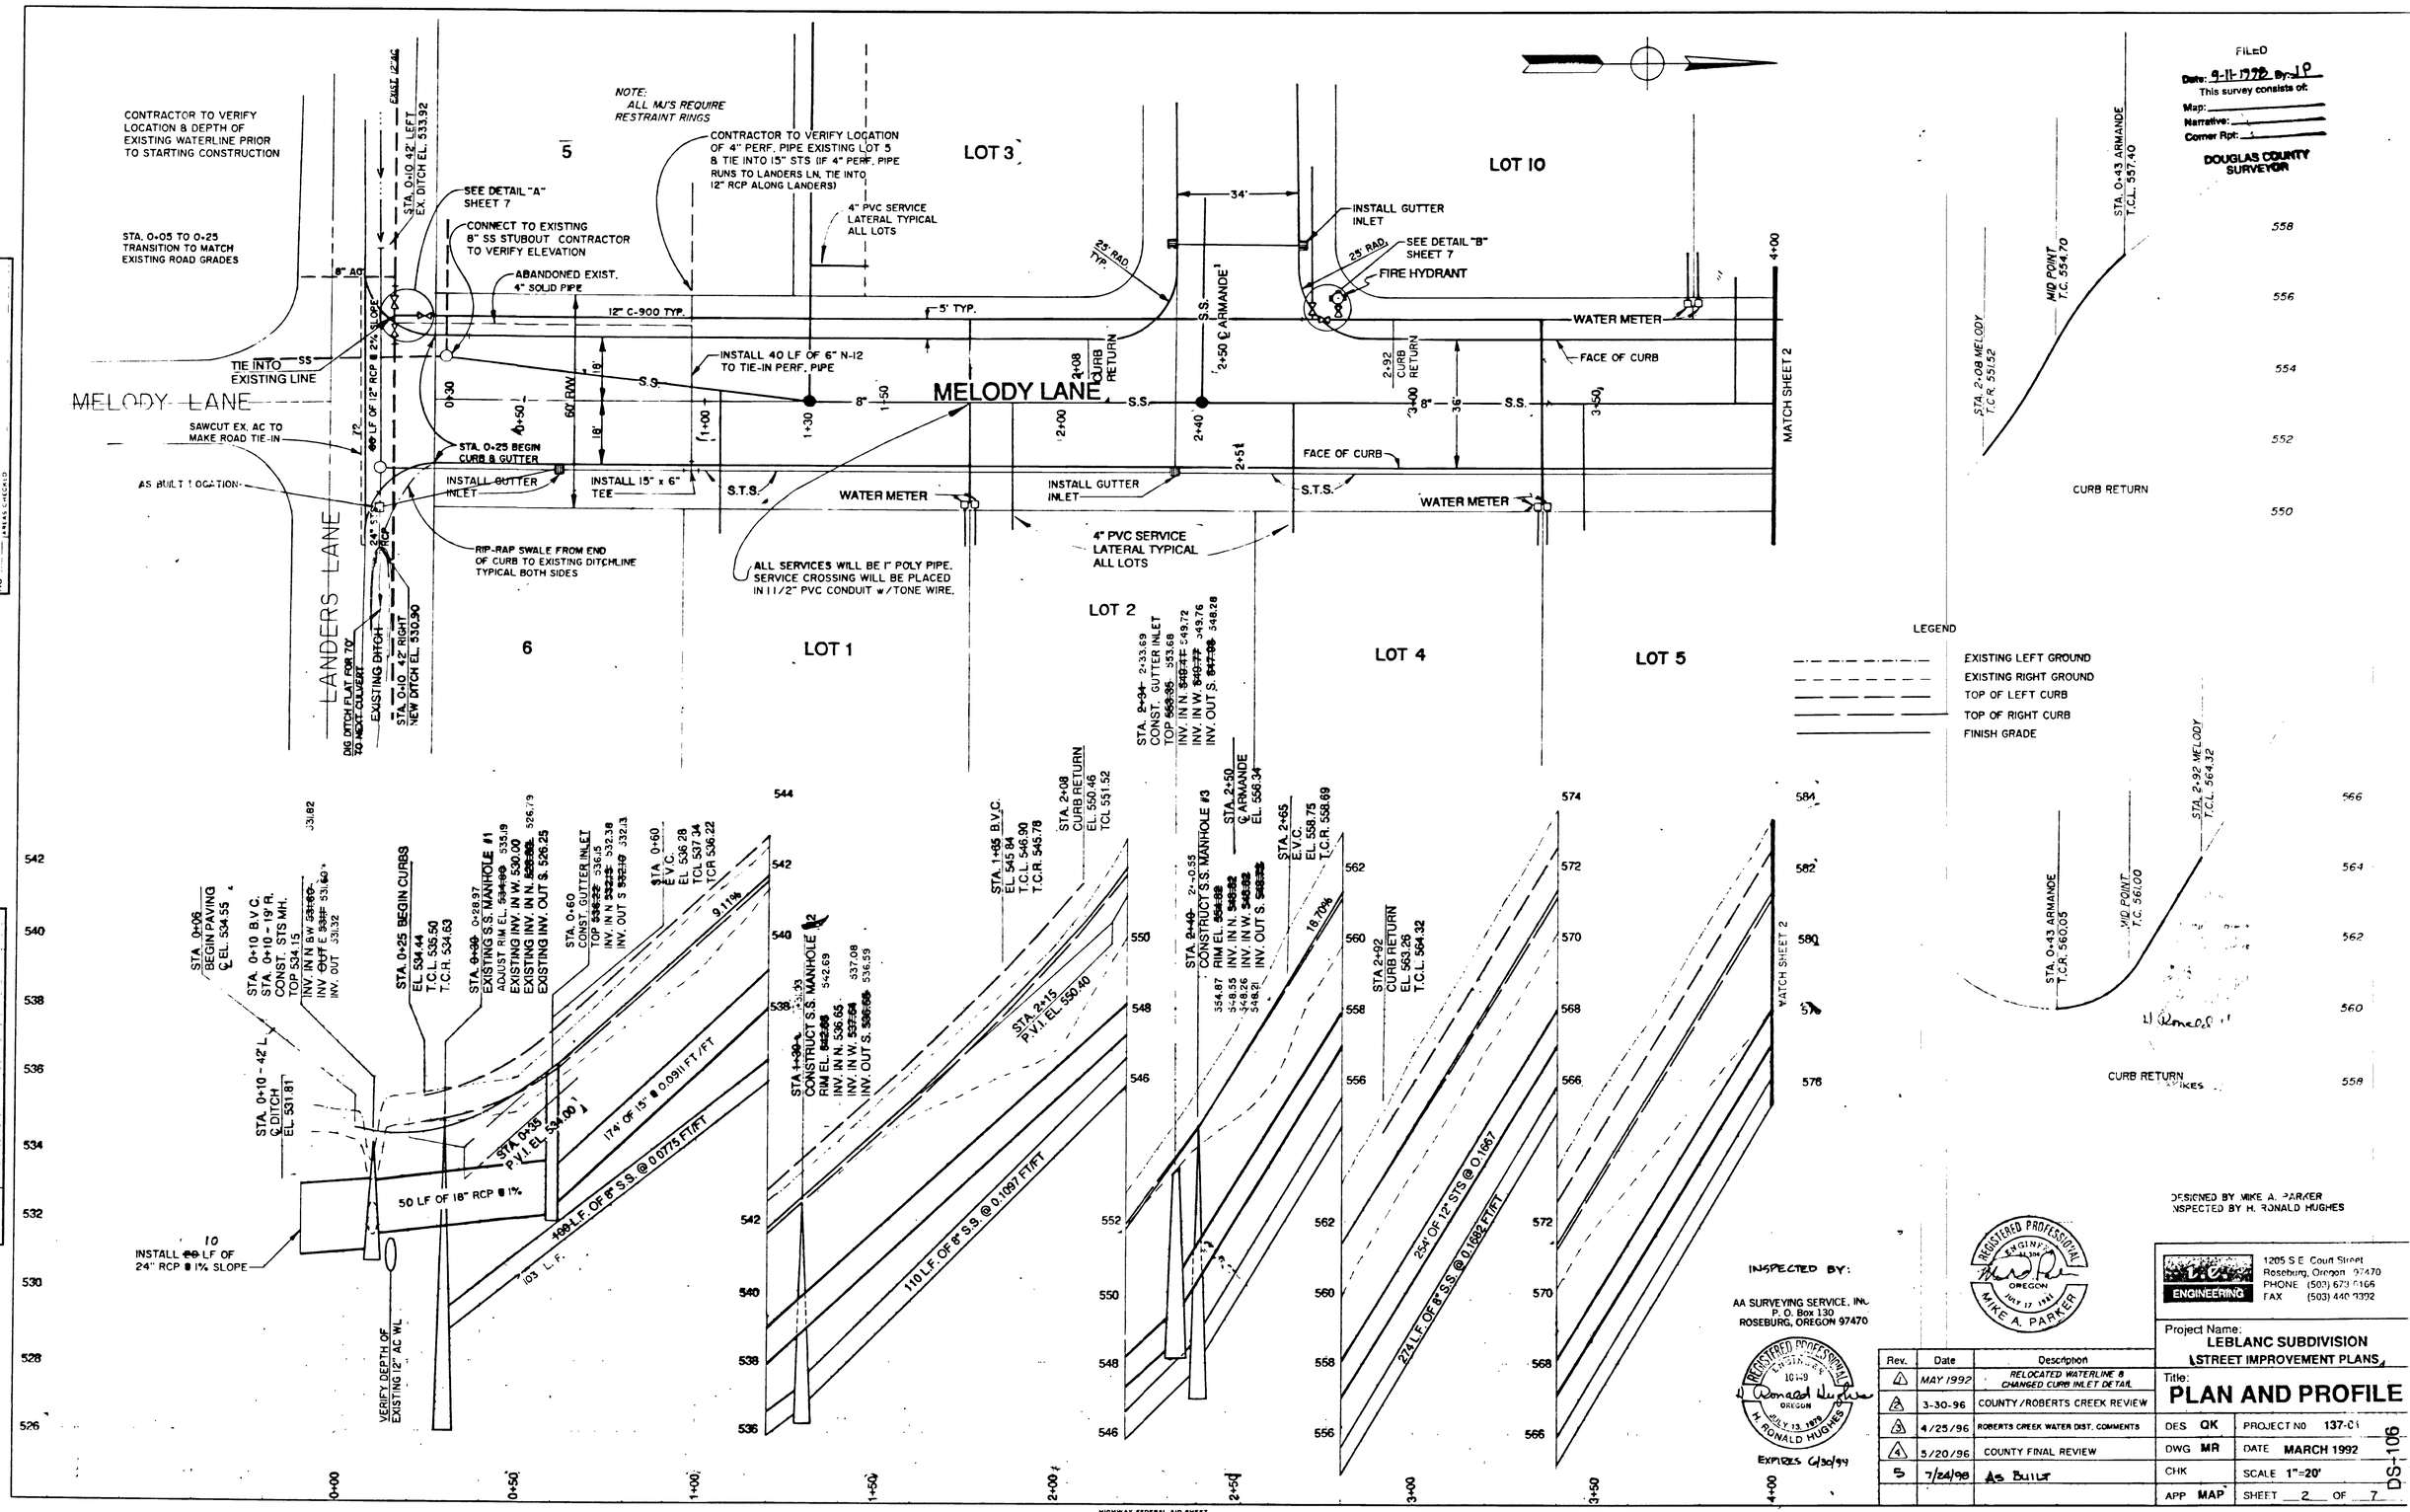

Rev.	Date	Description
1	MAY 1992	RELOCATED WATERLINE & CHANGED CURB INLET DETAIL
2	3-30-96	COUNTY/ROBERTS CREEK REVIEW
3	4/25/96	ROBERTS CREEK WATER DIST. COMMENTS
4	5/20/96	COUNTY FINAL REVIEW
5	7/24/98	AS BUILT

m.p 0.00 - 0.01

MOVED TO CO. RD. 288A