



**FILED**  
 Date: 1/10/2012 By: RW  
 This survey consists of:  
 Map: DS-115 thru 121  
 Narrative:  
 Corner Rpt:  
**DOUGLAS COUNTY**  
 SURVEYOR

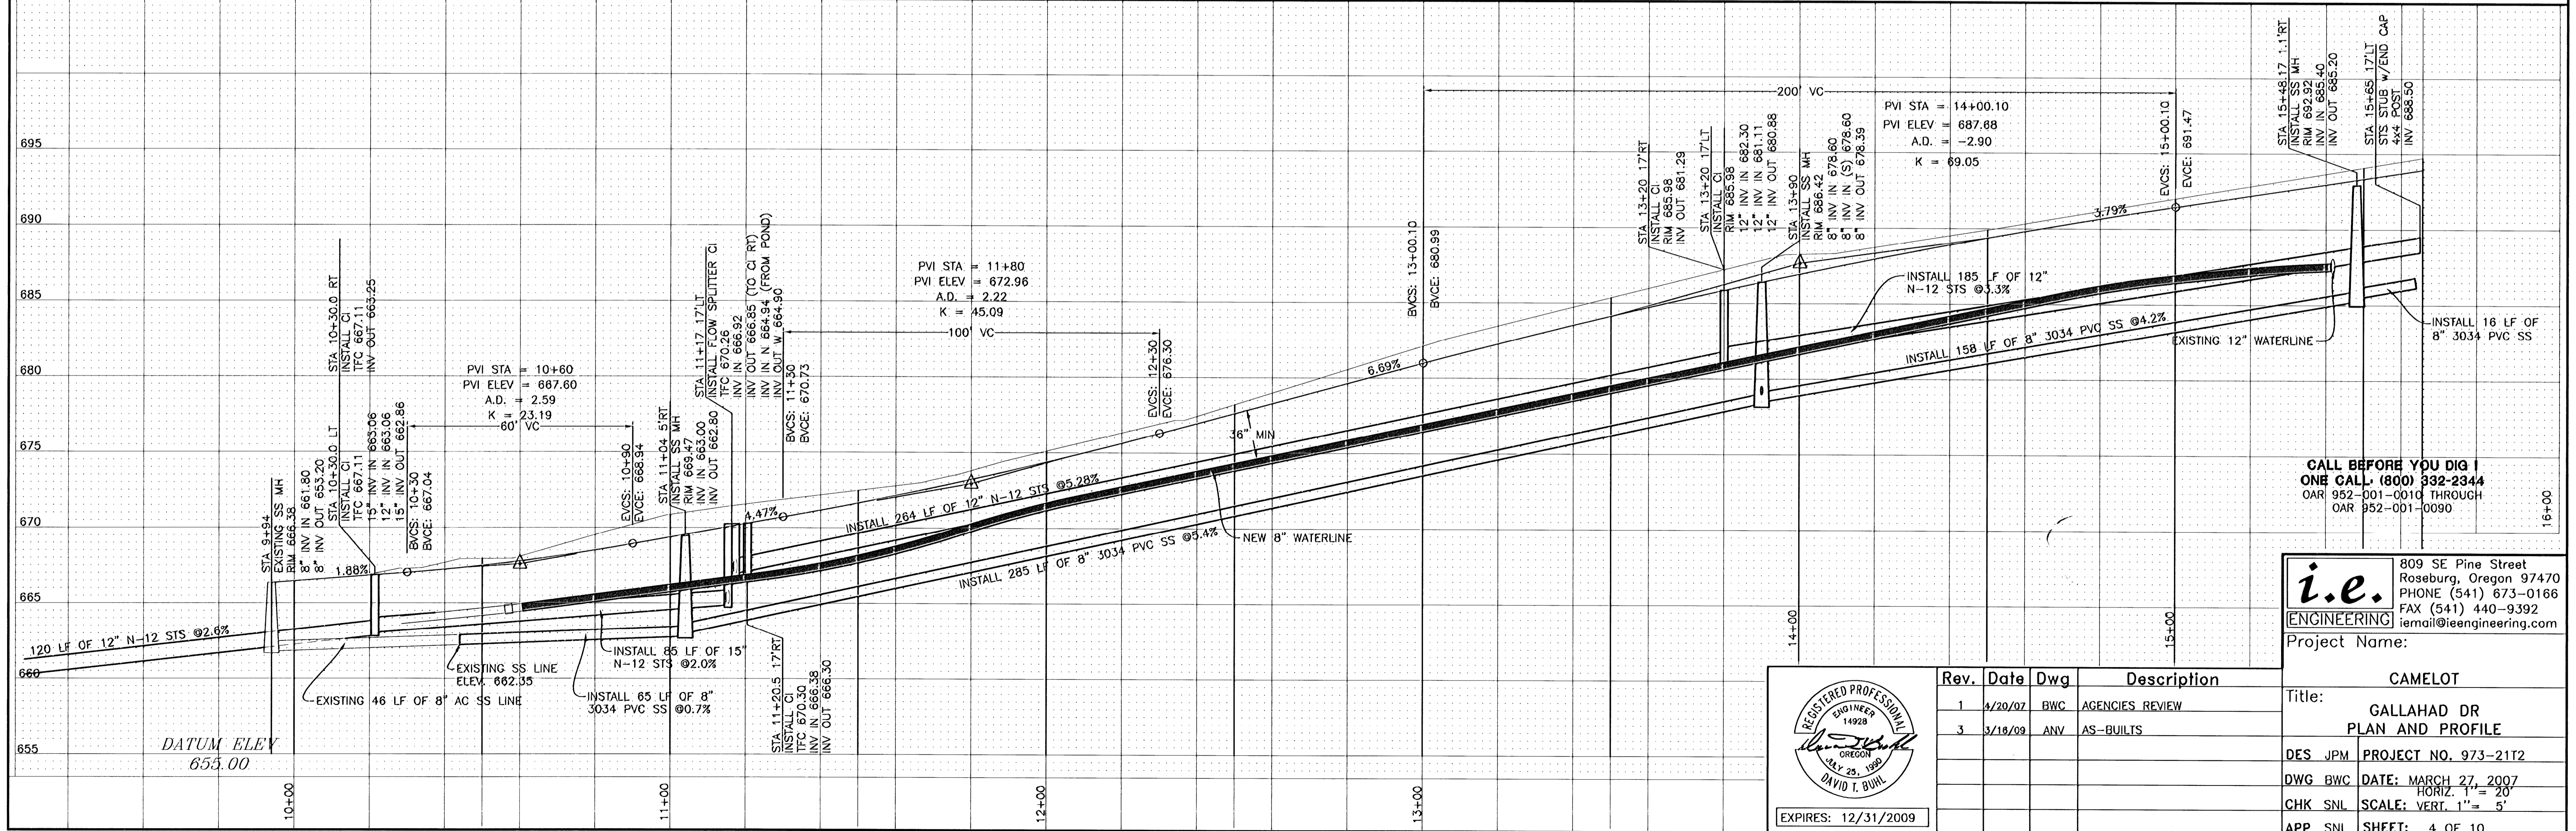

**CALL BEFORE YOU DIG!**  
 ONE CALL (800) 332-2344  
 OAR 952-001-0010 THROUGH  
 OAR 952-001-0090

**i.e.**  
 ENGINEERING  
 809 SE Pine Street  
 Roseburg, Oregon 97470  
 PHONE (541) 673-0166  
 FAX (541) 440-9392  
 iemail@ieengineering.com  
 Project Name:

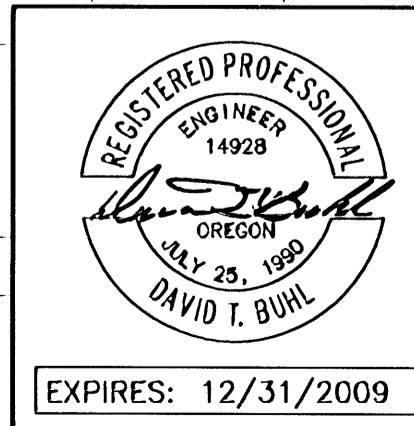

Rev.	Date	Dwg	Description
1	4/20/07	BWC	AGENCIES REVIEW
3	3/18/09	ANV	AS-BUILTS

**CAMELOT**  
 Title: GALLAHAD DR  
 PLAN AND PROFILE  
 DES JPM PROJECT NO. 973-21T2  
 DWG BWC DATE: MARCH 27, 2007  
 HORIZ. 1" = 20'  
 CHK SNL SCALE: VERT. 1" = 5'  
 APP SNL SHEET: 4 OF 10