FILED
Date: 4/18/2012 By: hw
This survey consists of:
Map: DS-122 thru 129
Narrative:
Corner Rpt:
DOUGLAS COUNTY SURVEYOR

DS-124

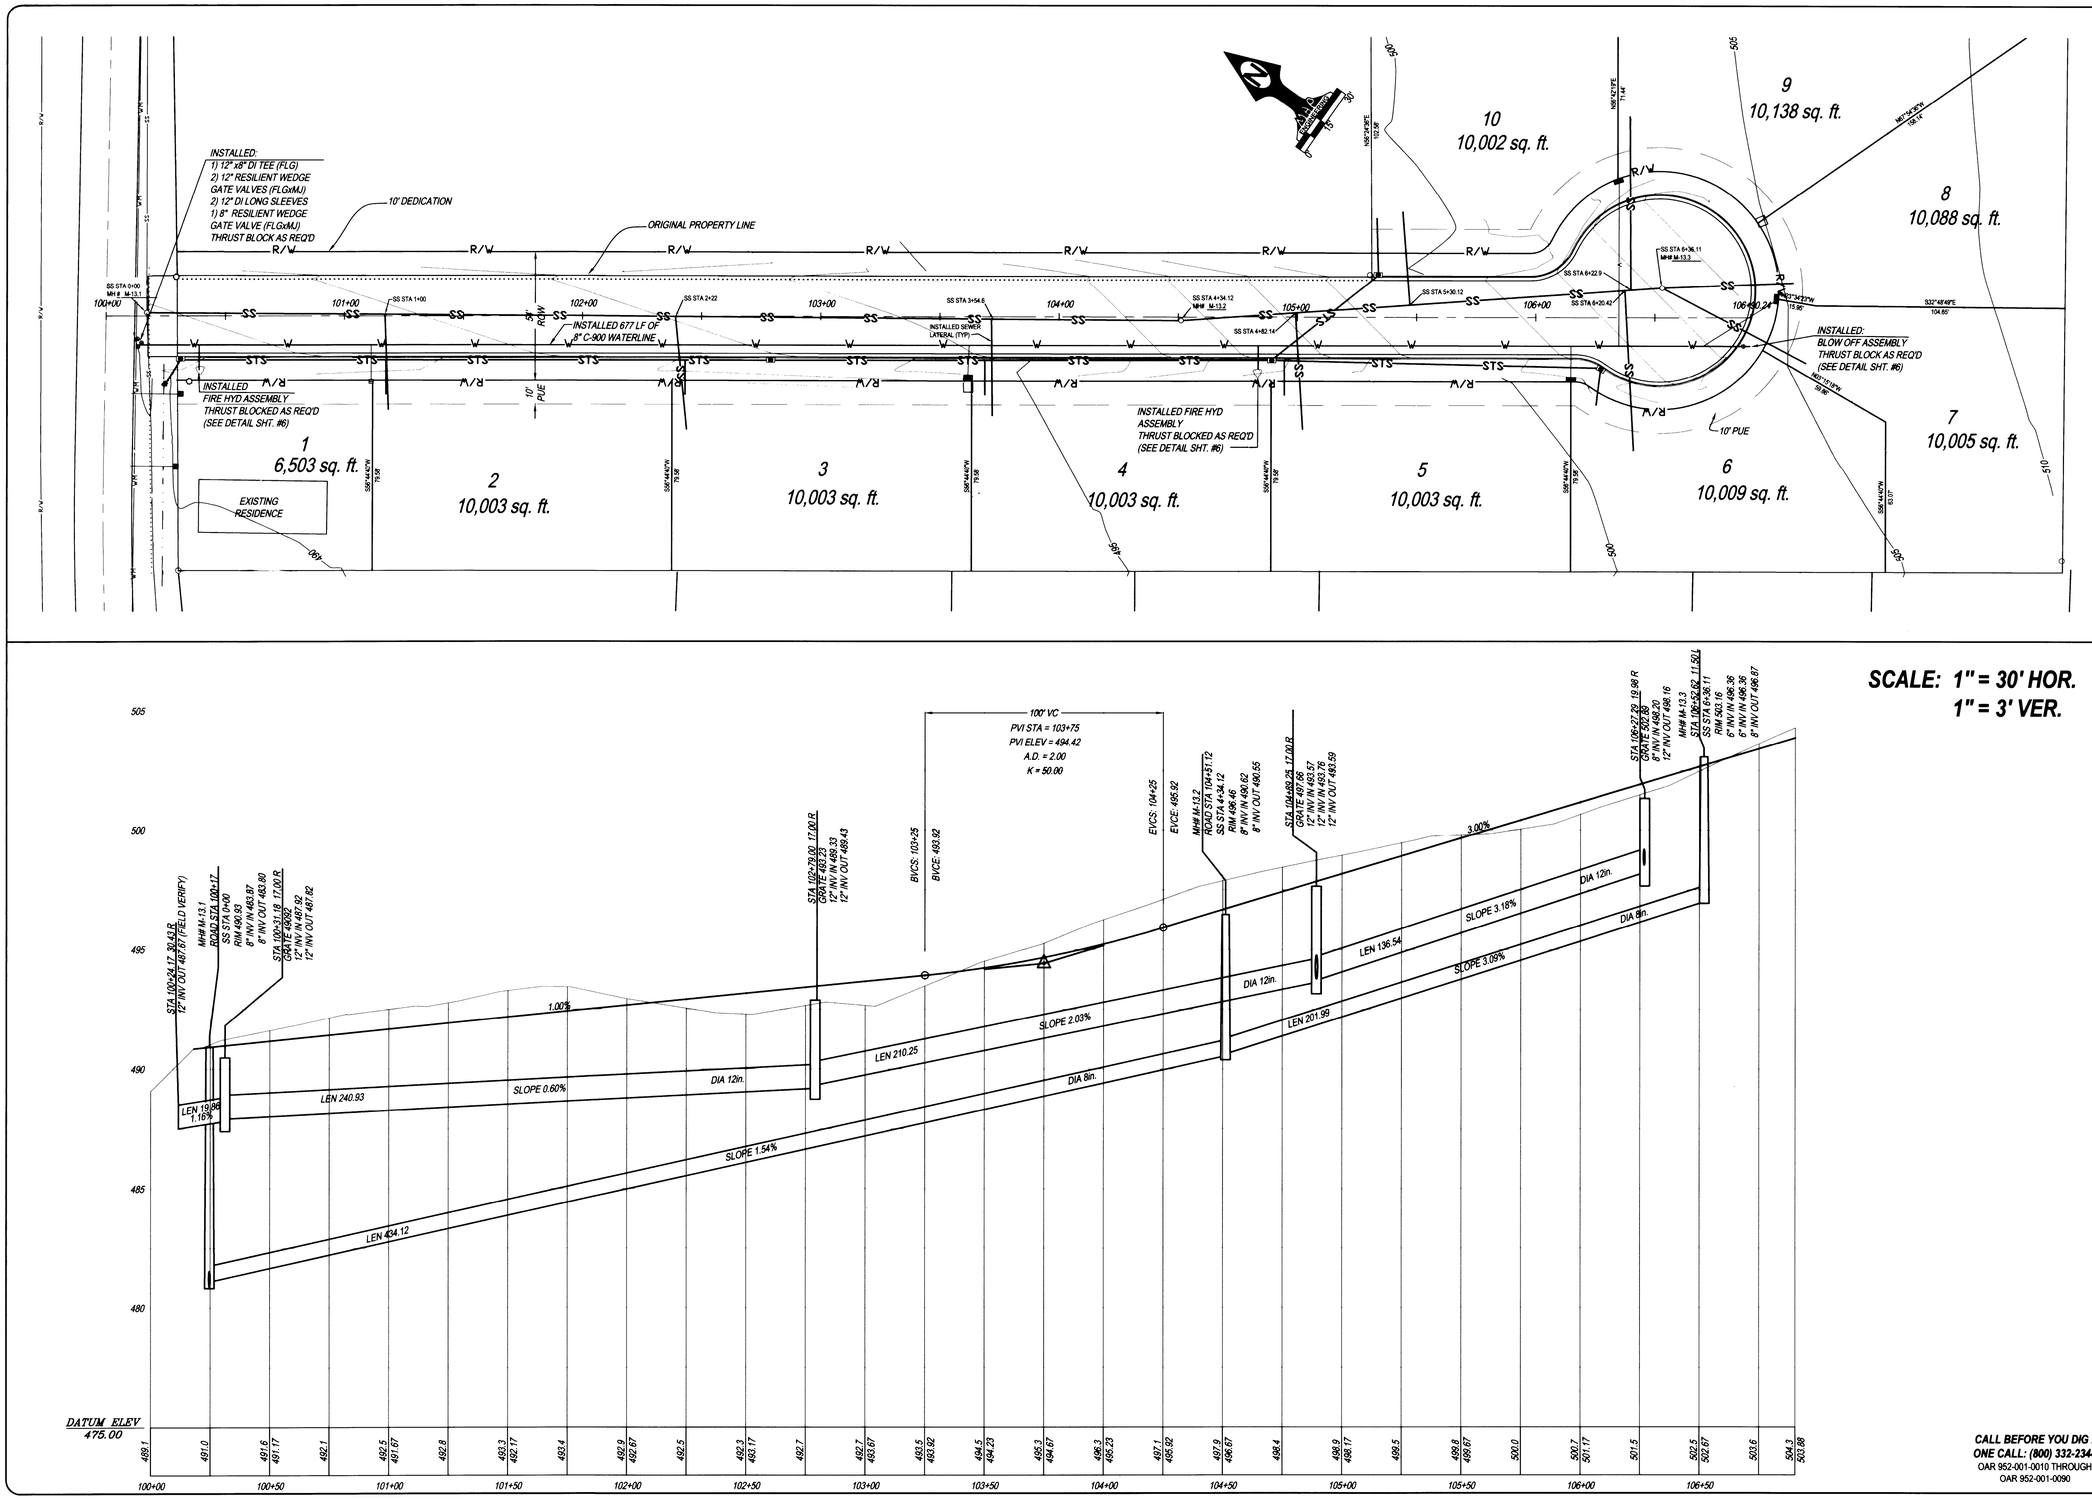

CALL BEFORE YOU DIG !
ONE CALL: (800) 332-2344
OAR 952-001-0010 THROUGH OAR 952-001-0090

SHALL MUST BE SEALED REGISTERED PROFESSIONAL ENGINEER 11,304 OREGON JULY 12, 1971 MIKE A. PARKER
EXPIRATION DATE: 12/31/08

MAP Engineering, Inc.
741 SE JACKSON STREET
ROSEBURG, OREGON 97470
PHONE: (541) 229-0365 FAX: (541) 229-0353
EMAIL: info@mapengineeringinc.com

REVISION #:	BY:	DATE:

PROJECT NAME: KYLEE ESTATES ASBUILT DRAWINGS

DRAWING TITLE: PLAN AND PROFILE

PROJECT NO.: 2065-01 | DWG SCALE: 1"= 30' | DATE: 05/07/2007 | DESIGNER: JCB | DRAFTER: JCB | APPROVAL: MAP

SHEET: 3 OF: 8

DS-124