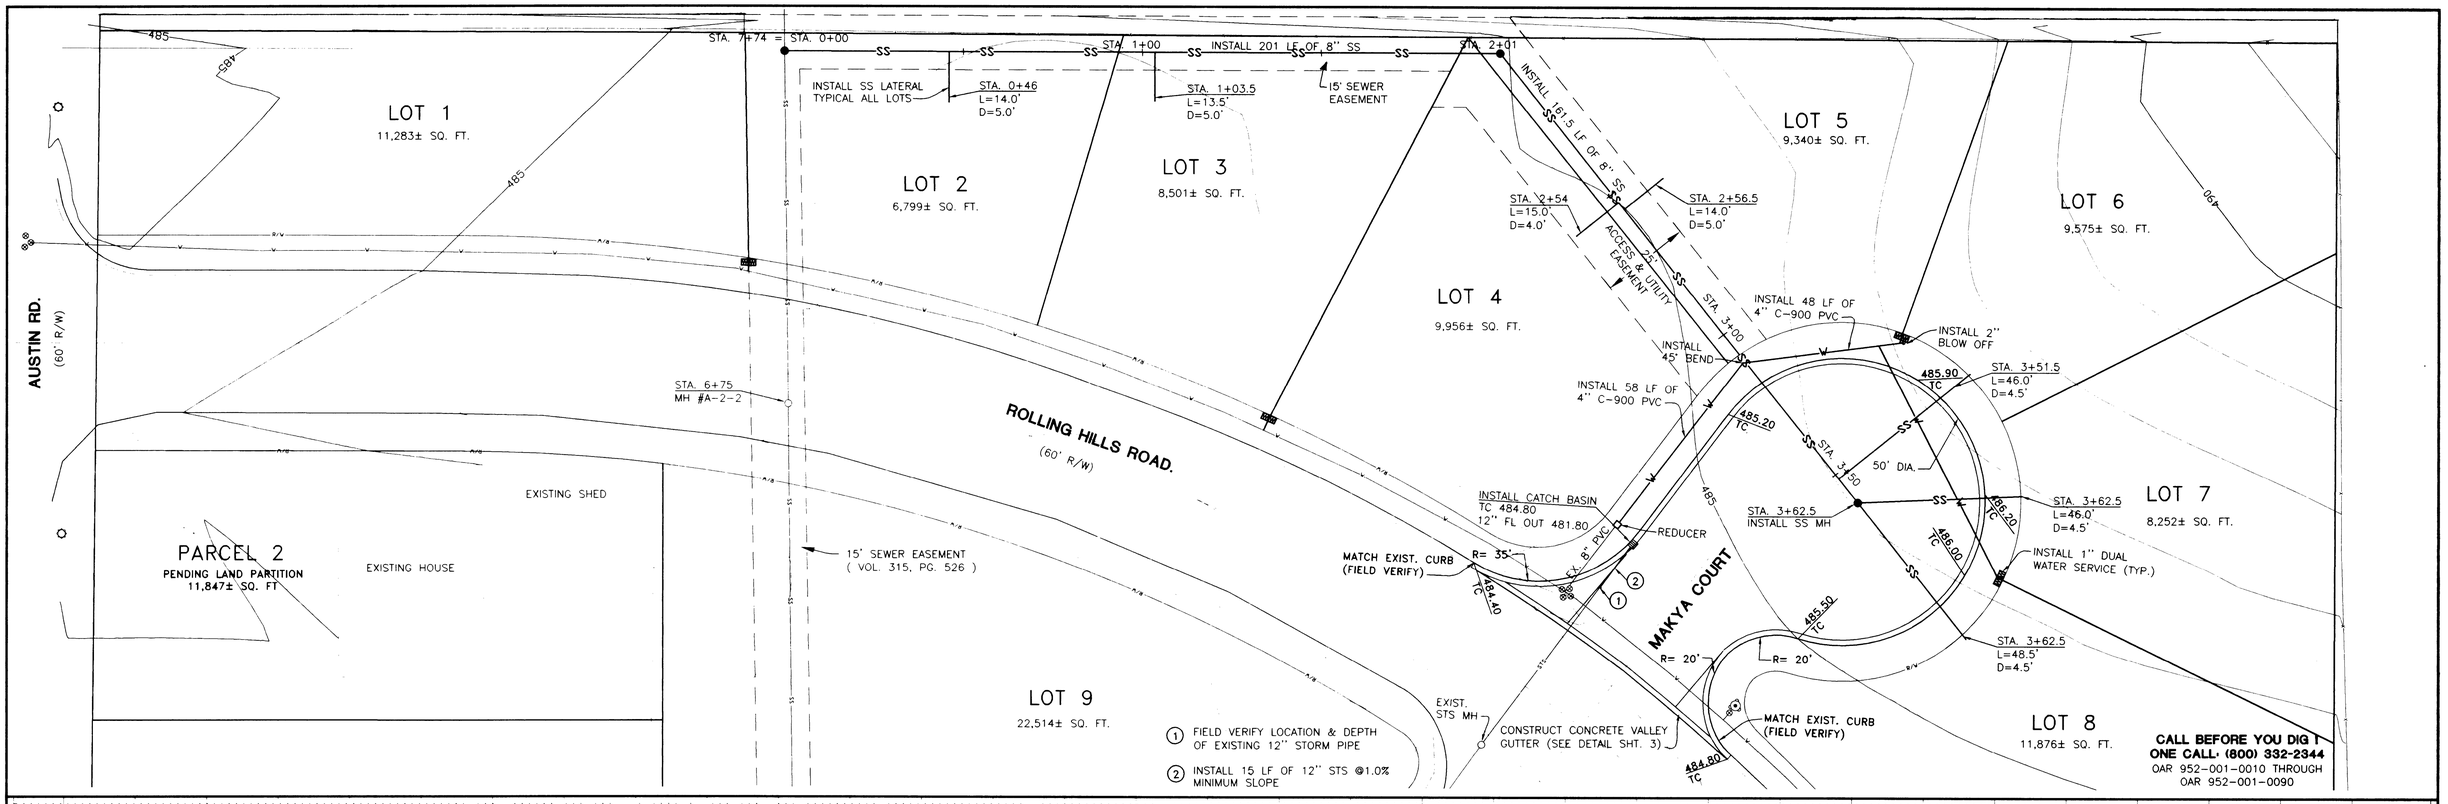

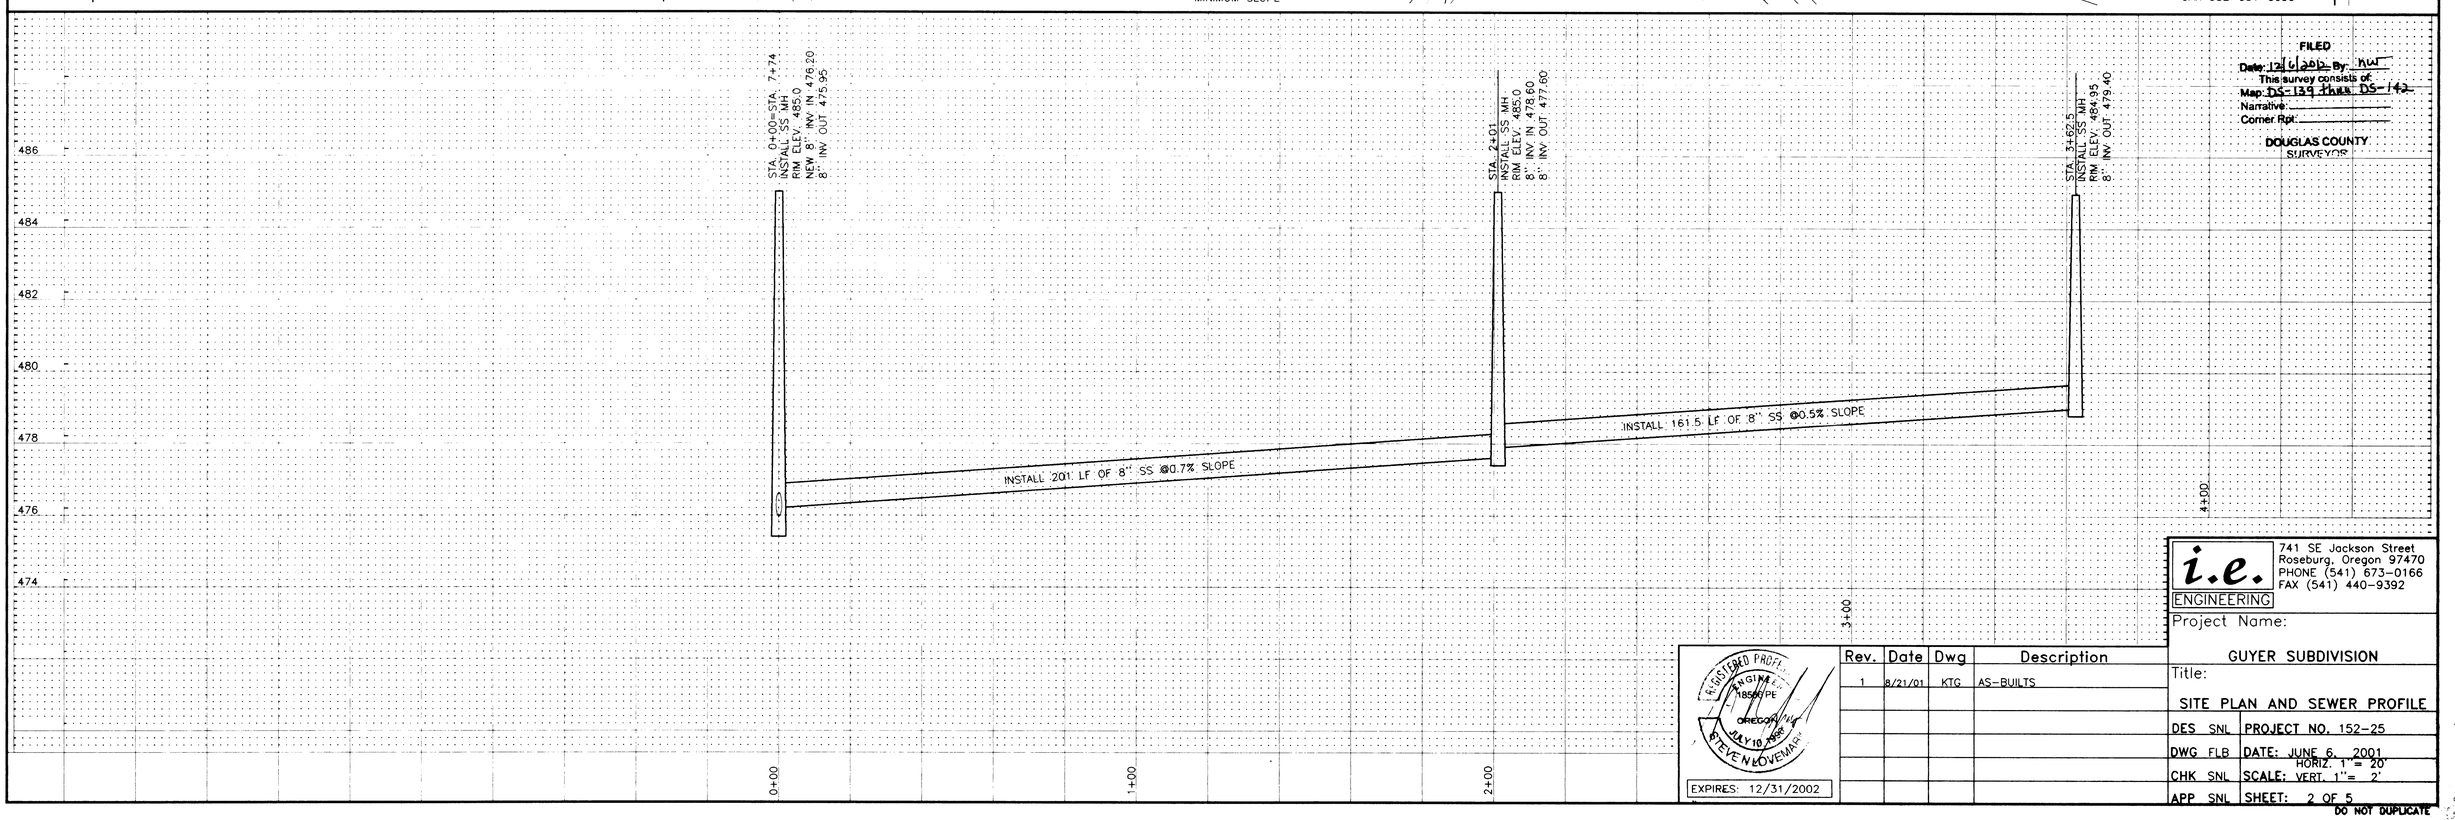

FILED
Date: 12/6/2002 By: MW
This survey consists of:
Map: DS-139 thru DS-142
Narrative:
Corner Rpt:
DOUGLAS COUNTY SURVEYOR

REGISTERED PROFESSIONAL ENGINEER 18500PE OREGON JULY 10, 1980 STEVEN L. NOVEMACH

EXPIRES: 12/31/2002

Rev.	Date	Dwg	Description
1	8/21/01	KTG	AS-BUILTS

i.e. ENGINEERING
741 SE Jackson Street
Roseburg, Oregon 97470
PHONE (541) 673-0166
FAX (541) 440-9392

Project Name: GUYER SUBDIVISION

Title: SITE PLAN AND SEWER PROFILE

DES SNL	PROJECT NO. 152-25
DWG FLB	DATE: JUNE 6, 2001
CHK SNL	SCALE: HORIZ. 1" = 20' VERT. 1" = 2'
APP SNL	SHEET: 2 OF 5

DO NOT DUPLICATE

DS-140