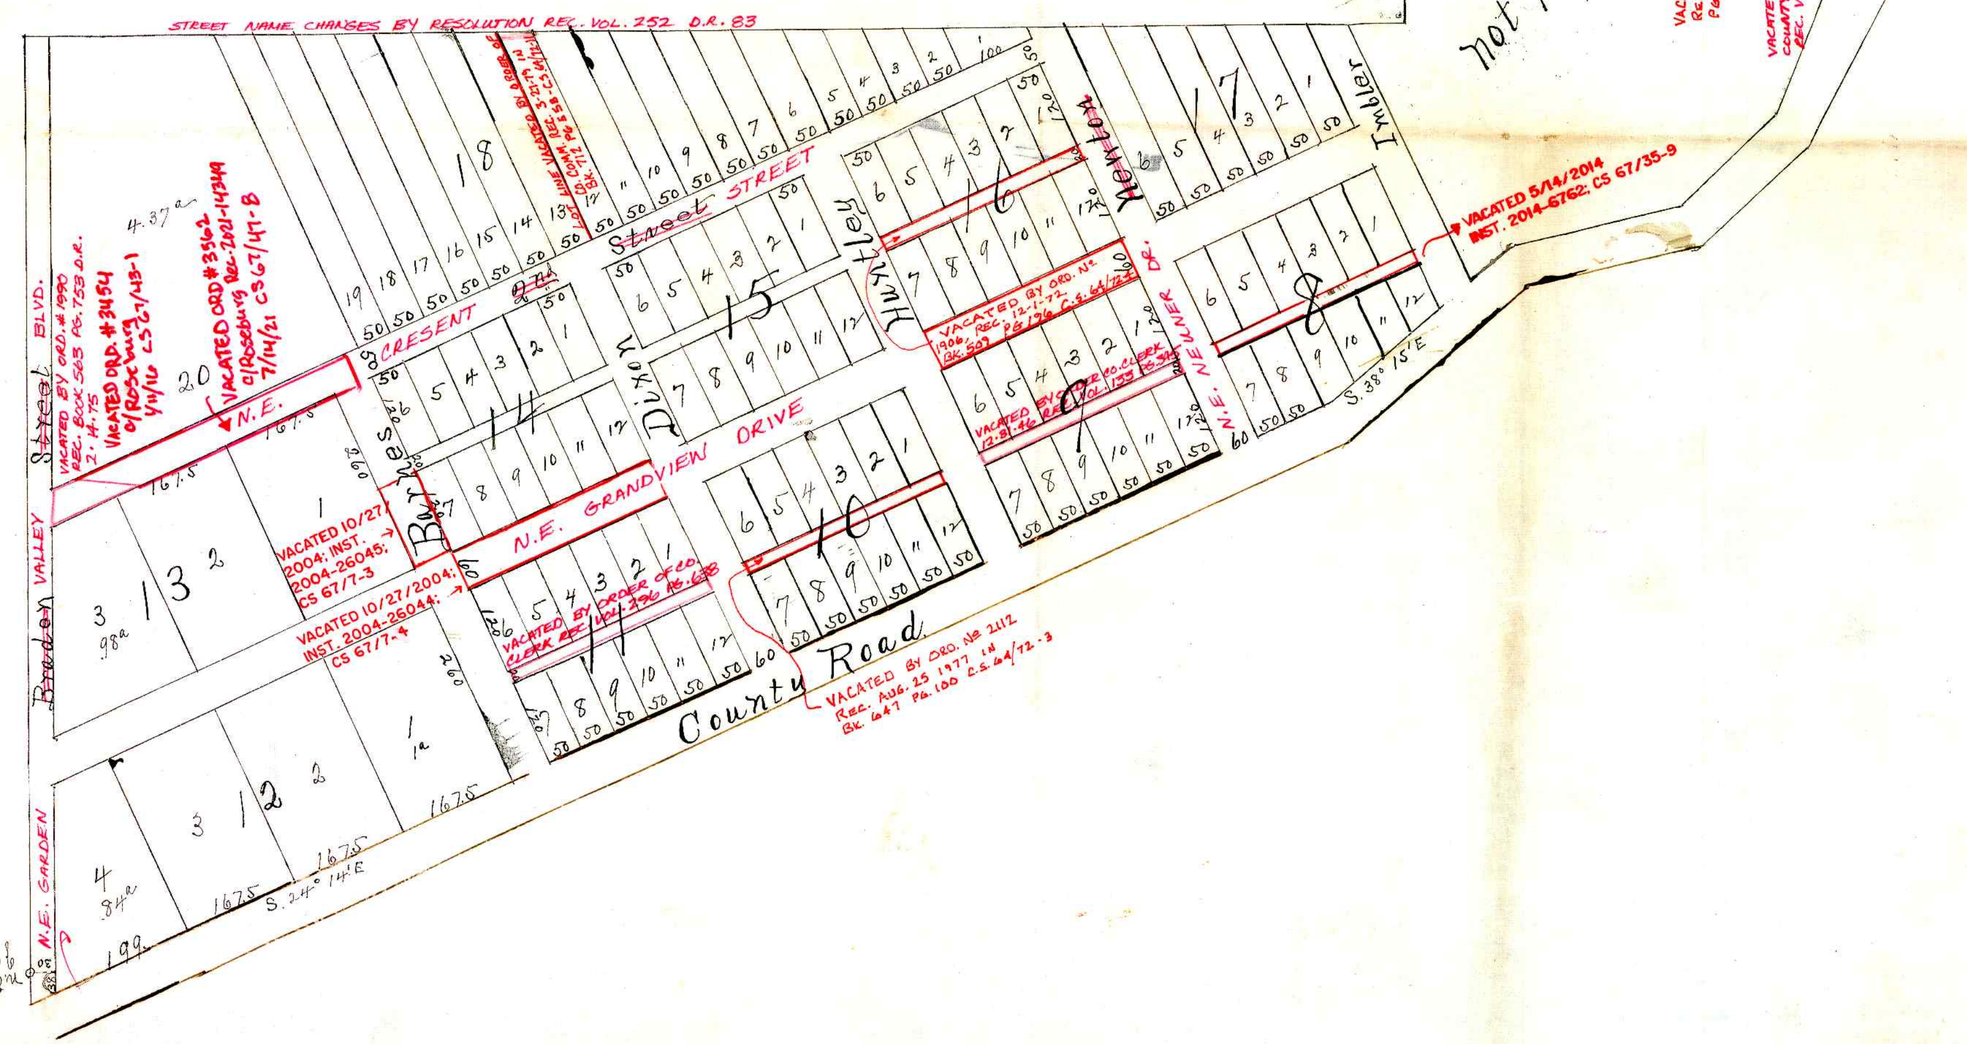JONES' Addition to ROSEBURG.