
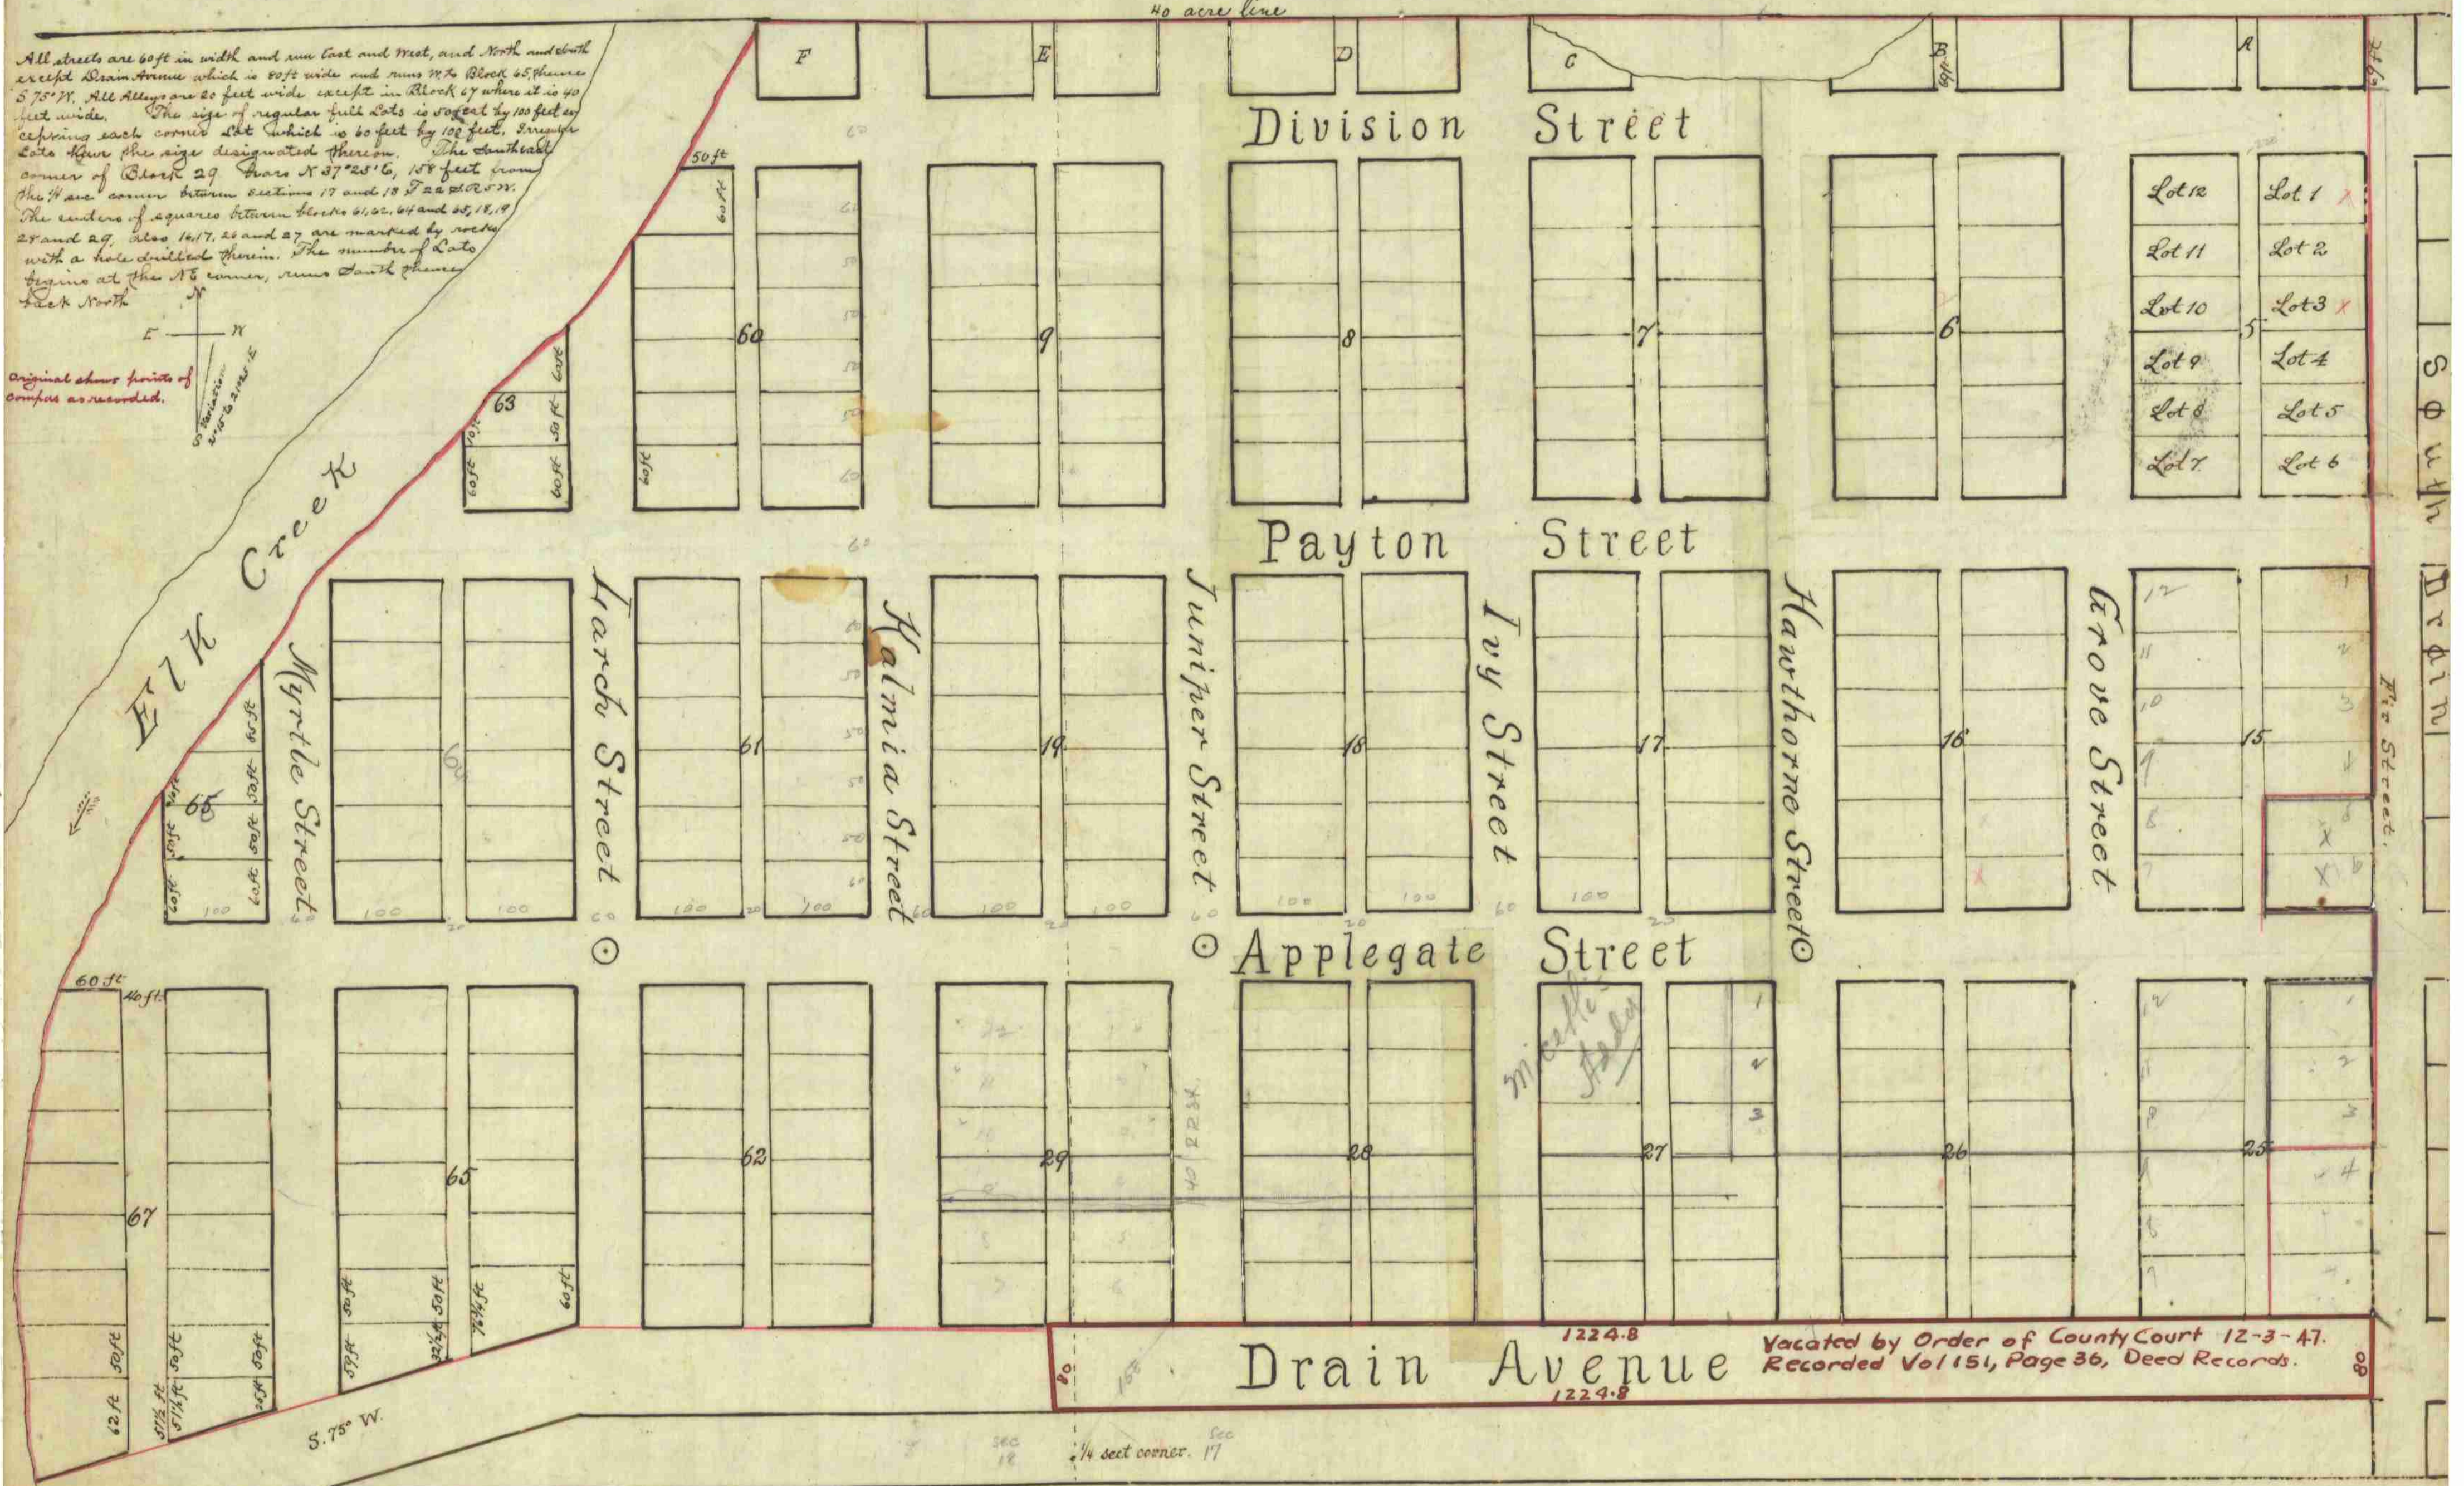




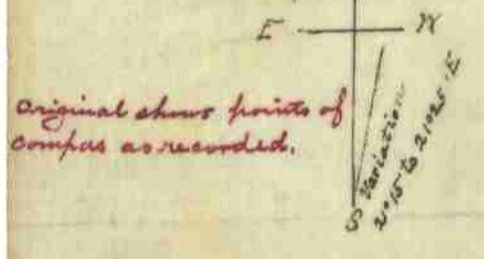

Dedication recorded in Vol 22, Page 567 and 568 of Records of Deeds

Filed and recorded April 19th 1890
 G. A. Taylor County Clerk
 By E. W. Benson Deputy

COLTON'S Addition to DRAIN.

Vacating order. Vol. 7. page. 419. Wed. May 8. 1901.
 all of townsite.

1224-8
 Recorded Vol 151, Page 36, Deed Records.
 1224-8