


OAKLAND OREGON

D.S. BAKER
&
E. G. YOUNG } PROPRIETORS

{ MAIN AND ALL (11) STREETS ARE 80 FT. WIDE, CROSS STREETS ARE 60 FT WIDE }
LOTS ARE -----60 X 120 FEET }

RECORDED AND FILED MARCH 31ST 1868 (SGD) L. L. WILLIAMS, CO. CLERK

FOR ORIGINAL PLAT SEE V. 4, P. 174 DEED RECORDS.

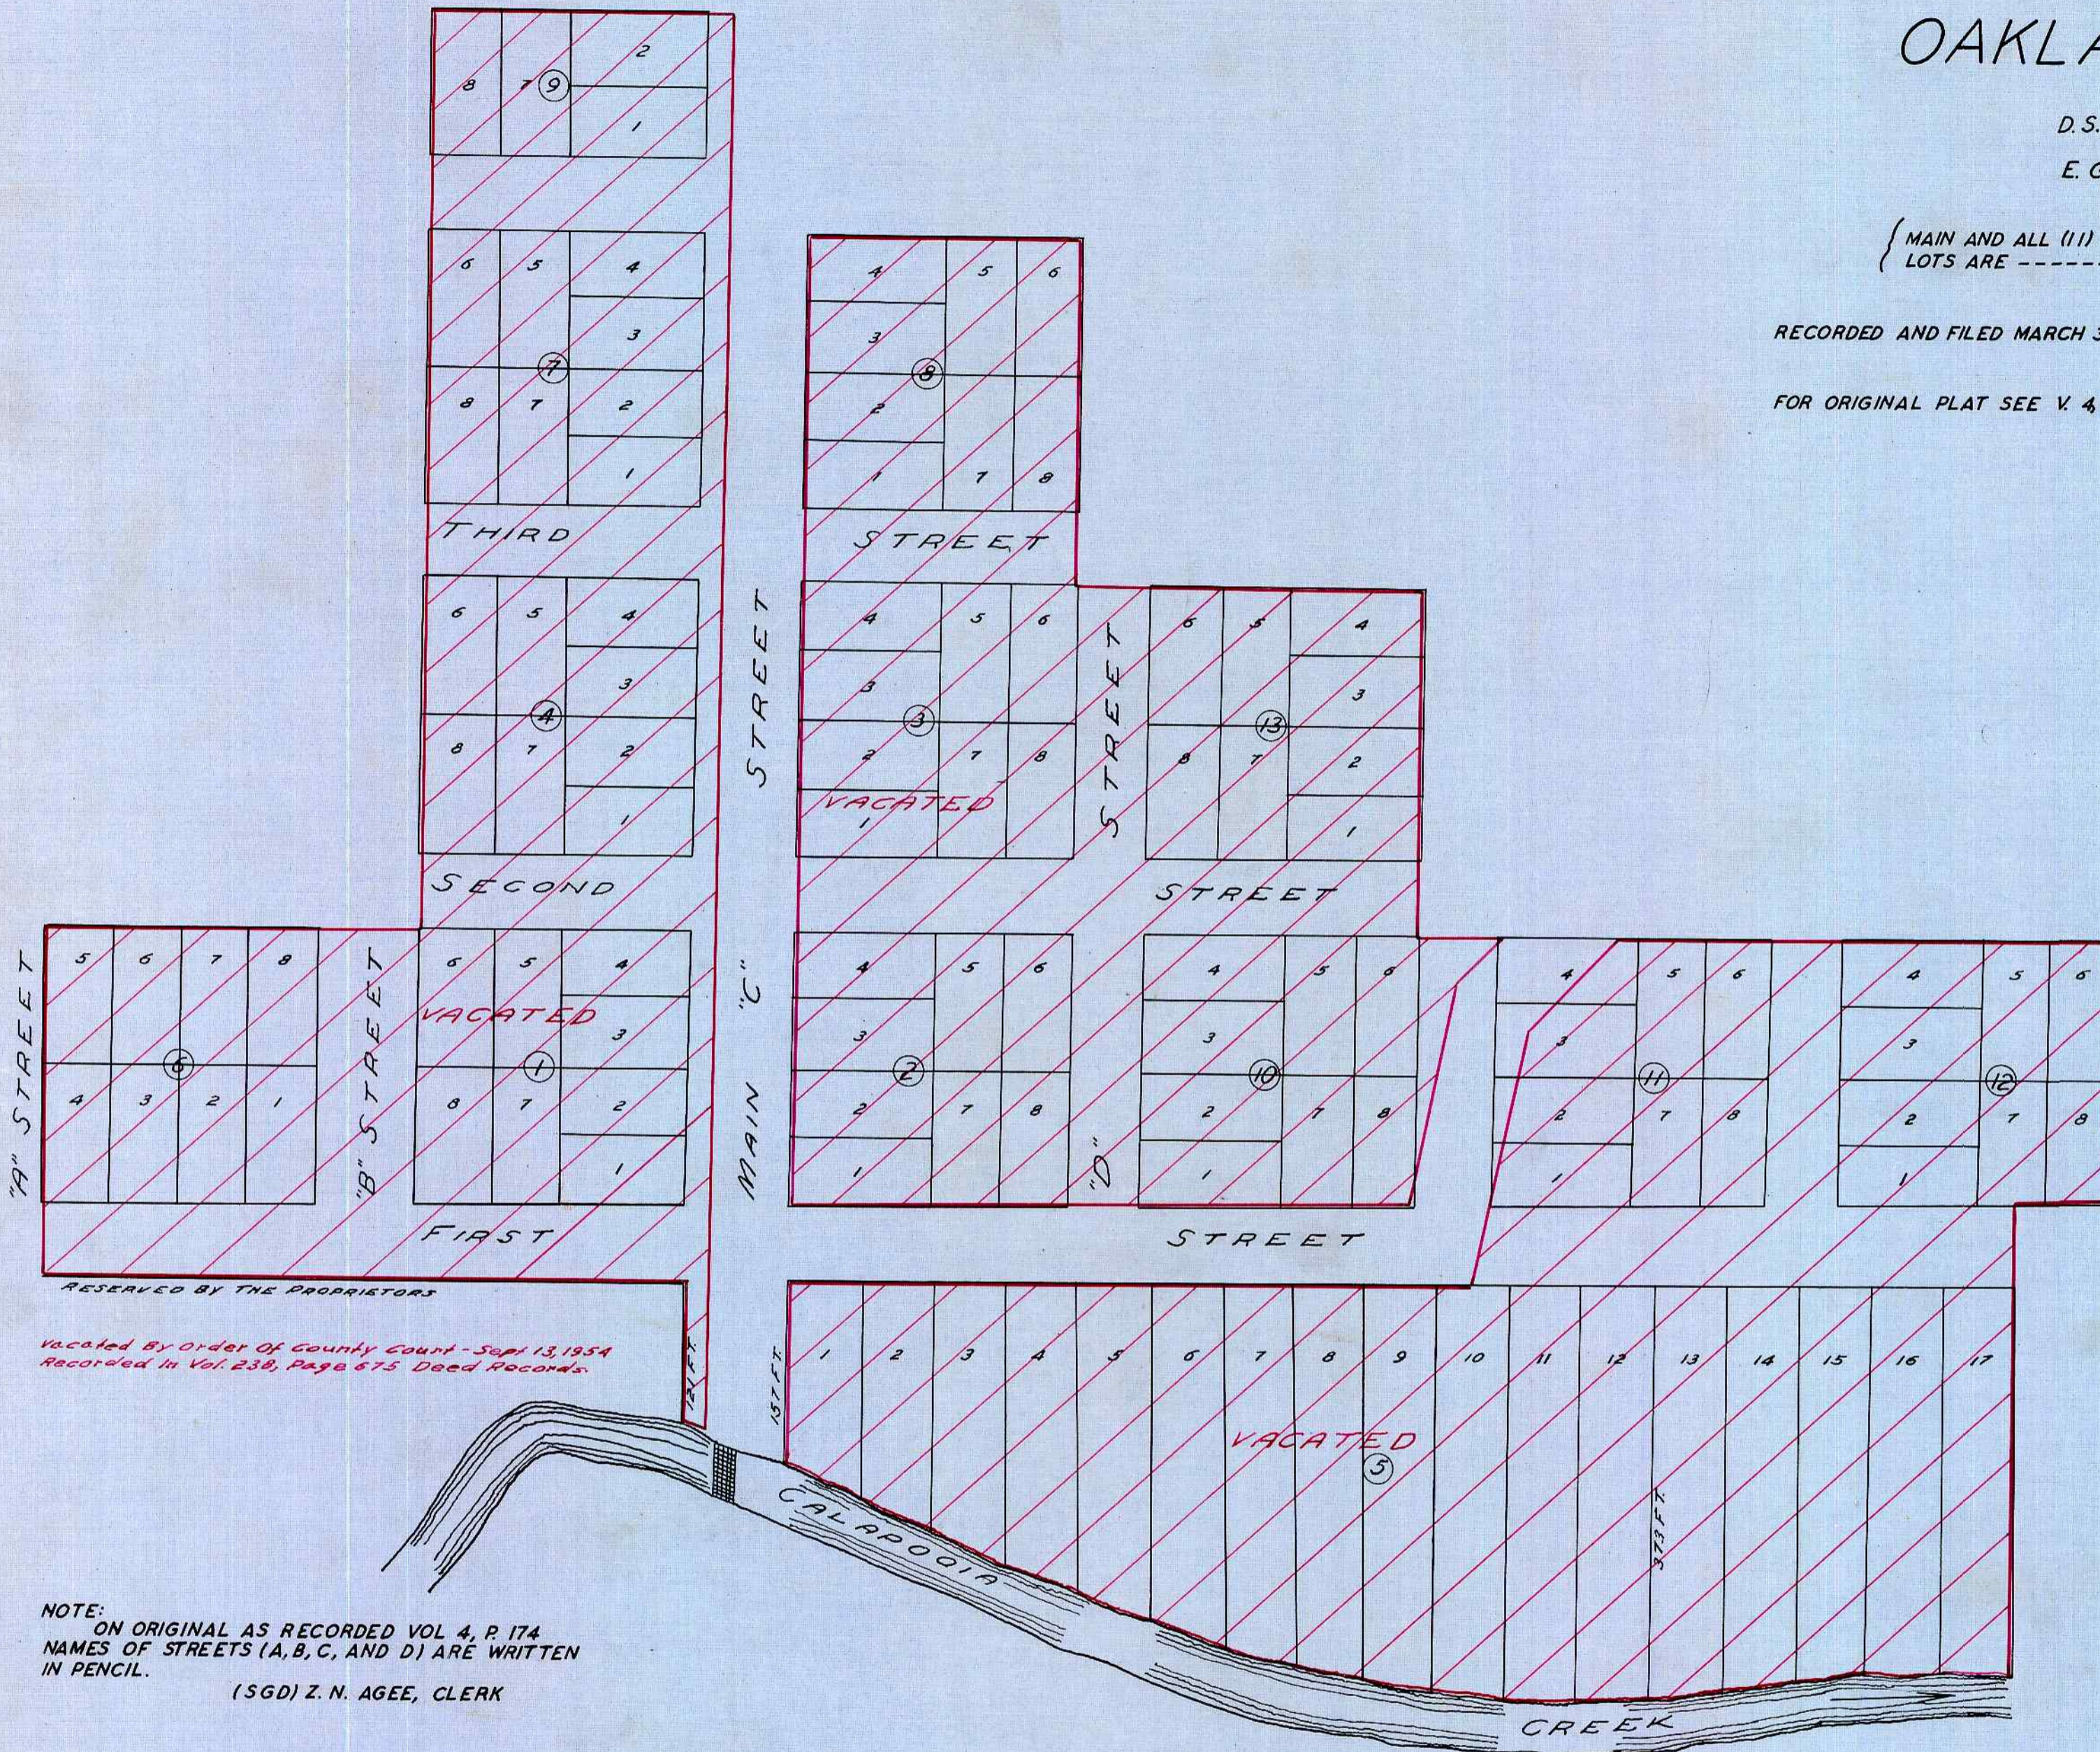

STATE OF OREGON }
COUNTY OF DOUGLAS } ss
I, BEN B. IRVING, COUNTY SURVEYOR OF DOUGLAS COUNTY,
OREGON DO HEREBY CERTIFY THAT THIS COPY OF "OAKLAND"
IS A TRUE AND CORRECT COPY OF THE ORIGINAL PLAT AS FILED
IN THE OFFICE OF THE COUNTY CLERK, AND IS MADE IN
COMPLIANCE WITH CHAPTER 92 OREGON LAWS 1953 SEC. 92-
130.

Ben B. Irving
COUNTY SURVEYOR

SUBSCRIBED AND SWORN TO BEFORE ME THIS 15TH DAY OF
December 1955

Chas. Doerner
COUNTY CLERK

STATE OF OREGON }
COUNTY OF DOUGLAS } ss
I, CHAS. DOERNER COUNTY CLERK OF DOUGLAS COUNTY
OREGON DO HEREBY CERTIFY THAT THE FOREGOING COPY
OF PLAT HAS BEEN BY ME COMPARED WITH THE ORIGINAL
THEREOF THAT IT IS A TRUE AND CORRECT COPY THEREFROM
AND OF THE WHOLE THEREOF AS THE SAME APPEARS ON FILE
IN MY OFFICE AND CUSTODY.
WITNESS MY HAND AND OFFICIAL SEAL THIS 15TH
DAY OF December 1955.

Chas. Doerner
COUNTY CLERK

NOTE:
ON ORIGINAL AS RECORDED VOL 4, P. 174
NAMES OF STREETS (A, B, C, AND D) ARE WRITTEN
IN PENCIL.
(SGD) Z. N. AGEE, CLERK