2/32

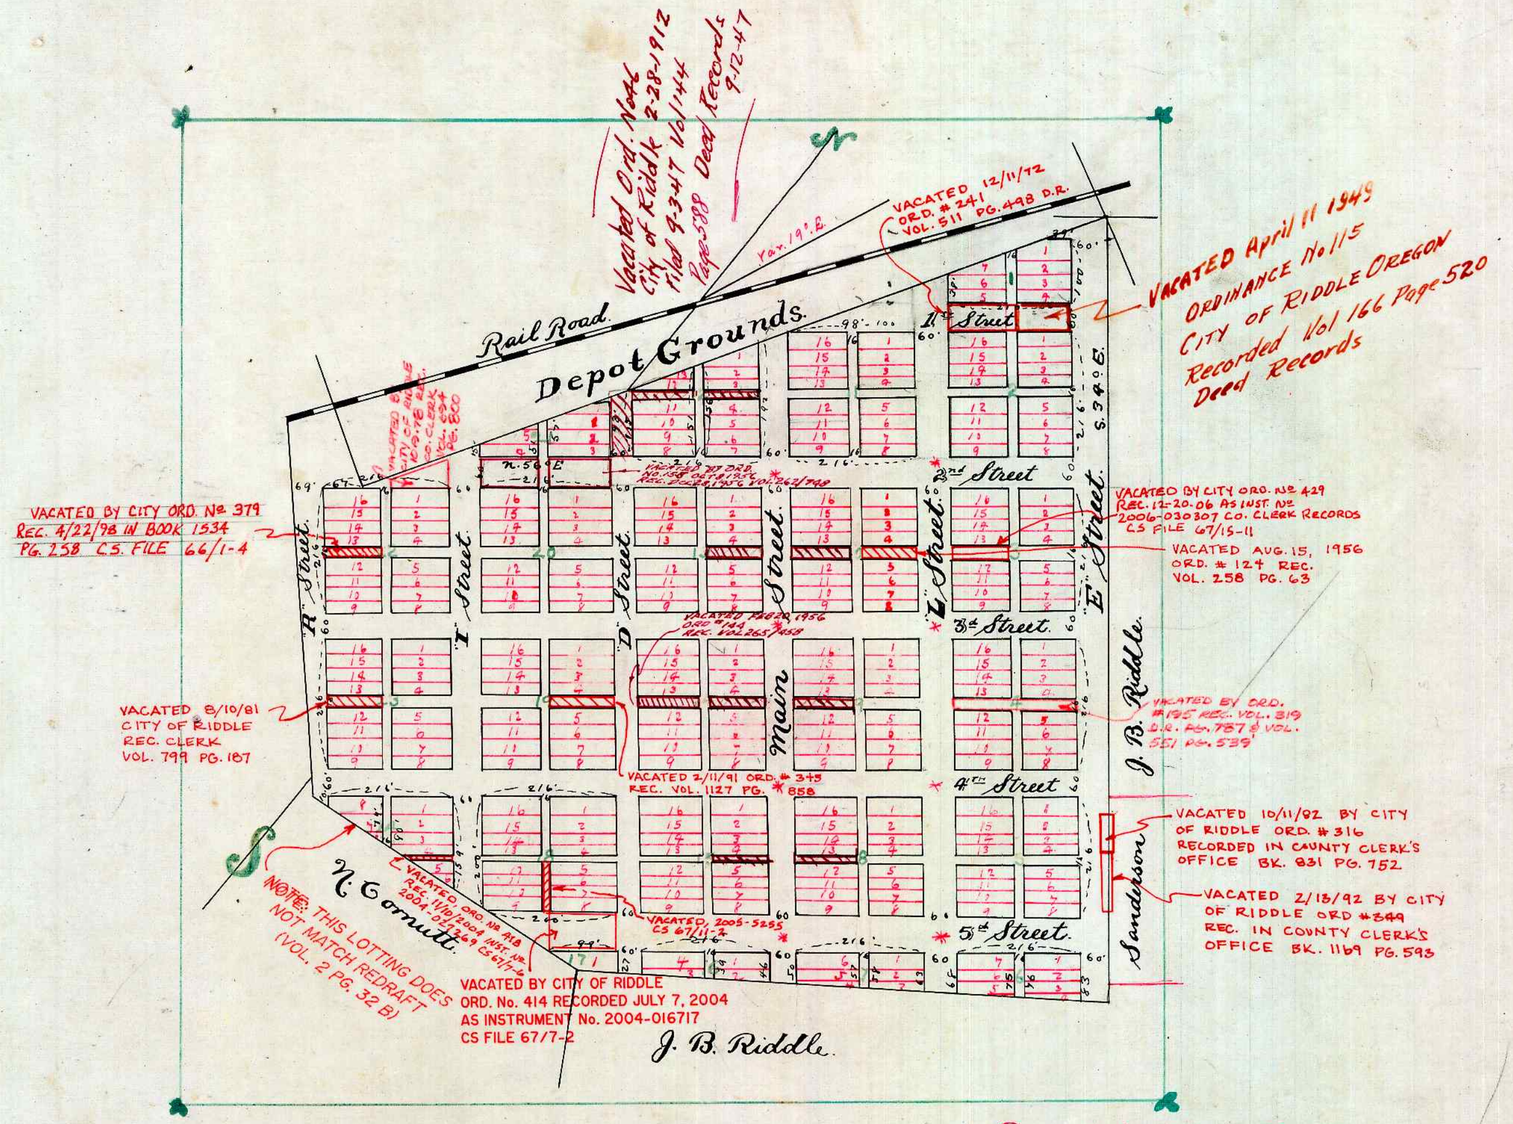

Recorded 28th april 1882.
T. R. Sheridan. Co. Clerk.
by. W. T. Wright. Dpty.

Riddle. Oregon.

For Dedication see original Sec. Vol. 12 p. 699. Record of Deeds

Town 30
Range 6
Sec 23 & 24