MYRTLE HEIGHTS ADDITION
TO
MYRTLE CREEK

SCALE 1" = 100'

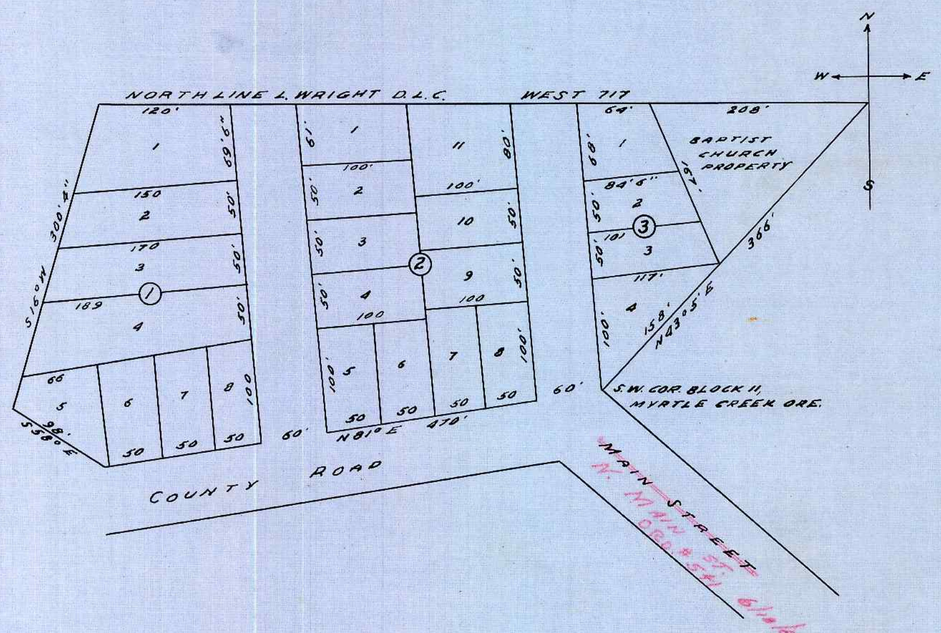

KNOW ALL MEN BY THESE PRESENTS: THAT N. H. LAMB THE OWNER OF THE LAND SHOWN ON THE ANNEXED PLAT HAS CAUSED THE SAME TO BE SURVEYED AND PLATTED AS MYRTLE HEIGHTS ADDITION TO MYRTLE CREEK ORE. AND DOES HEREBY DEDICATE TO THE PUBLIC USE THE STREETS SHOWN HEREON.

WITNESS MY HAND AND SEAL THIS 30 DAY OF NOV. 1907, IN PRESENCE OF

(SGD) B. J. HOWLAND } (SGD) N. H. LAMB (SEAL)
(SGD) C. O. NELSON }

STATE OF OREGON } SS
COUNTY OF DOUGLAS }

ON THE 30 DAY OF NOV., 1907 PERSONALLY APPEARED BEFORE ME N. H. LAMB AND ACKNOWLEDGED TO ME THAT HE EXECUTED THE FOREGOING DEDICATION FOR THE USES THEREIN NAMED.

WITNESS MY HAND AND OFFICIAL SEAL THE DAY AND YEAR LAST ABOVE WRITTEN.

(SEAL) (SGD) BURT J. HOWLAND
NOTARY PUBLIC
FOR OREGON

SURVEYED NOV. 20, 1907, BY C. E. ROBERTS DEPUTY COUNTY SURVEYOR.

STATE OF OREGON } SS
COUNTY OF DOUGLAS }

I, FRED M. DARBY, COUNTY SURVEYOR OF DOUGLAS COUNTY OREGON, DO HEREBY CERTIFY THAT THIS COPY OF "MYRTLE HEIGHTS ADDITION TO MYRTLE CREEK" IS A TRUE AND CORRECT COPY OF THE ORIGINAL PLAT AS FILED IN THE OFFICE OF THE COUNTY CLERK, AND IS MADE IN COMPLIANCE WITH CHAPTER 92 OREGON LAWS 1953, SEC. 92-130.

Fred M. Darby
COUNTY SURVEYOR

SUBSCRIBED AND SWORN TO BEFORE ME THIS 26th DAY OF March, 1958.

Chas Doerner
COUNTY CLERK

STATE OF OREGON } SS
COUNTY OF DOUGLAS }

I, CHAS. DOERNER, COUNTY CLERK OF DOUGLAS COUNTY OREGON, DO HEREBY CERTIFY THAT THE FOREGOING COPY OF PLAT HAS BEEN BY ME COMPARED WITH THE ORIGINAL THEREOF THAT IT IS A TRUE AND CORRECT COPY THEREFROM AND OF THE WHOLE THEREOF AS THE SAME APPEARS ON FILE IN MY OFFICE AND CUSTODY.

WITNESS MY HAND AND OFFICIAL SEAL THIS 26th DAY OF March, 1958.

Chas Doerner
COUNTY CLERK