
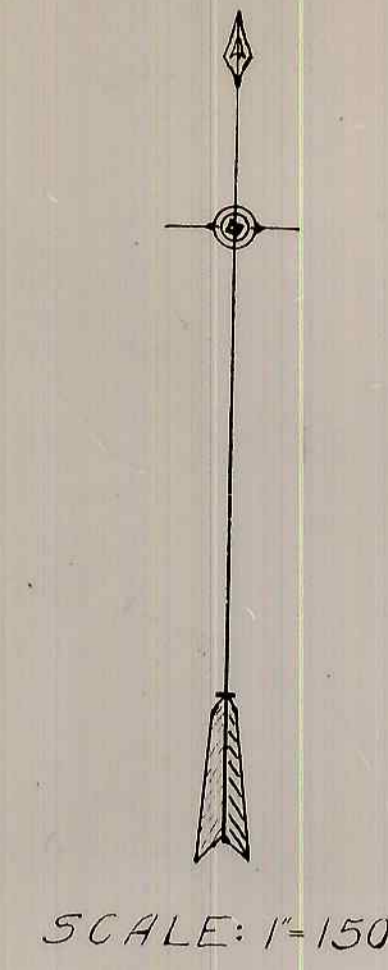


MILLER'S ADDITION TO ROSEBURG OREGON

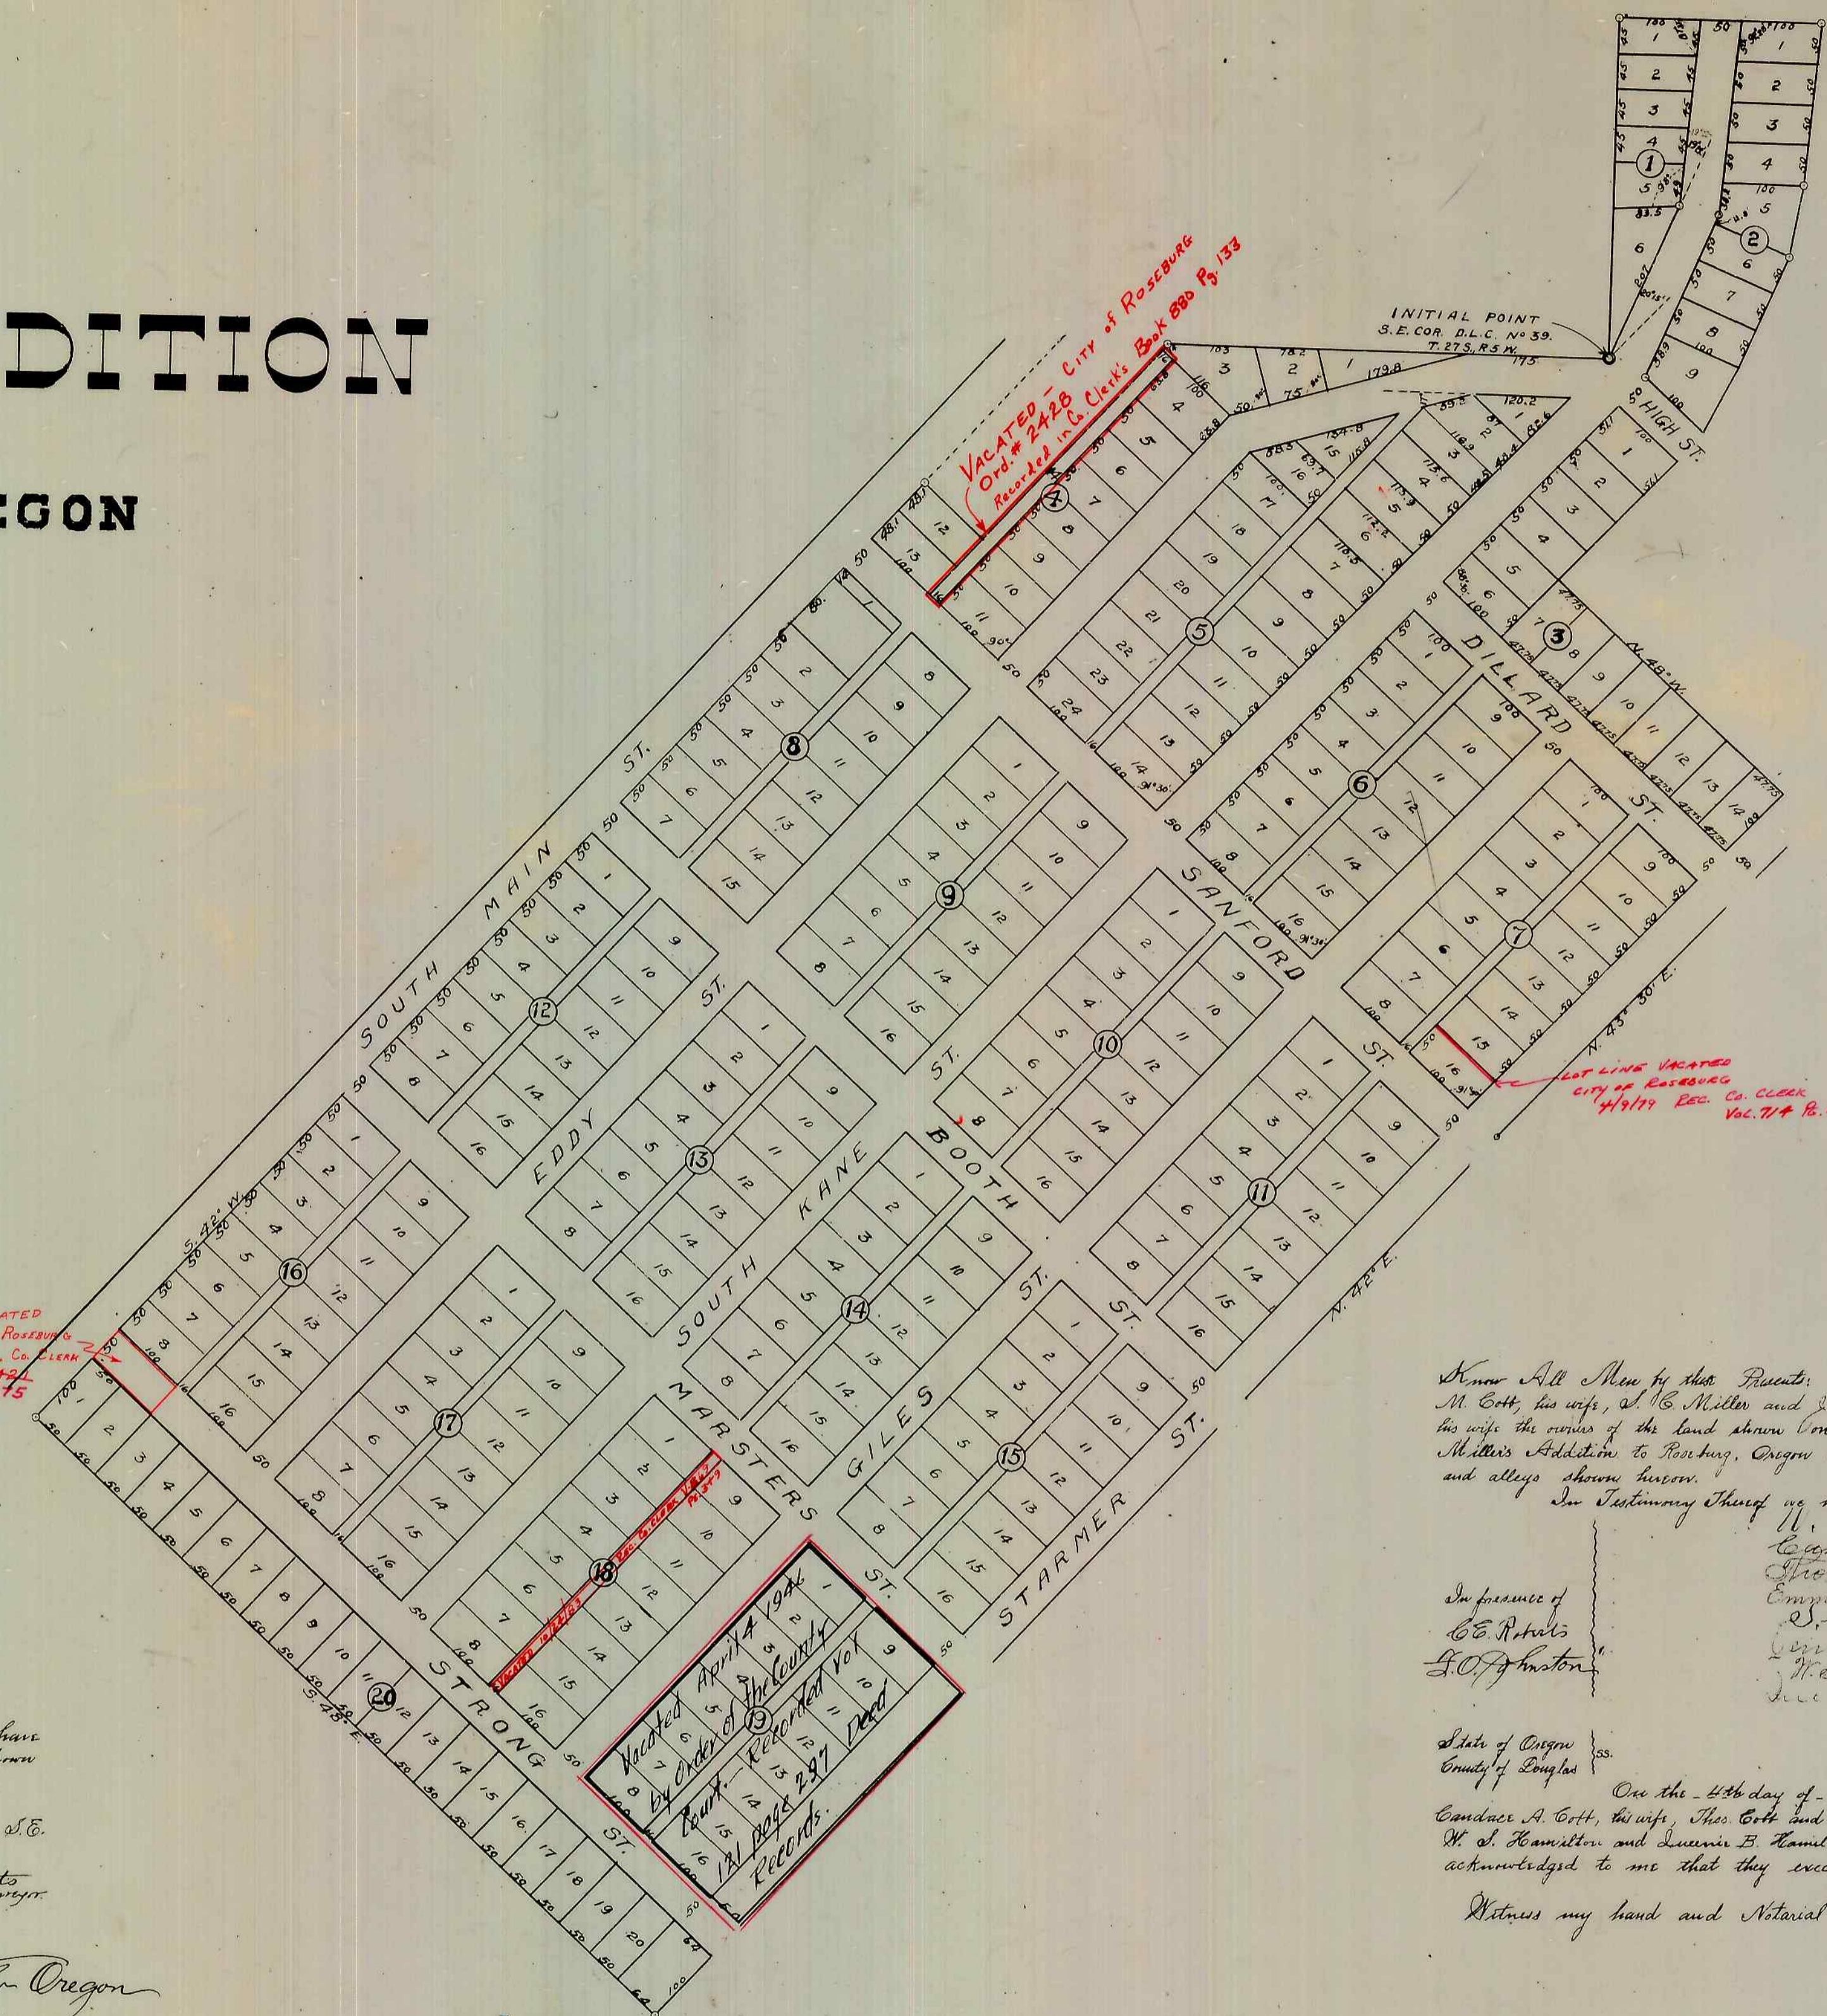

CERTIFICATE

State of Oregon }
County of Douglas }
I, C. E. Roberts being first duly sworn depose and say that I have correctly surveyed and marked with proper monuments the lands shown on the plat, that angles, courses and distances marked thereon are a true representation and description of said survey.
Subscribed and sworn to before me this 4th day of March 1911.
C. E. Roberts
Surveyor
J. O. Johnston
Notary Public for Oregon

Approved 3/4 1911
W. B. Gemund
City Engineer

Approved mch 13th 1911
Frank Cain
Co Surveyor

Approved 3/4/11
J. L. Collins
Assessor

Approved March Term 1911
W. M. Monroeth
Co. Judge

DEDICATION

forever the streets and alleys shown hereon.
In testimony whereof we have hereunto set our hands and seals this 4th day of March - 1911

In presence of
C. E. Roberts
J. O. Johnston

W. L. Cott
Constance A. Cott
Thos. Cott
Emma M. Cott
J. C. Miller
Jennie Miller
W. B. Hamilton
Lucretia B. Hamilton

State of Oregon }
County of Douglas }


Witness my hand and Notarial Seal the day and year last above written.
J. O. Johnston
Notary Public for Oregon.

FILED

MAR 4 1911
E. A. Lenox
COUNTY CLERK
Carl Ellwberry
DEPUTY CLERK