4/78

GREEN

Located in Sec. 11, T. 28 S., R. 6 W., W.M.
Douglas County, Oregon.

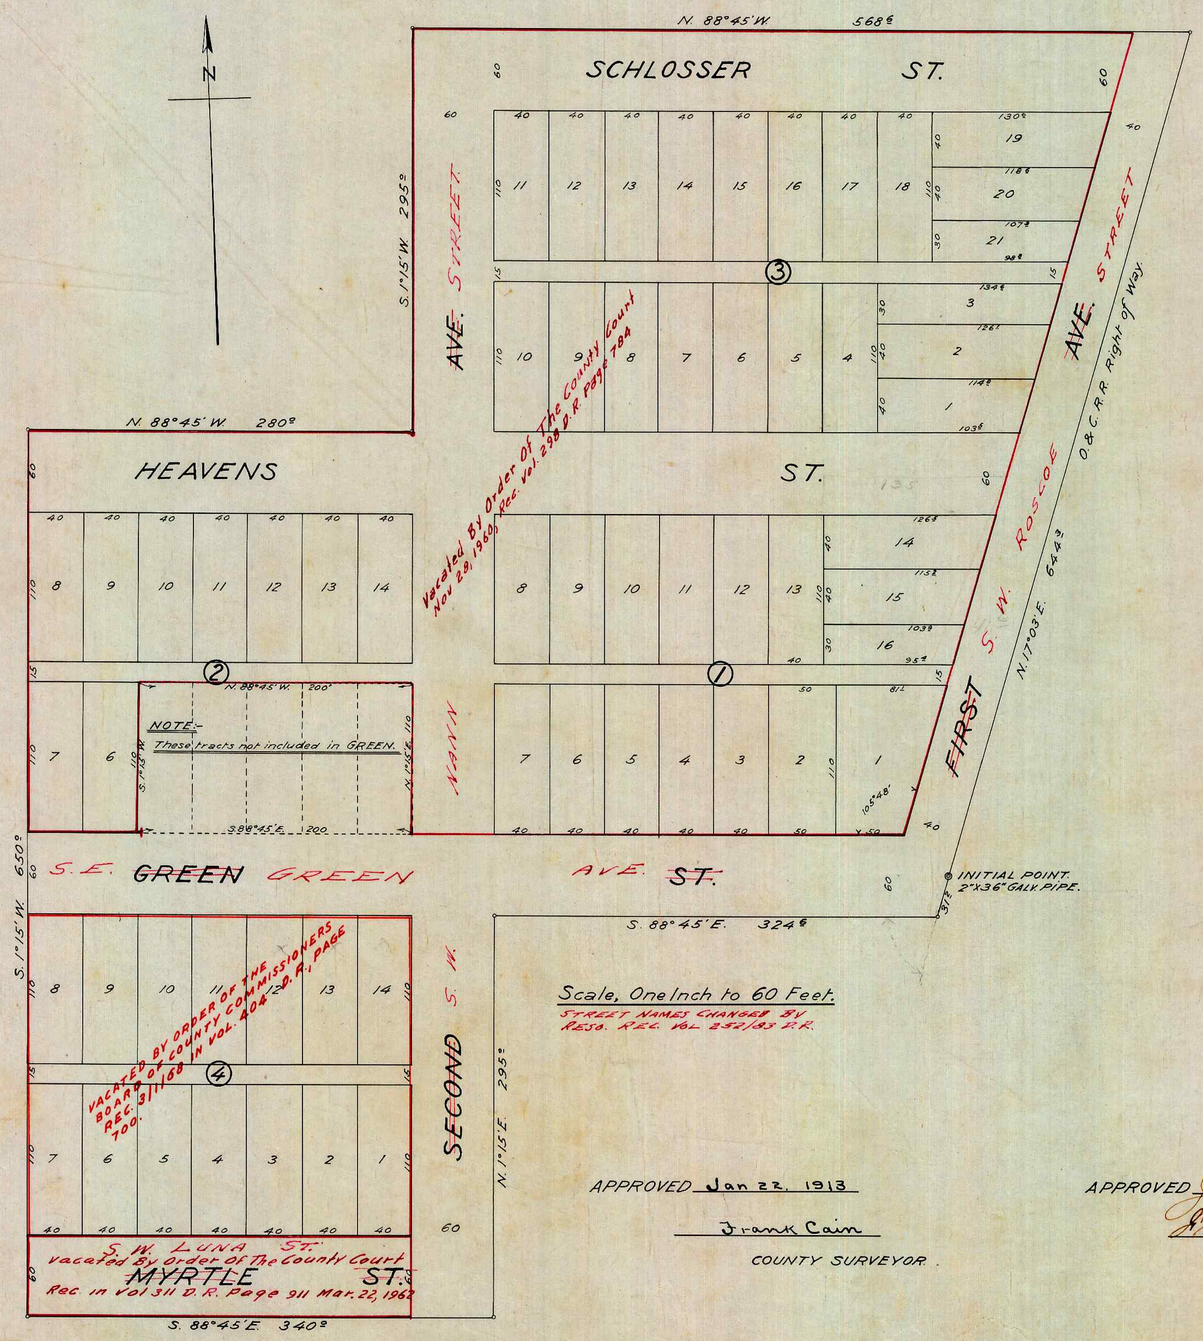

DEDICATION.

KNOW ALL MEN BY THESE PRESENTS that Robert U. Green and Myrtle Green, his wife, Roscoe N. Green and Nannie E. Green, his wife, G. P. Schlosser and Luna S. Schlosser, his wife, owners of the real property shown in the annexed plat have caused the same to be surveyed and platted as GREEN and we hereby dedicate to the public use forever the roads shown thereon. IN WITNESS WHEREOF we have hereunto set our hands and seals this 22nd day of January, 1913.

Witness: C. C. Boyer
Frank Cain

Robert U. Green (SEAL)
Myrtle Green (SEAL)
Roscoe N. Green (SEAL)
Nannie E. Green (SEAL)
G. P. Schlosser (SEAL)
Luna S. Schlosser (SEAL)

State of Oregon
County of Douglas } s.s.

On this 22nd day of January, 1913, before me personally appeared the within named Robert U. Green and Myrtle Green, his wife, Roscoe Green and Nannie E. Green, his wife, G. P. Schlosser and Luna S. Schlosser, his wife, who being known to me to be the identical persons described in and who executed the within instrument, and acknowledged to me that they executed the same. IN TESTIMONY WHEREOF, I have hereunto set my hand and notarial seal the day and year above written.

Frank Cain
Notary Public for Oregon.

CERTIFICATE OF SURVEYOR.

I, Frank Cain, being first duly sworn, depose and say that I have surveyed and marked with proper monuments the lands shown on the annexed plat, of which the following is a true description: Beginning at the Initial Point, a 2"x36" galvanized iron pipe, set 6" below the surface of the ground, 1264.3 feet N. 88°45' W. and 3.2 feet S. 1°15' W. from the N.E. corner of the Warren R. Foster D.L.C. No. 45, T. 28 S., R. 6 W., W.M.: Thence N. 17°03' E. 644.3 ft.; N. 88°45' W. 568.6 ft.; S. 1°15' W. 295.9 ft.; N. 88°45' W. 280.9 ft.; S. 1°15' W. 650.9 ft.; S. 88°45' E. 340.9 ft.; N. 1°15' E. 295.9 ft.; S. 88°45' E. 324.6 ft.; N. 17°03' E. 31.2 ft. to point of beginning.

Frank Cain.
SURVEYOR.

Subscribed and sworn to before me this 28th day of January, 1913.

E. K. Lenox
COUNTY CLERK.
By Blanche Reed Deputy

APPROVED Jan 22, 1913
Frank Cain
COUNTY SURVEYOR.

APPROVED Jan 28 1913
Frank L. Calkins
COUNTY ASSESSOR.

APPROVED January 5th 1913
G. H. Marsott
COUNTY JUDGE.

Filed Jan. 28, 1913
E. K. Lenox
Co. Clerk