


TOWN OF MELROSE

Douglas County, Oregon.

Located in Section I, T.27 S., R.7 W., W.M.

INITIAL POINT
2" x 36" Galv. Pipe
N.W. Cor. of D.L.C. No. 42.

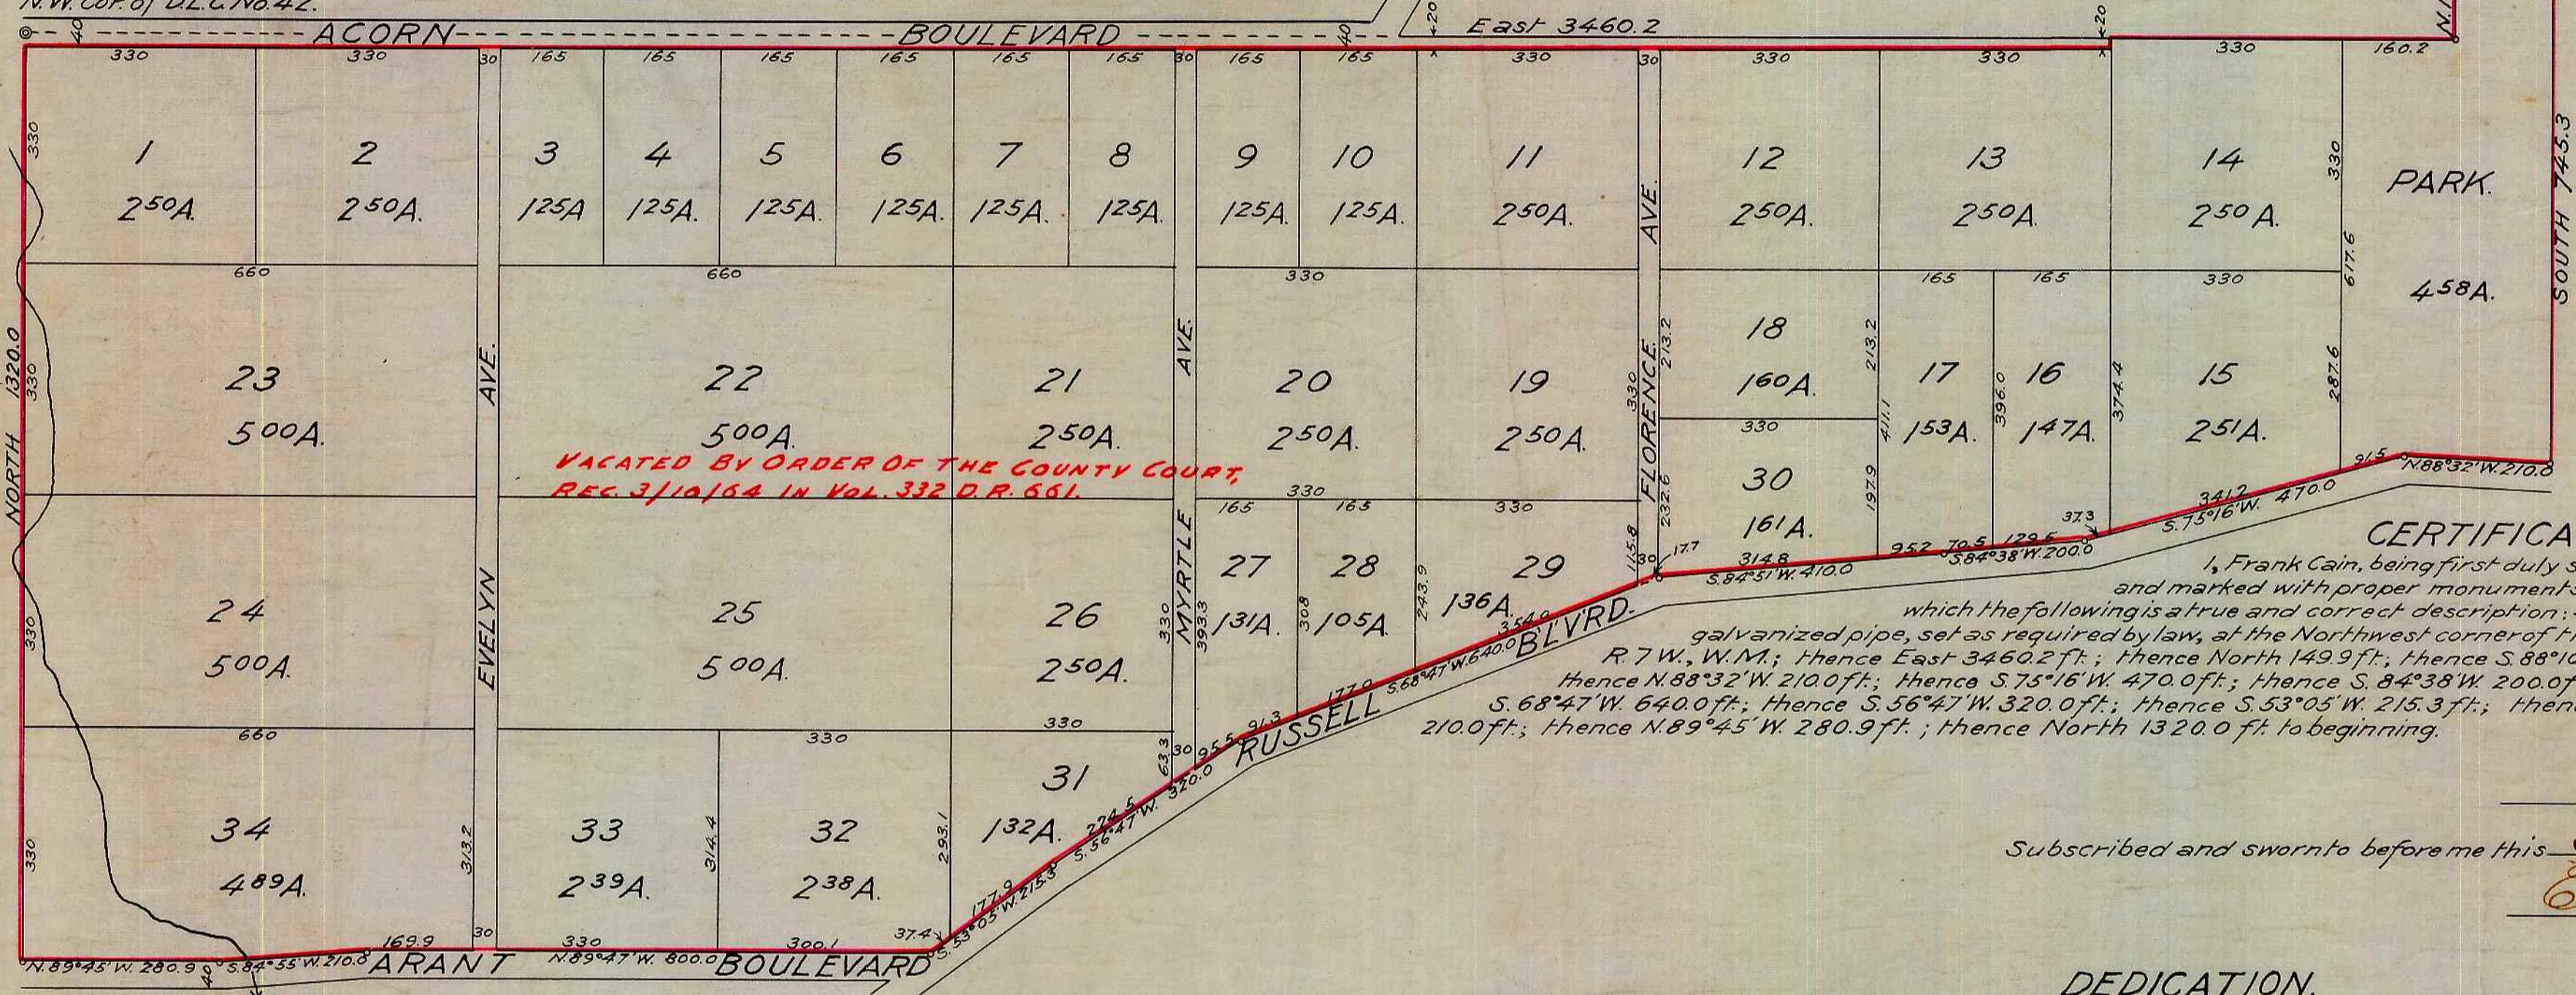

Scale, 200 Feet to One Inch

CERTIFICATE OF SURVEYOR.

I, Frank Cain, being first duly sworn, depose and say that I have surveyed and marked with proper monuments the lands shown on the annexed plat, of which the following is a true and correct description: - Beginning at the Initial Point, a 2" x 36" galvanized pipe, set as required by law, at the Northwest corner of the Edwin M. Moore D. L. C. No. 42 in T. 27 S., R. 7 W., W. M.; thence East 3460.2 ft.; thence North 149.9 ft.; thence S 88° 10' E. 138.3 ft.; thence South 745.3 ft.; thence N 88° 32' W. 210.0 ft.; thence S 75° 16' W. 470.0 ft.; thence S 84° 38' W. 200.0 ft.; thence S 84° 51' W. 410.0 ft.; thence S 68° 47' W. 640.0 ft.; thence S 56° 47' W. 320.0 ft.; thence S 53° 05' W. 215.3 ft.; thence N 89° 47' W. 800.0 ft.; thence N 89° 45' W. 280.9 ft.; thence North 1320.0 ft. to beginning.

Subscribed and sworn to before me this 30th day of August 1913.

 COUNTY CLERK.

DEDICATION.

KNOW ALL MEN BY THESE PRESENTS that the Southern Oregon Orchards Company, a corporation duly incorporated and existing under and by virtue of the laws of the State of Oregon, owners of the real property represented and described in the annexed plat and located in Section I, T. 27 S., R. 7 W., W. M. in Douglas County, Oregon, have caused the same to be surveyed and platted and does hereby plat and establish said real property as and by the name of the TOWN OF MELROSE; and the said Southern Oregon Orchards Company does hereby dedicate to the public use forever the roads shown on said plat.

IN WITNESS WHEREOF the Southern Oregon Orchards Company has caused this instrument to be signed by its President and Secretary and has affixed its Corporate seal hereto.
 Witness: George K. Shaw,
Waldemar Seton
 Southern Oregon Orchards Company,
 By J. F. Johnson, President,
 By C. J. Foleen, Secretary.

State of Oregon }
 County of Multnomah } s.s.
 On this 15th day of September, 1913, before me appeared J. F. Johnson, to me personally known, who being duly sworn, did say that he is President of the Southern Oregon Orchards Company, and C. J. Foleen, to me personally known, who being duly sworn, did say that he is Secretary of said Company, and that they signed the above instrument; that the seal attached thereto is the corporate seal of said Company; and they acknowledged said instrument to be the free act and deed of said Company.
 IN TESTIMONY WHEREOF, I have hereunto set my hand and affixed my official seal the day and year last above written.

Approved Aug 30 1913

 County Surveyor.

Approved 8/30/13

 County Assessor.

Filed Nov. 7th 1913
E. Henry Colburn

Approved Nov 7, 1913

 County Judge.

Waldemar Seton
 Notary Public.