5-37

PLAT SHOWING LAND BOUNDARIES IN SECTION 10-T.29S.-R.6W.-W.M.

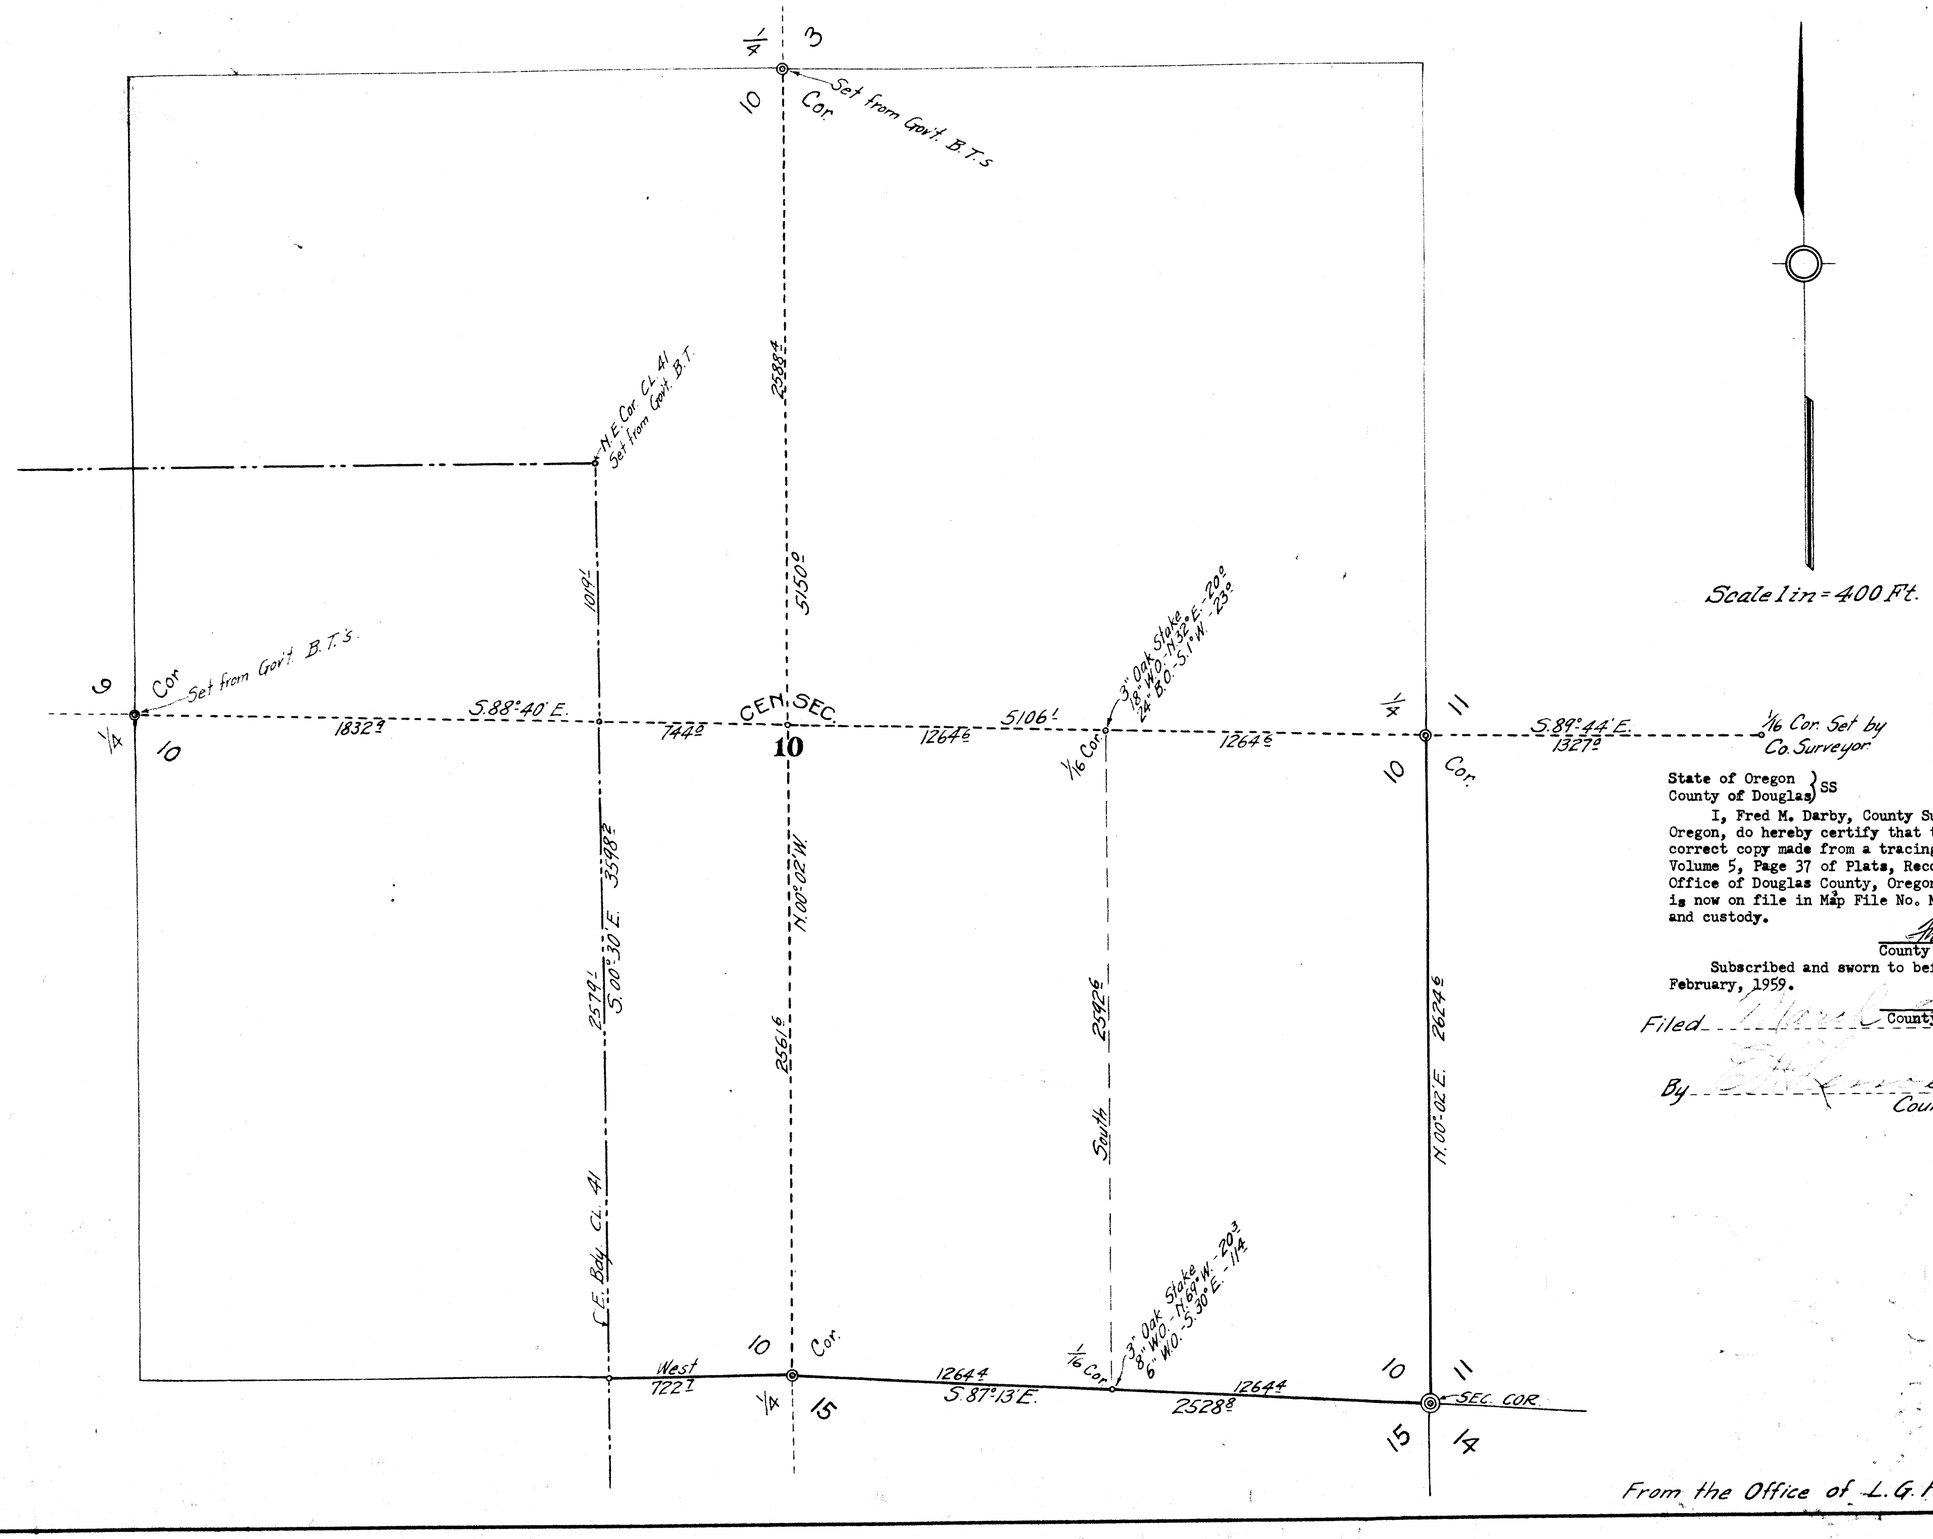

Scale 1 in = 400 Ft.

State of Oregon }
County of Douglas } SS

I, Fred M. Darby, County Surveyor of Douglas County Oregon, do hereby certify that this print is a true and correct copy made from a tracing which was on file in Volume 5, Page 37 of Plats, Records of County Clerk's Office of Douglas County, Oregon, and that said tracing is now on file in Map File No. M 13 - 76 in my office and custody.

Fred M. Darby
County Surveyor

Subscribed and sworn to before me this 4th day of February, 1959.

Filed Chas. Dorner
County Clerk 1918.

By
County Clerk.

From the Office of L. G. Hicks 3-23-'18.

M 13-76

VOL 5 PAGE 37

VOL 5 PAGE 37
M 13-76