


VACATION MAP OF RAILROAD ADDITION TO REEDSPORT, DOUGLAS COUNTY, OREGON.

Scale-300 ft.=1 inch.

E.L. Robinson, C.E.

1918.

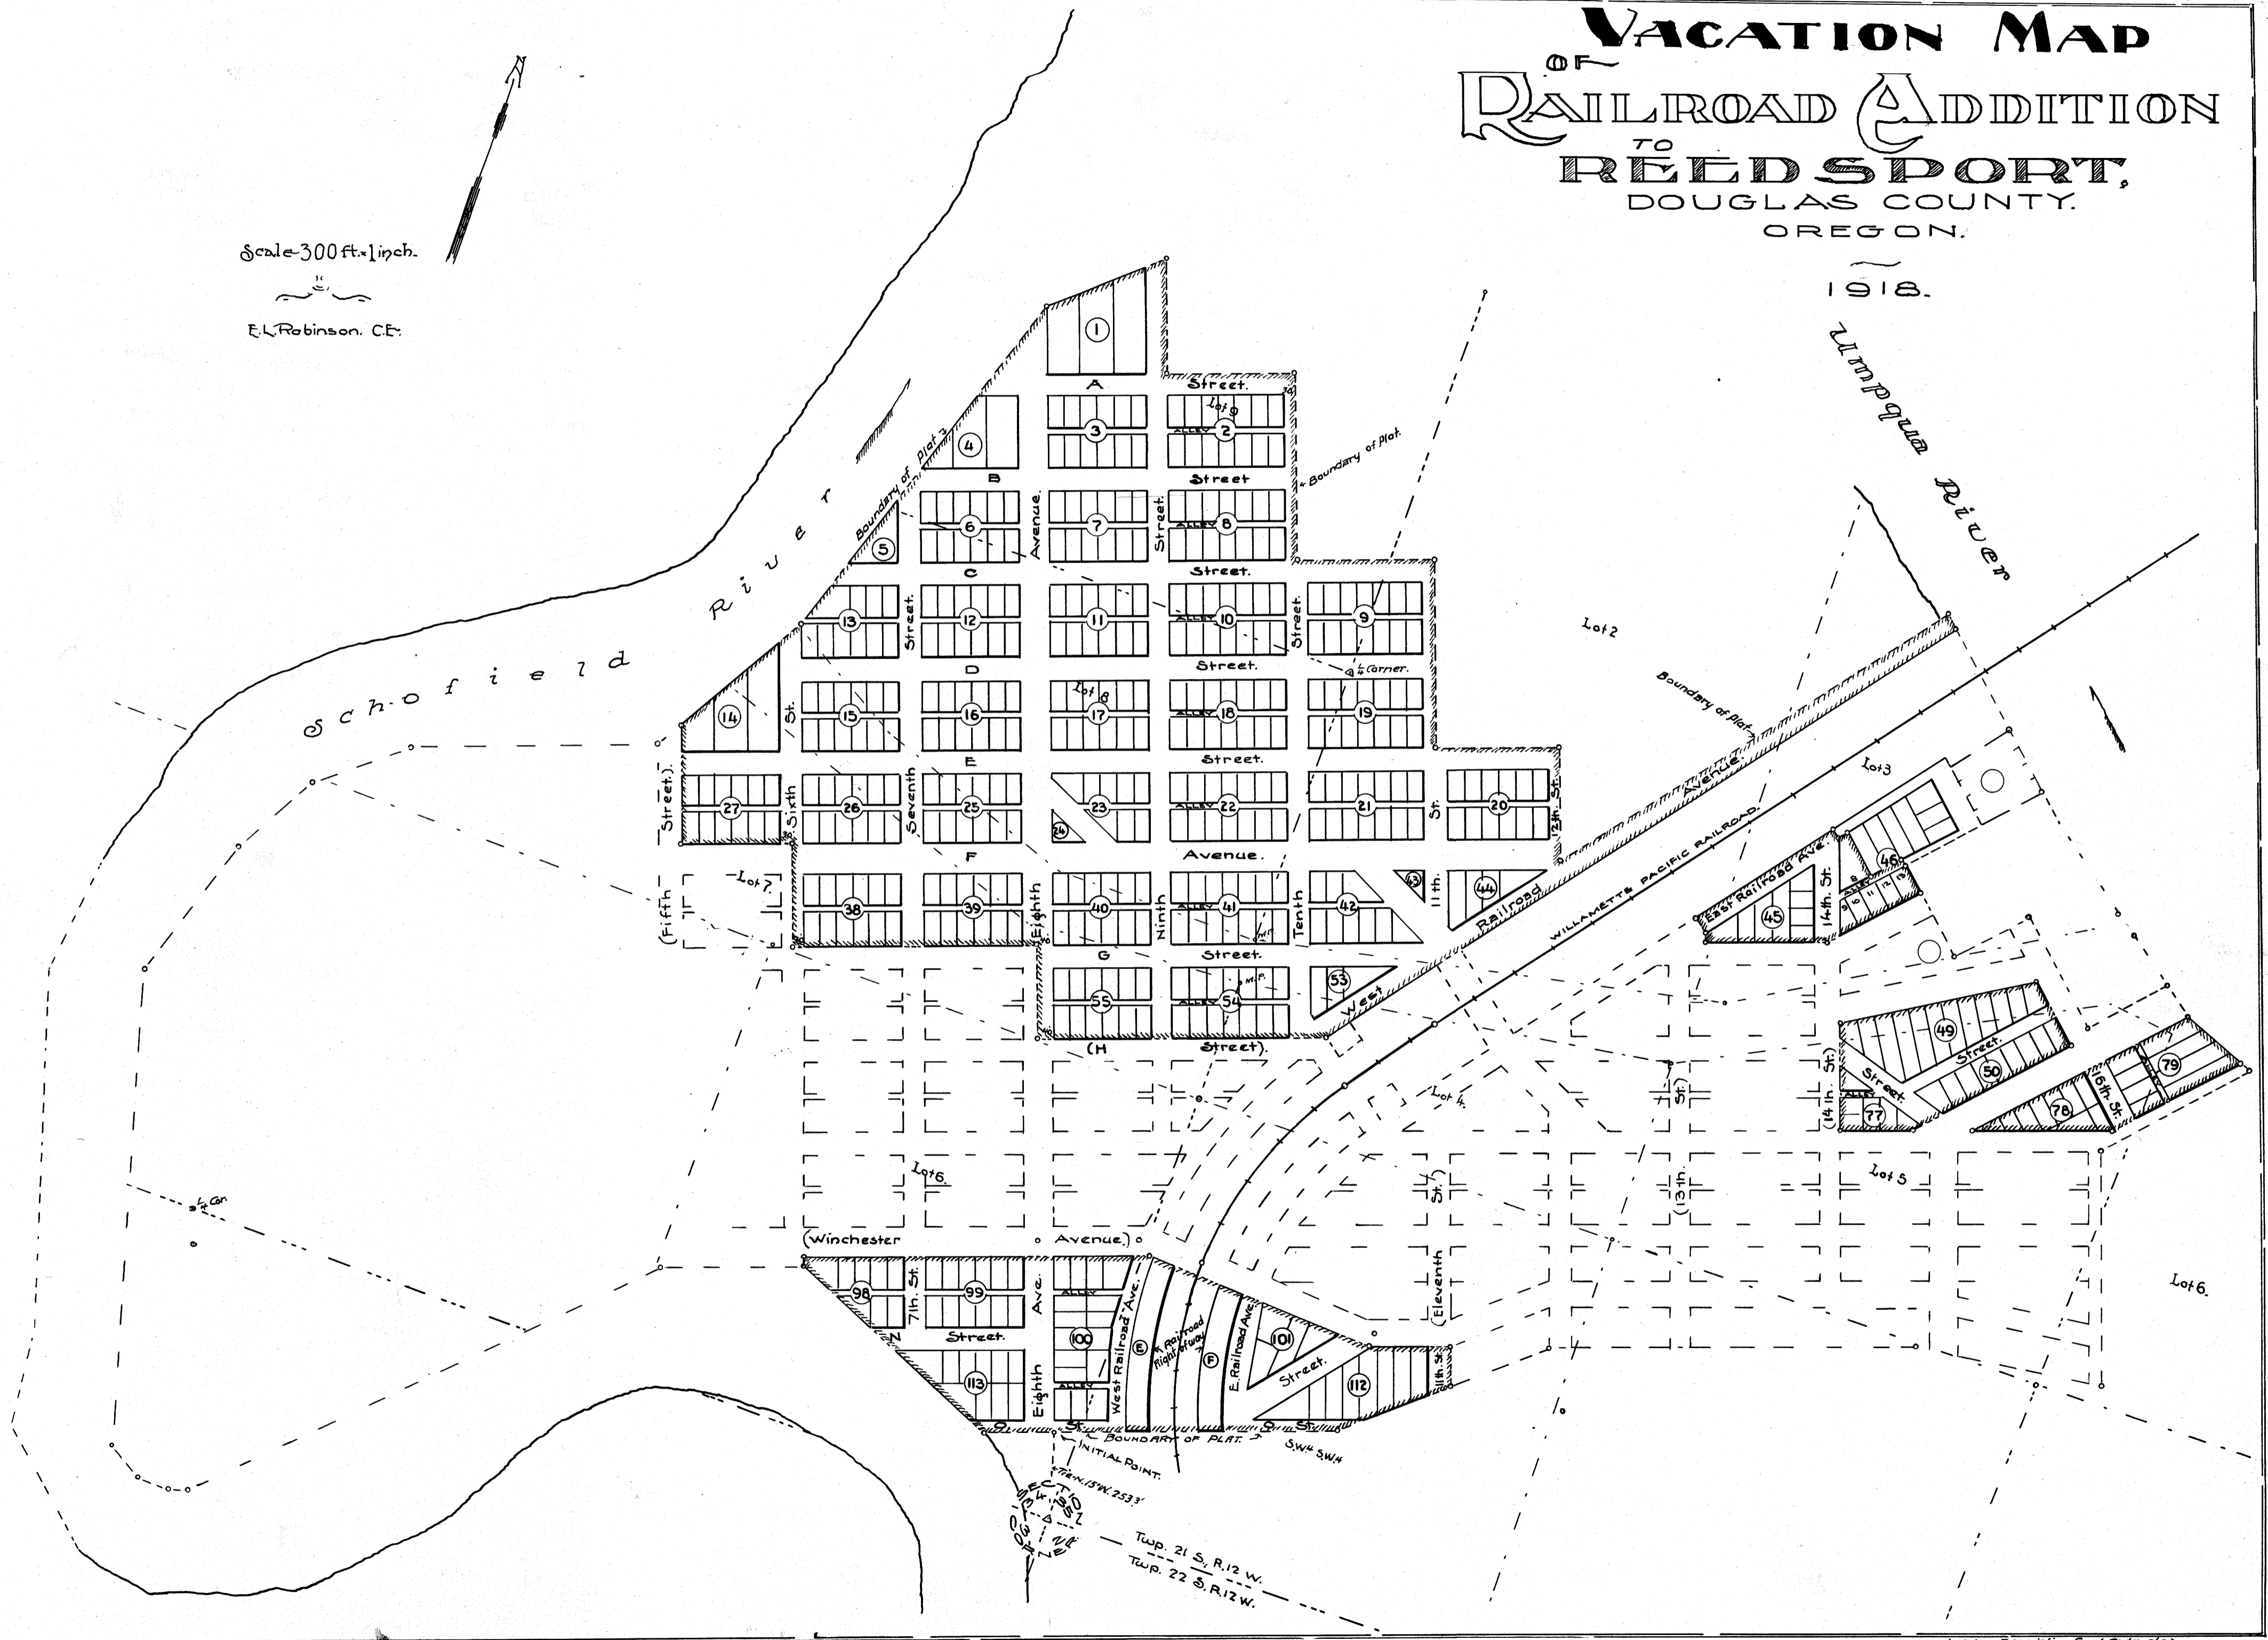

(Note - Description, Cont. Order etc. on opposite side of sheet.)