NORTH UMPQUA HOMES

SECTION 11 T26S R3W
DOUGLAS COUNTY OREGON

DEDICATION:-

KNOW ALL MEN BY THESE PRESENTS that M.L. KIMMEL owner of the real property represented and described on the annexed map located in the NW 1/4 of SECTION 11, T.26S, R.3W, WM., does by these presents, plat and establish said plat of real property as and by the name of "NORTH UMPQUA HOMES" and does hereby declare the annexed map a true and correct plat, and the lots, parcels, and streets designated thereon are correct and conform to his wish, and that the streets and roads, as shown and designated are forever dedicated to the use of the Public.

IN WITNESS WHEREOF he has signed this instrument and affixed his seal hereto.

M. L. Kimmel (SEAL.)

ACKNOWLEDGEMENT:-

STATE OF OREGON, } SS.
COUNTY OF DOUGLAS.

On this 20 day of March 1933 before me, a Notary Public for Oregon, personally, appeared M.L. KIMMEL, known to me to be the identical person named in, and who executed the foregoing dedication and acknowledged to me, that he executed the same freely and voluntarily for the purposes herein named.

WITNESS my hand and official seal the day and year last above written.

B. L. Eddy

My commission expires August 17. 1935 Notary Public.

SURVEYORS CERTIFICATE:-

STATE OF OREGON, } SS.
COUNTY OF DOUGLAS.

I, BEN. B. IRVING, do hereby certify, that I have surveyed and marked with proper monuments the land shown on the annexed map, of which the following is a true and correct description to wit:- BEGINNING at the initial point which is a rock on the North boundary of Section 11 T.26S, R.3W WM, from which the section corner 2-3-10 & 11 bears S87°58'W, 310 ft.; Thence N87°58'E 1696 ft. along the North line of said section 11; Thence S0°50'E 1978.4 ft.; Thence S89°10'W 160 ft.; Thence S0°50'E 383 ft.; Thence S56°14'E 69.3 ft.; Thence S25°50'E 243.6 ft.; Thence S0°50'E 78.3 ft. to the South boundary of the NW 1/4 of Sec. 11; Thence N89°58'W 1512.2 ft. along the South boundary of the NW 1/4 of Sec. 11; Thence N2°33'W 452.3 ft.; Thence S87°37'W 100 ft.; Thence N2°33'W 2187 ft. to the place of beginning.

Ben B. Irving
Registered Professional Engineer.

Subscribed and sworn to before me this 23rd day of March 1933.

Roy Agee
County Clerk

APPROVED.

March 24 1933 N. S. Hamilton COUNTY JUDGE.

MARCH 23, 1933 Barton Hellwell COUNTY ASSESSOR.

Mar. 23rd 1933 H. L. Eppstein COUNTY SURVEYOR.

FILED. March 24 1933.

Roy Agee
COUNTY CLERK

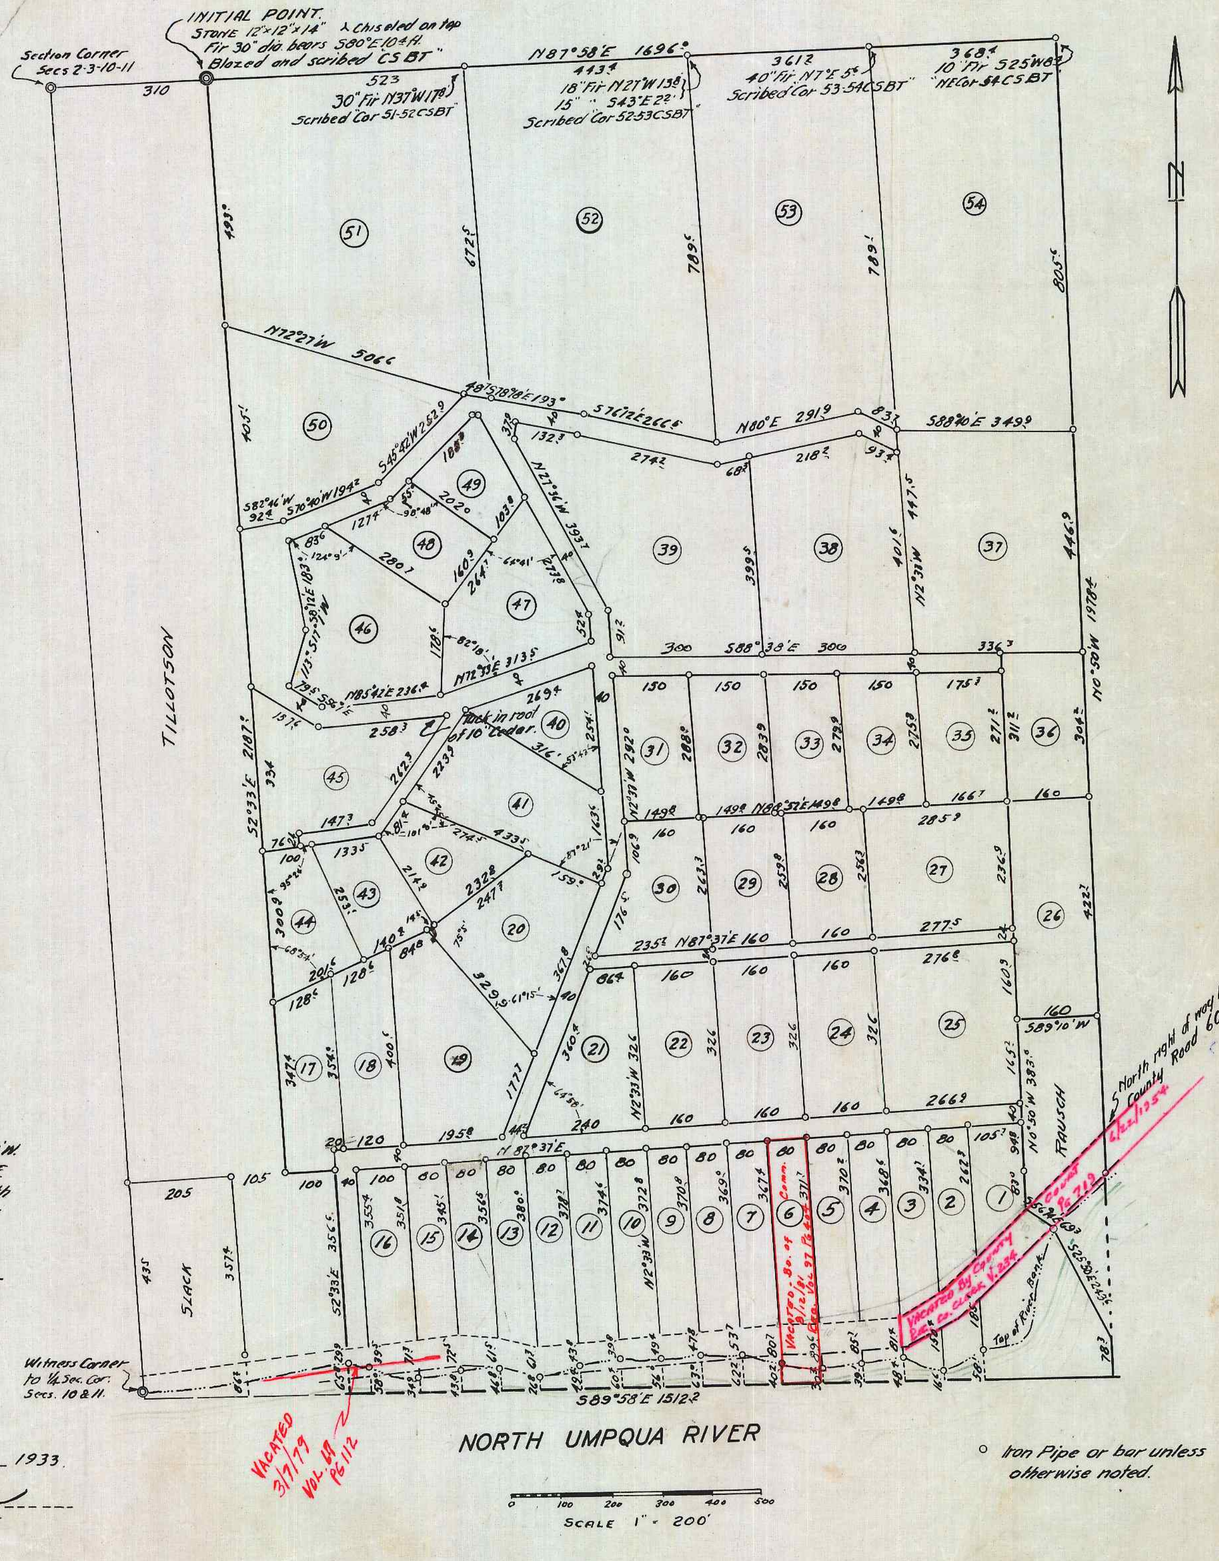

VOL 5 PAGE 67

VOL 5 PAGE 67